


LATITUDE 39° 10'

LONGITUDE 81° 05'

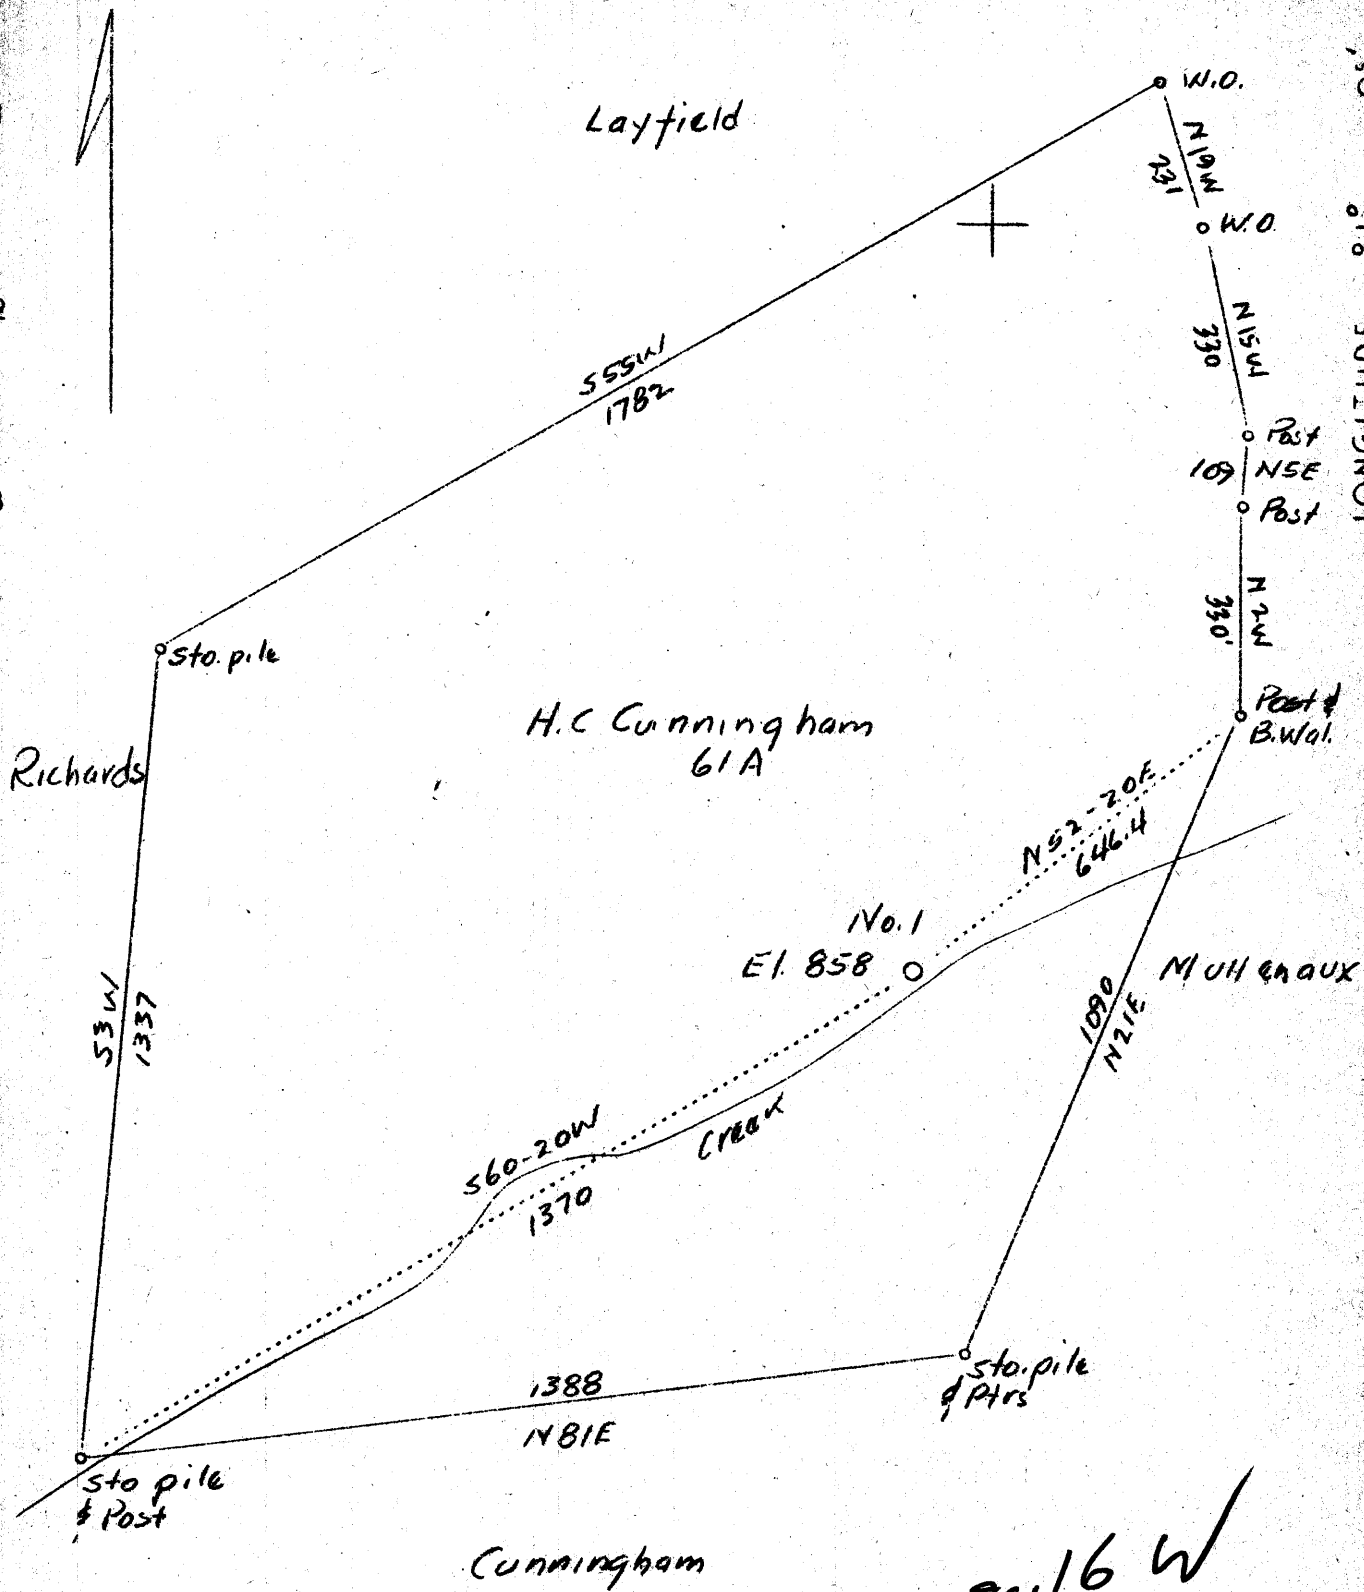

2.16 W
1.68 Q

Abd.

OCT 22 1939

Company	Bowser Oil & Gas Co.
Address	Parkersburg, W. Va.
Farm	H. C. Cunningham
Acres	61
Well (Farm) No.	1
Elevation (SL)	858
Quadrangle	Harrisville
County	Ritchie
District	Grant
Engineer	B. F. Rinehart
Eng. Reg. No.	648
Drawing No.	217-G-R
Date	Oct. 11, 1939
Scale	1" = 300'



STATE OF WEST VIRGINIA
Department of Mines
OIL & GAS DIVISION
Charleston

WELL LOCATION MAP

File No. RIT-426A

x Denotes location of well on U. S. Topographic Maps, scale 1 to 62,500, latitude and longitude lines being represented by border lines as shown.

- Denotes one inch spaces on border lines of original tracing.

STATE OF WEST VIRGINIA
DEPARTMENT OF MINES
OIL AND GAS DIVISION

461

WELL RECORD

HP
426-A

Permit No. _____ Oil or Gas Well (Kind) **011**

Company **Bowser Gas & Oil Co.**
Address **300 Union Trust Bldg, Parkersburg**
Farm **H.C. Cunningham** Acres **61**
Location (waters) **Devil Hole Creek**
Well No. **1** Elev. **850**
District **Grant** County **Ritchie**
The surface of tract is owned in fee by **H.C. Cunningham**
Cartwell, W. Va. Address _____
Mineral rights are owned by **sand**
Address _____
Drilling commenced **Oct. 28, 1939**
Drilling completed **Dec. 4, 1939**
Date shot **Dec. 5, 1939** Depth of shot **1838-42**
Open Flow /10ths Water in _____ Inch
not measured because small Inch
Volume _____ Cu. Ft.
Rock Pressure _____ lbs. _____ hrs.
Oil **not known** bbls., 1st 24 hrs.
Fresh water **none** feet _____ feet
Salt water **none** feet _____ feet

Casing and Tubing	Used in Drilling	Left in Well	Packers
Size			
16			Kind of Packer
13			steel shoe
10			Size of
8 1/4	490	none	Depth set 1535
6 5/8	905	none	
5 3/16	1335	1335	
3			Perf. top
2	1912	1912	Perf. bottom
Liners Used			Perf. top
			Perf. bottom

CASING CEMENTED _____ SIZE _____ No. Ft. _____ Date _____
COAL WAS ENCOUNTERED AT _____ FEET _____ INCHES
FEET _____ INCHES FEET _____ INCHES
FEET _____ INCHES FEET _____ INCHES

Formation	Color	Hard or Soft	Top	Bottom	Oil, Gas or Water	Depth Found	Remarks
Sand			430	490			
Big Red			710	800			
Lime			960	975			
Slate			1015	1130			
Sand			1130	1145			
Slate and shells			1245	1310			
Sand			1310	1360			
Slate and shells			1360	1430			
Sand			1430	1485			
Slate and shells			1625	1665			
Sand			1665	1675			
Slate			1675	1690			
Maxon sand			1690	1740			
Little Lime			1740	1760			
Big Lime			1760	1825			
Keener Sand			1825	1855			
Big Injun Sand			1855	1892			
total depth				1912			

OIL 1835-
1841 Gas 1838