


Latitude 38 10

Longitude 80 50

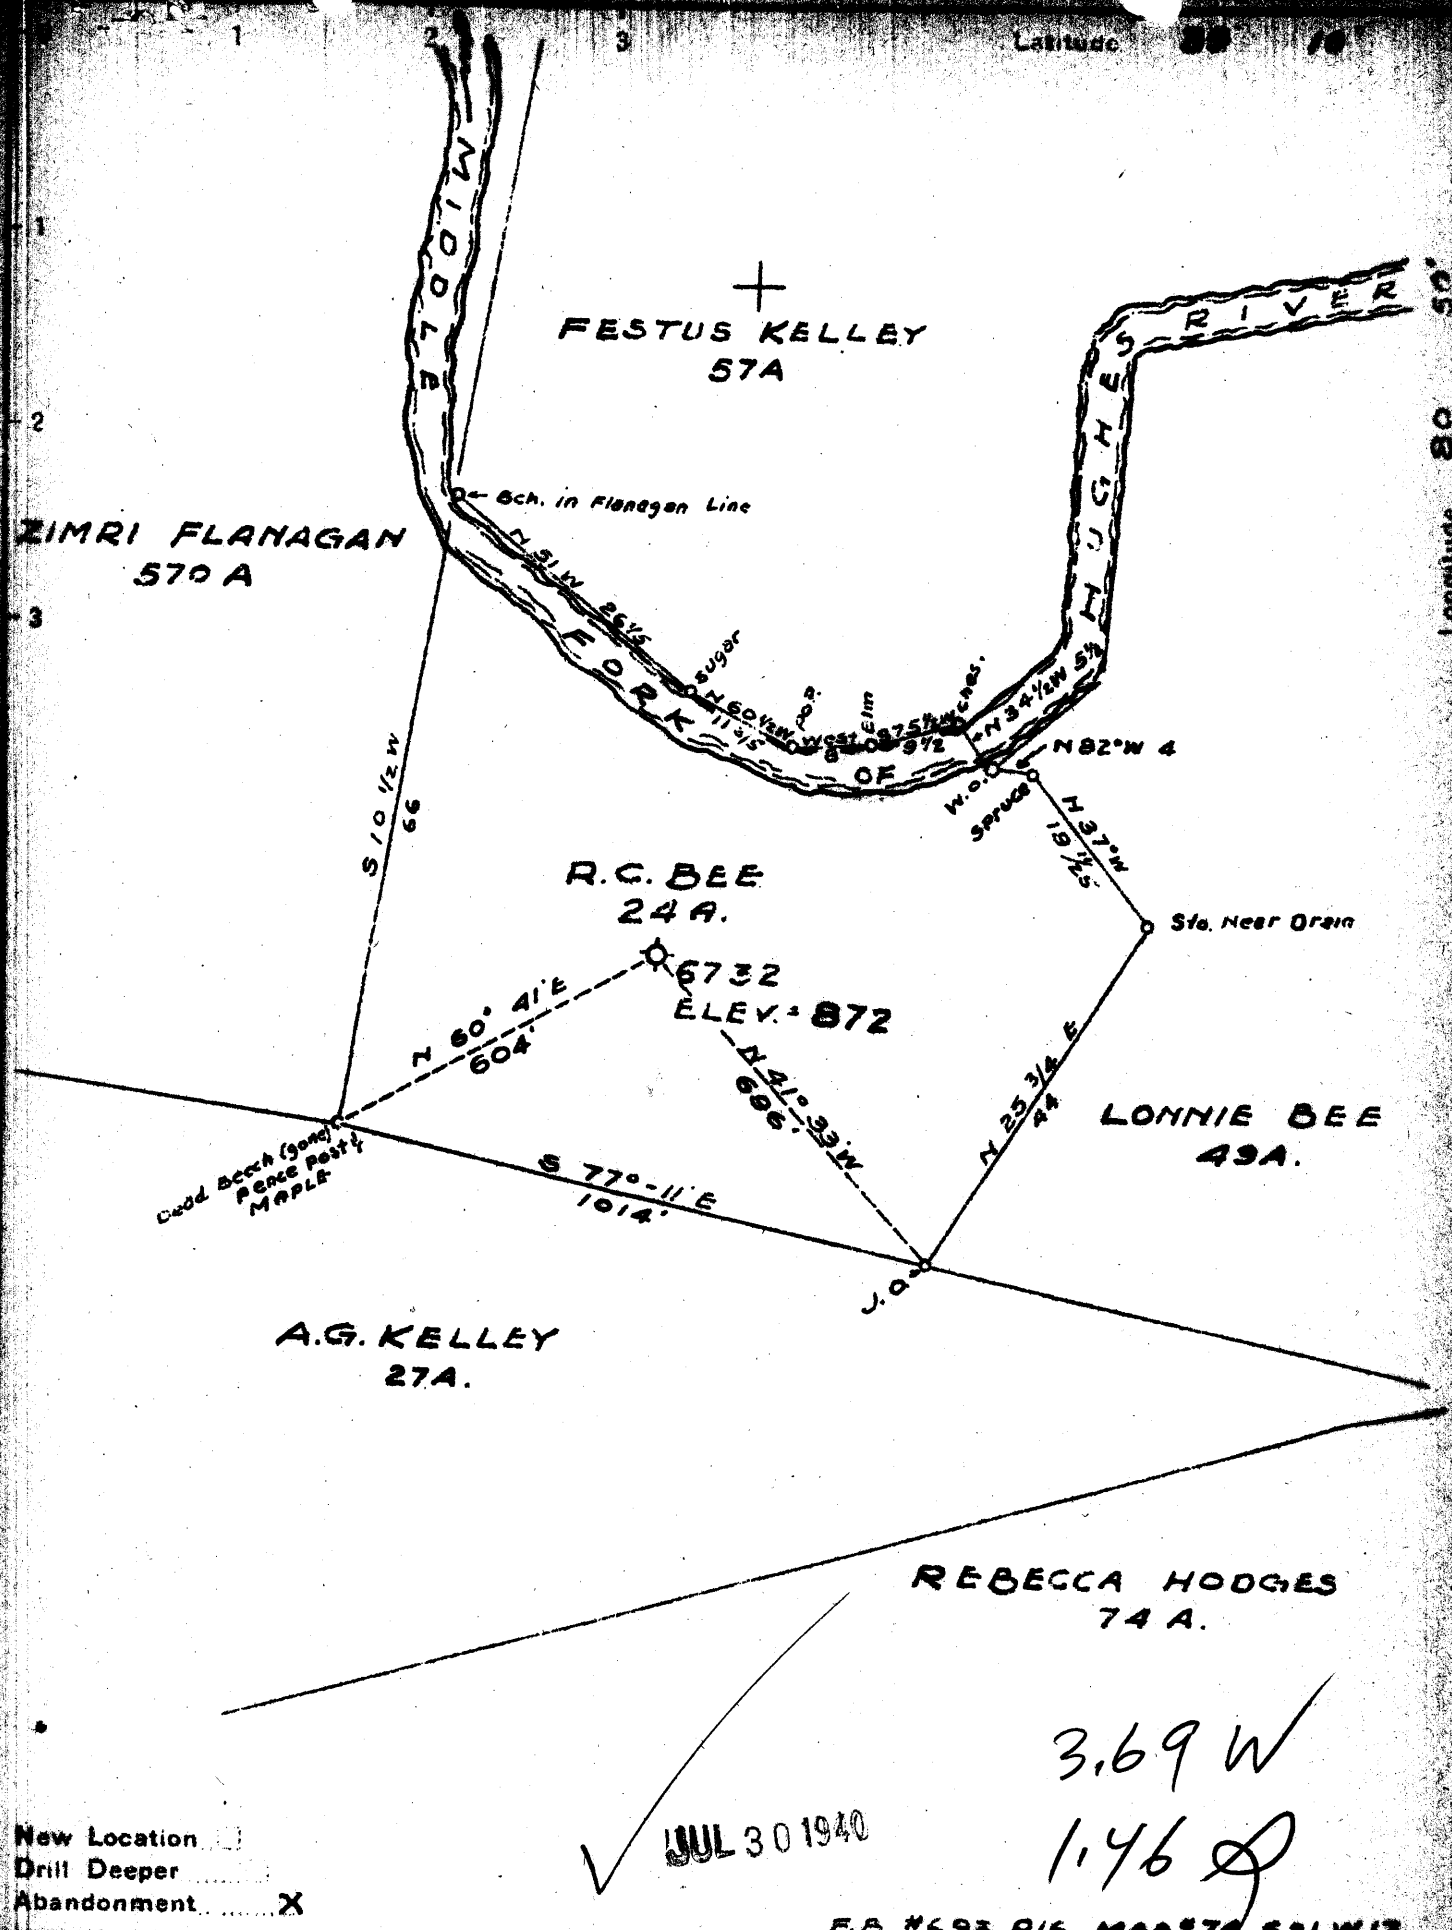

New Location
 Drill Deeper
 Abandonment

✓ JUL 30 1940

3.69 W
 1.46 Q

F.B. #693 P16 MAP #74 S21 W17

Company HOPE NATURAL GAS Co.
 Address CLARKSBURG, W. VA.
 Farm R.C. BEE
 Tract 1 Acres 25 Lease No. 29901
 Well (Farm) No. 1 Serial No. 6732
 Elevation (Spirit Level) 872
 Quadrangle HOLBROOK
 County RITCHIE District UNION
 Engineer Tim Bevers
 Engineer's Registration No. 900
 File No. _____ Drawing No. _____

STATE OF WEST VIRGINIA
 DEPARTMENT OF MINES
 OIL AND GAS DIVISION
 CHARLESTON

WELL LOCATION MAP
 FILE NO. RIT-461A

+ Denotes location of well on United States Topographic Maps, scale 1 to 62,500, latitude and longitude lines being represented by border lines as shown.
 - Denotes one inch spaces on border line of original tracing.

JUL 15 1940

STATE OF WEST VIRGINIA
DEPARTMENT OF MINES
OIL AND GAS DIVISION

493

WELL RECORD

Ab
Permit No. 461-A

Oil or Gas Well Gas
(KIND)

Company Hope Natural Gas Company
 Address Clarksburg, W. Va.
 Farm R. C. Bee Acres 2.5
 Location (waters) ①
 Well No. 6732 Elev. 872
 District Union County Ritchie
 The surface of tract is owned in fee by _____
 Address _____
 Mineral rights are owned by _____
 Address _____
 Drilling commenced 11-5-1925
 Drilling completed 12-2-1925
 Date shot Not shot Depth of shot _____
 Open Flow /10ths Water in _____ Inch
 /10ths Merc. in _____ Inch
 Volume _____ Cu. Ft.
 Rock Pressure _____ lbs. _____ hrs.
 Oil _____ bbls., 1st 24 hrs.
 Fresh water 612 - 1060 feet _____ feet
 Salt water None recorded feet _____ feet

Casing and Tubing	Used in Drilling	Left in Well	Packers
Size			
16			Kind of Packer
13			
10	195	195	Size of
8 1/4	976	976	
6 5/8	1793	1793	Depth set
5 3/16			
3			Perf. top
2			Perf. bottom
Liners Used			Perf. top
			Perf. bottom

CASING CEMENTED _____ SIZE _____ No. Ft. _____ Date _____
Not cemented
 COAL WAS ENCOUNTERED AT _____ FEET _____ INCHES
 _____ FEET No coal INCHES _____ FEET _____ INCHES
 _____ FEET _____ INCHES _____ FEET _____ INCHES

Formation	Color	Hard or Soft	Top	Bottom	Oil, Gas or Water	Depth Found	Remarks
Sand			592	616	Water	612	Fresh
Little Dunkard Sand			770	816			
Big Dunkard Sand			896	955			
Sand			968	1008			
Gas Sand			1040	1112	Water	1060	Fresh
First Salt Sand			1270	1348			
Second Salt Sand			1405	1472			
Maxon Sand			1630	1683			
Little Lime			1726	1756			
Pencil Cave			1756	1764			
Big Lime			1764	1820			
Big Injun Sand			1820	1880	Gas	1837-1847	
Total Depth				1926			

