

Latitude 39 20

Longitude 81 10


C.W. Adams

#1	5.47 S	3.91 W
#2	5.51 S	3.84 W

Chas. L. Burnham

#3	5.56 S	3.88 W
#9	5.67 S	3.93 W
#5	5.32 S	4.05 W
#6	5.23 S	4.01 W
#8	5.20 S	4.11 W
#4	5.41 S	3.97 W
#7	5.27 S	4.13 W

#6 = 586-A
#9 = 591-A

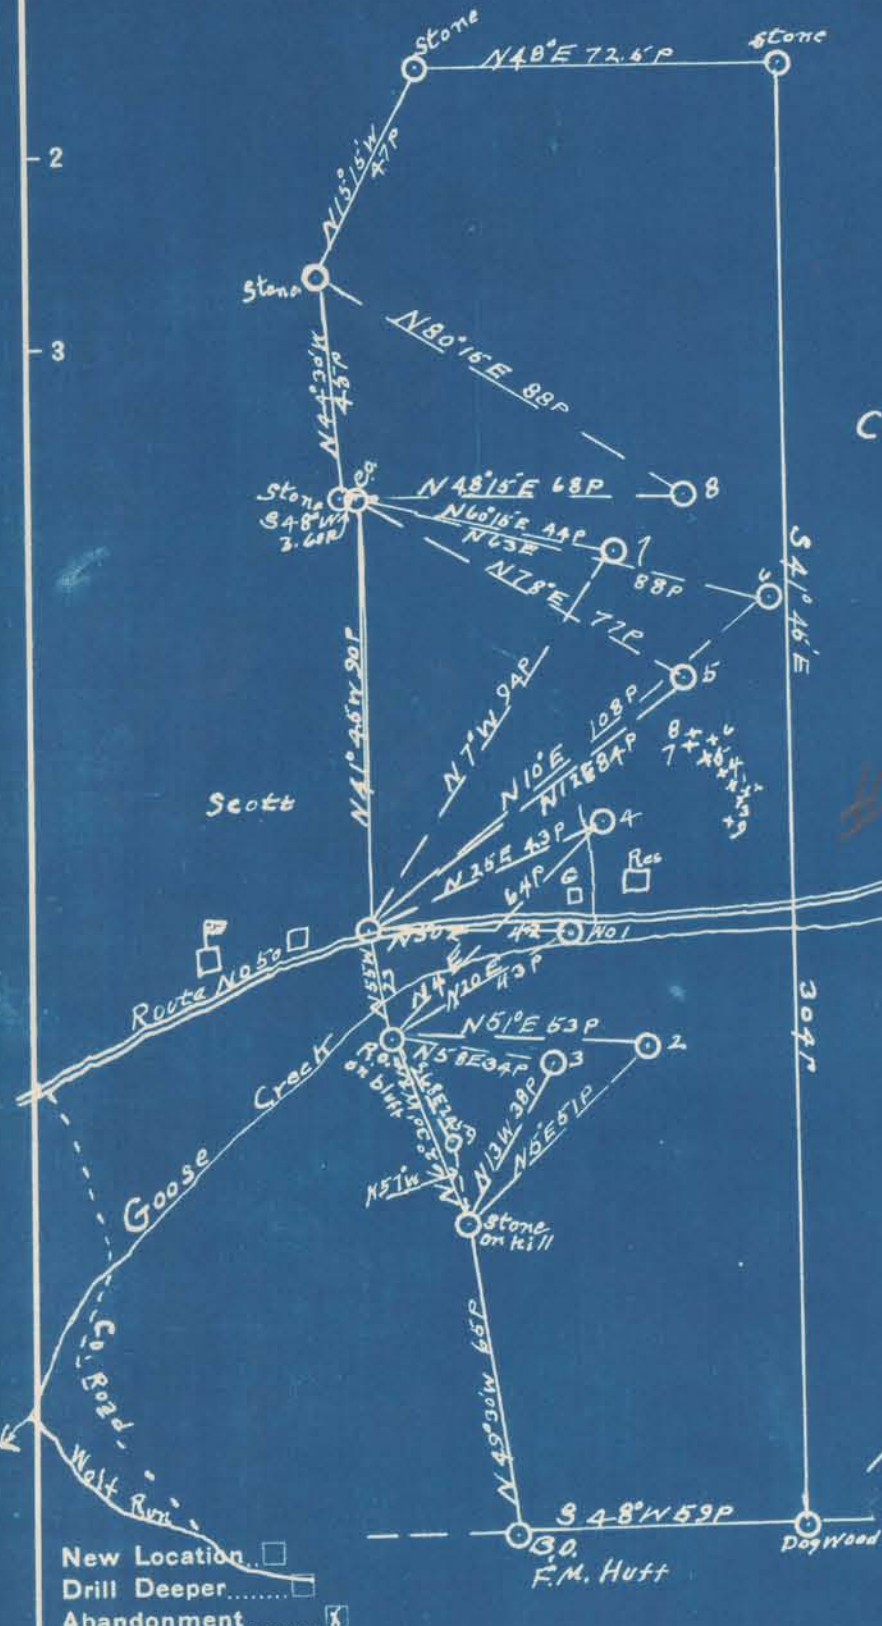


Company Smith, Pierce, Feick & Co
 Address R.D. #2 Walker WVA
 Farm Ella Cantwell
 Tract 1 Acres 130 Lease No. _____
 Well (Farm) No. 1, 2, 3, 4, 5, 6, 7, 8 Serial No. Well No. 9 Elev 860
 Elevation (Spirit Level) 780-860 860 798 860 920 920 966
 Quadrangle St Marys
 County Ritchie District Grant
 Engineer J.E. Anderson, Wood County
 Engineer's Registration No. Surveyor
 File No. _____ Drawing No. _____
 Date May 7, 1941 Scale 1 in = 40 Poles

STATE OF WEST VIRGINIA
 DEPARTMENT OF MINES
 OIL AND GAS DIVISION
 CHARLESTON

WELL LOCATION MAP
 FILE NO. RIT-520A-523A
583-A #5
1-2-3-9

+ Denotes location of well on United States Topographic Maps, scale 1 to 62,500, latitude and longitude lines being represented by border lines as shown.

- Denotes one inch spaces on border line original tracing.

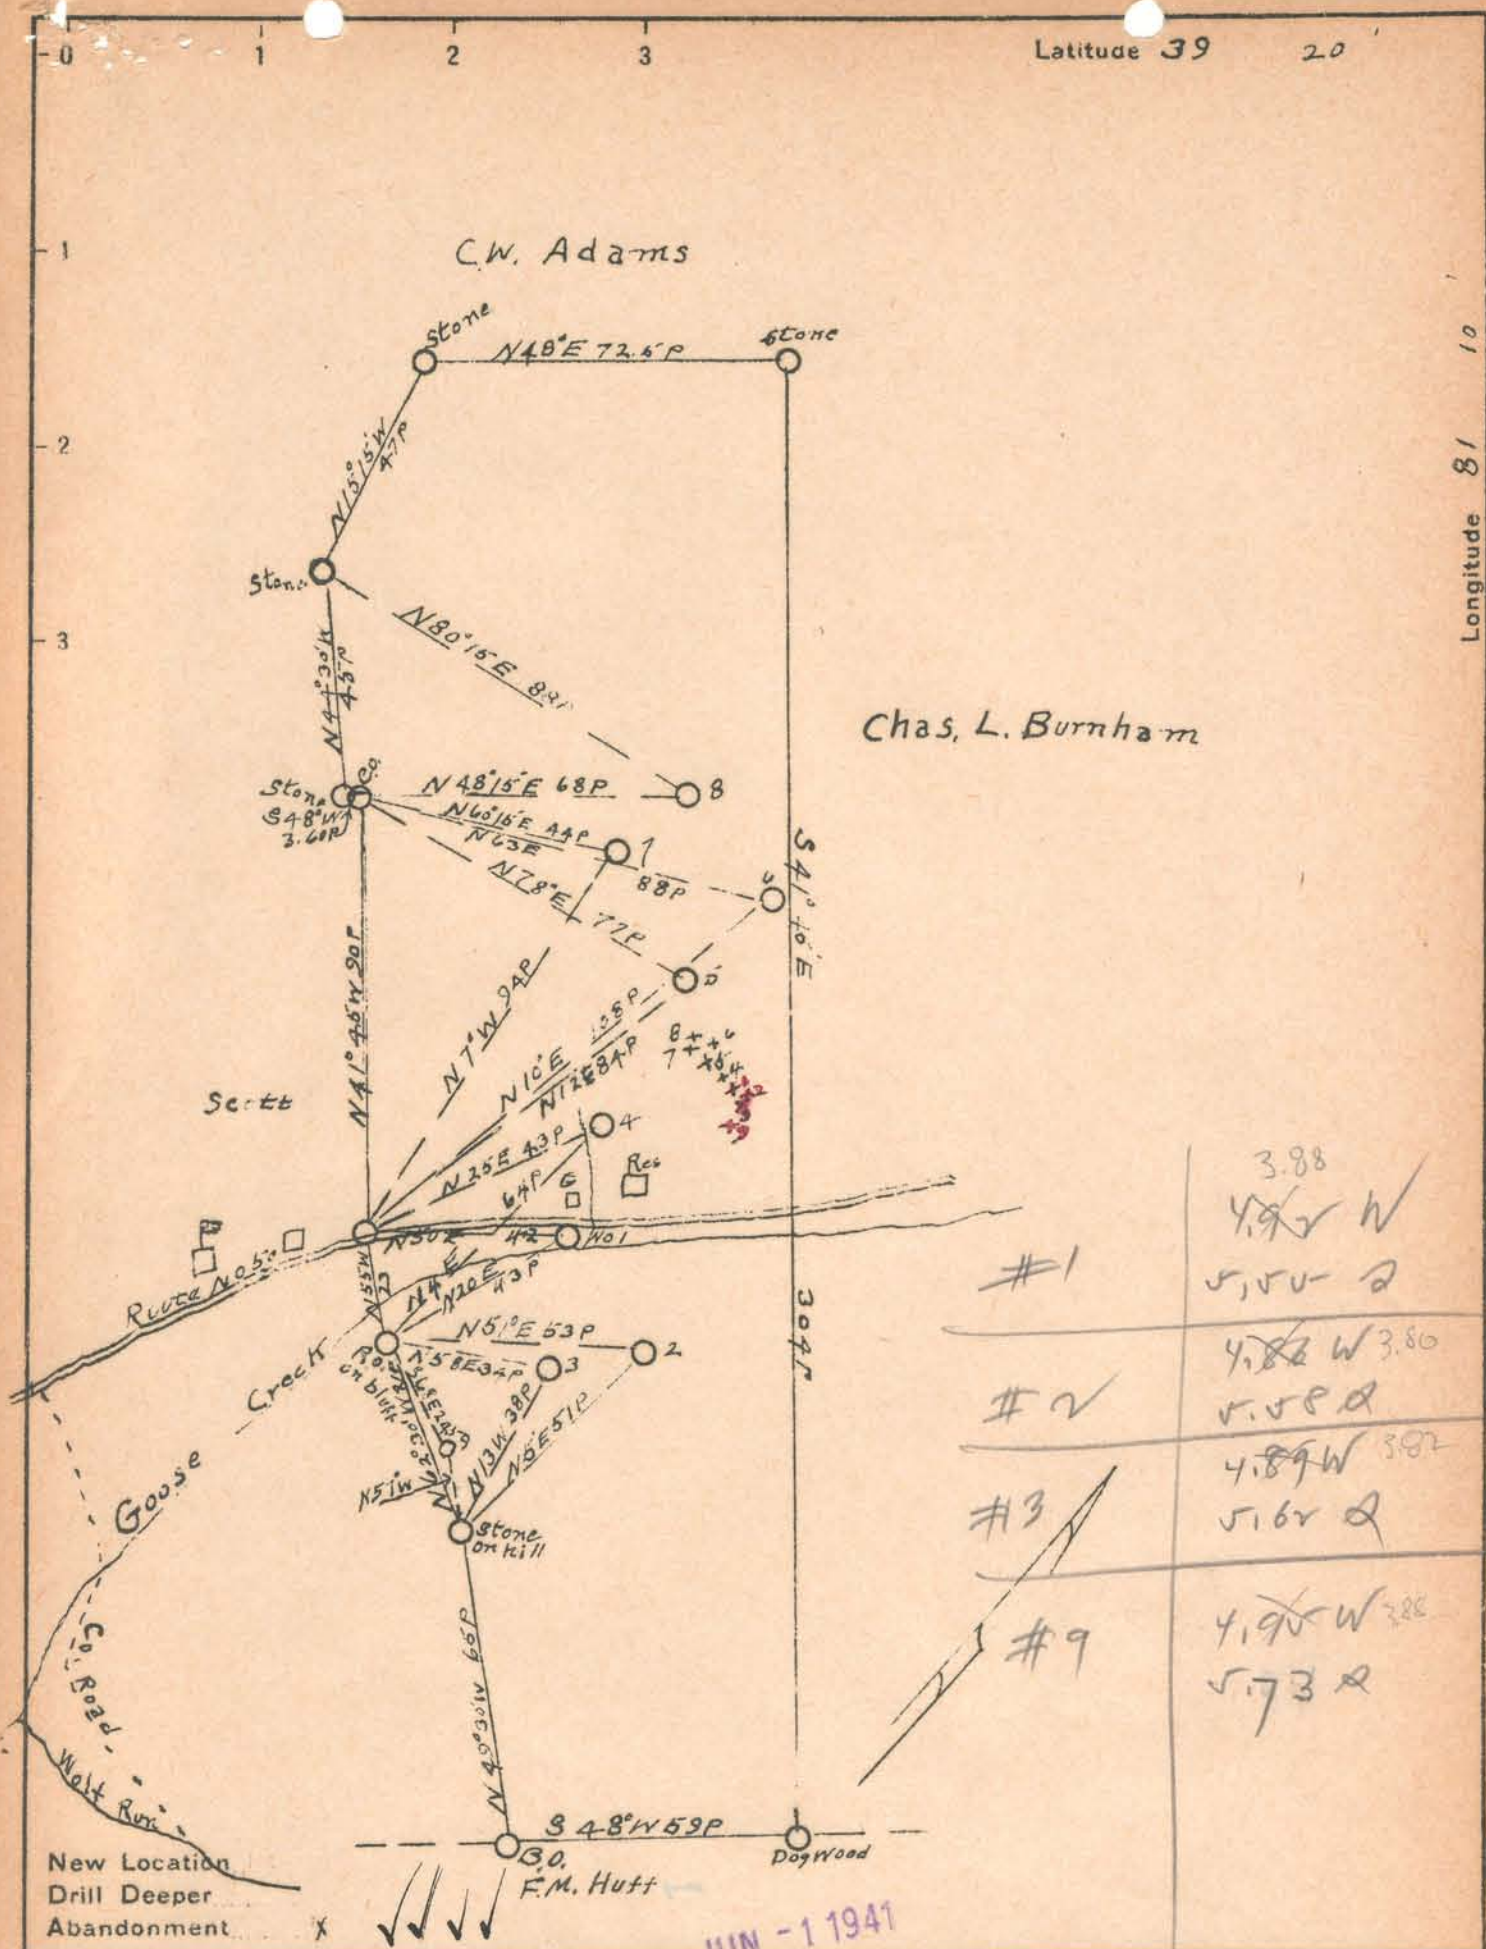

#1	3.88 4.9 W 5.50-2
#2	4.88 W 3.80 5.50-2
#3	4.89 W 3.82 5.62-2
#9	4.90 W 3.88 5.73-2

Company Smith, Piersol, Feick & Coss
 Address R.D. #2 Walker W.Va.
 Farm Ella Cantwell
 Tract 1 Acres 130 Lease No. _____
 Well (Farm) No. 1, 2, 3, 4, 5, 6, 7, 8 Serial No. Well No. 9 Elev 860'
 Elevation (Spirit Level) 780-856 866 796 866 926 926 966
 Quadrangle St Marys
 County Ritchie District Grant
 Engineer J. E. Anderson, Wood County
 Engineer's Registration No. Surveyor
 File No. _____ Drawing No. _____
 Date May 7, 1941 Scale 1 in = 40 Poles

STATE OF WEST VIRGINIA
 DEPARTMENT OF MINES
 OIL AND GAS DIVISION
 CHARLESTON

WELL LOCATION MAP
 FILE NO. RIT-520A-523A
1-2-3-9

+ Denotes location of well on United States Topographic Maps, scale 1 to 62,500, latitude and longitude lines being represented by border lines as shown.
 - Denotes one inch spaces on border line of original tracing.

STATE OF WEST VIRGINIA
DEPARTMENT OF MINES
OIL AND GAS DIVISION

518

AD 520-A
none

WELL RECORD

Permit No. none

Oil or Gas Well (KIND)

Company Smith, Piersol, Feick and Coss
 Address R. D. #2, Walker, W. VA. (% C.R. Piersol)
 Farm Ella Cantwell Acres 130
 Location (waters) Goose Creek
 Well No. 1 Elev. 780'
 District Grant County Ritchie
 The surface of tract is owned in fee by Ella Cantwell
 Address Cairo, R.D. #2
 Mineral rights are owned by same
 Address _____
 Drilling commenced about 1904
 Drilling completed _____
 Date shot _____ Depth of shot _____
 Open Flow /10ths Water in _____ Inch
 /10ths Merc. in _____ Inch
 Volume _____ Cu. Ft.
 Rock Pressure _____ lbs _____ hrs.
 Oil _____ bbls., 1st 24 hrs.
 Fresh water _____ feet _____ feet
 Salt water _____ feet _____ feet

Casing and Tubing	Used in Drilling	Left in Well	Packers
Size			Kind of Packer
16			
13			
10			Size of
8 1/4	1200	1200	Depth set
6 5/8			
5 3/16			Perf. top
3			Perf. bottom
2			Perf. top
Liners Used			Perf. bottom

CASING CEMENTED _____ SIZE _____ No. Ft. _____ Date _____
 COAL WAS ENCOUNTERED AT _____ FEET _____ INCHES
 _____ FEET _____ INCHES _____ FEET _____ INCHES
 _____ FEET _____ INCHES _____ FEET _____ INCHES

Formation	Color	Hard or Soft	Top	Bottom	Oil, Gas or Water	Depth Found	Remarks
Clay & Rock	red		000000	650'			
Cave			650	800'			
Shale			800	1100			
Sand			1100	1163			
Shale & Lime			1163	1300			
Sand			1300	1350			
Shale			1350	1490			
Sand			1490	1530	Bottom of well.		



Formation	Color	Hard or Soft	Top	Bottom	Oil, Gas or Water	Depth Found	Remarks
			1450	1430			
			1480	1460			
			1500	1480			
			1520	1500			
			1550	1530			
			1600	1580			
			1650	1630			
			10000	9980			

250. K

MEET RECORD Date 5 10 1941
 APPROVED Smith Puerto Fuent & Co, Owner
 DEPARTMENT OF MINES
 By E. H. Puerto
 (Title)