


Ella Cantwell

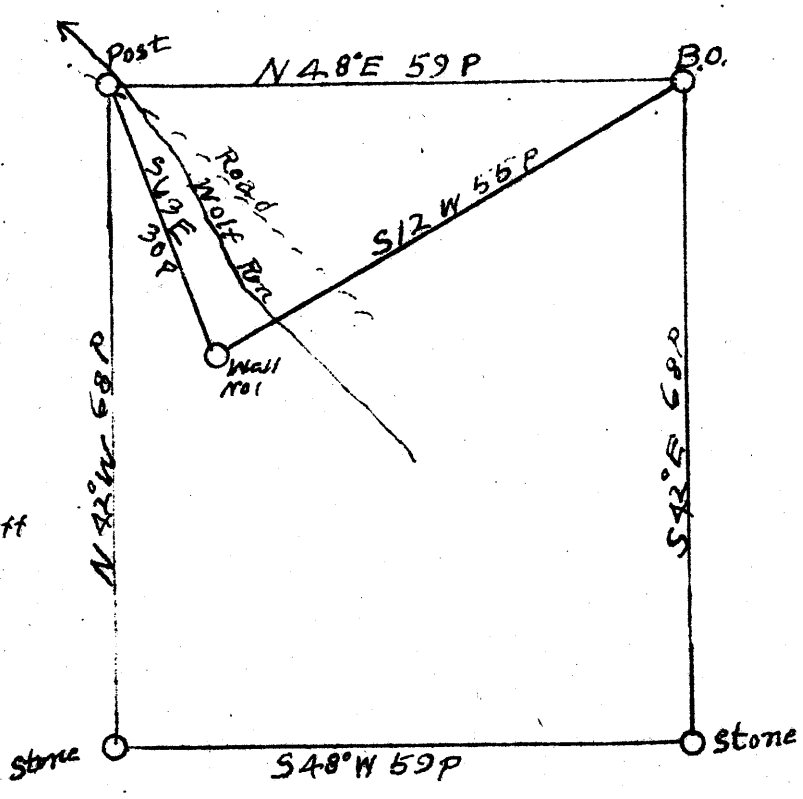

F.M. Hoff

Longitude 81 10

0.2 W
4.28 Q

New Location
 Drill Deeper
 Abandonment

✓ JUN 16 1941

Company Smith, Pierson, Frick & Co.
 Address R.D. #2 Walker W.Va.
 Farm J.B. Hendrickson
 Tract _____ Acres 26 Lease No. _____
 Well (Farm) No. 1 Serial No. _____
 Elevation (Spirit Level) 790
 Quadrangle SE Marys
 County Ritchie District Grant
 Engineer J.E. Anderson, Surveyor
 Engineer's Registration No. Wood Co.
 File No. _____ Drawing No. _____

STATE OF WEST VIRGINIA
 DEPARTMENT OF MINES
 OIL AND GAS DIVISION
 CHARLESTON

WELL LOCATION MAP
 FILE NO. R15 528A

+ Denotes location of well on United States Topographic Maps, scale 1 to 62,500, latitude and longitude lines being represented by border lines as shown.

= Denotes one inch square on border line of original map.

STATE OF WEST VIRGINIA
DEPARTMENT OF MINES
OIL AND GAS DIVISION

528

WELL RECORD

Ab 528-A
none


Permit No. _____ Oil or Gas Well _____
(KIND)

Company **Smith, Piersol, Peick & Coss (A.C.R. Piersol)**
 Address **R. D. #2, Walker, W. VA.**
 Farm **J. B. Hendrickson** Acres **25**
 Location (waters) **Wolf Run**
 Well No. **1** Elev. **800'**
 District **Grant** County **Ritchie**
 The surface of tract is owned in fee by **J. B. Hendrickson**
 Address **R. D. #2, Cairo**
 Mineral rights are owned by **J. B. Hendrickson**
 Address **same**
 Drilling commenced **1903**
 Drilling completed _____
 Date shot _____ Depth of shot _____
 Open Flow /10ths Water in _____ Inch
 /10ths Merc. in _____ Inch
 Volume _____ Cu. Ft.
 Rock Pressure _____ lbs _____ hrs.
 Oil _____ bbls., 1st 24 hrs.
 Fresh water _____ feet _____ feet
 Salt water _____ feet _____ feet

Casing and Tubing	Used in Drilling	Left in Well	Packers
Size			
16.			Kind of Packer
13.			Size of
8 1/4	1200	1200	Depth set
6 5/8			Perf. top
3.			Perf. bottom
2.			Perf. top
Liners Used			Perf. bottom

CASING CEMENTED _____ SIZE _____ No. Ft. _____ Date _____
 COAL WAS ENCOUNTERED AT _____ FEET _____ INCHES
 _____ FEET _____ INCHES _____ FEET _____ INCHES
 _____ FEET _____ INCHES _____ FEET _____ INCHES

Formation	Color	Hard or Soft	Top	Bottom	Oil, Gas or Water	Depth Found	Remarks
Cherty & Cave	Red Rock		000	660'			
Shale			660	775			
Sand			775	1115			
Shale			1115	1140			
Sand			1140	1320			
Shale			1320	1340			
Sand			1340	1480			
Sand			1480	1525	Bottom of well.		

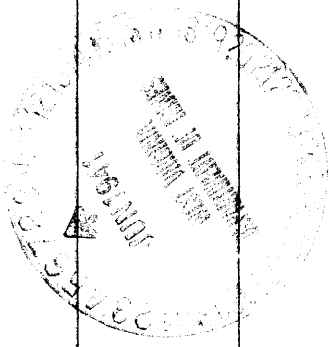

Formation	Color	Hard or Soft	Top	Bottom	Oil, Gas or Water	Depth Found	Remarks

Date: 5 10, 1941

APPROVED: Smith Pierse Ferch & Co., Owner

By: G. R. Pierse (Title)