


*J. 005
0.78*

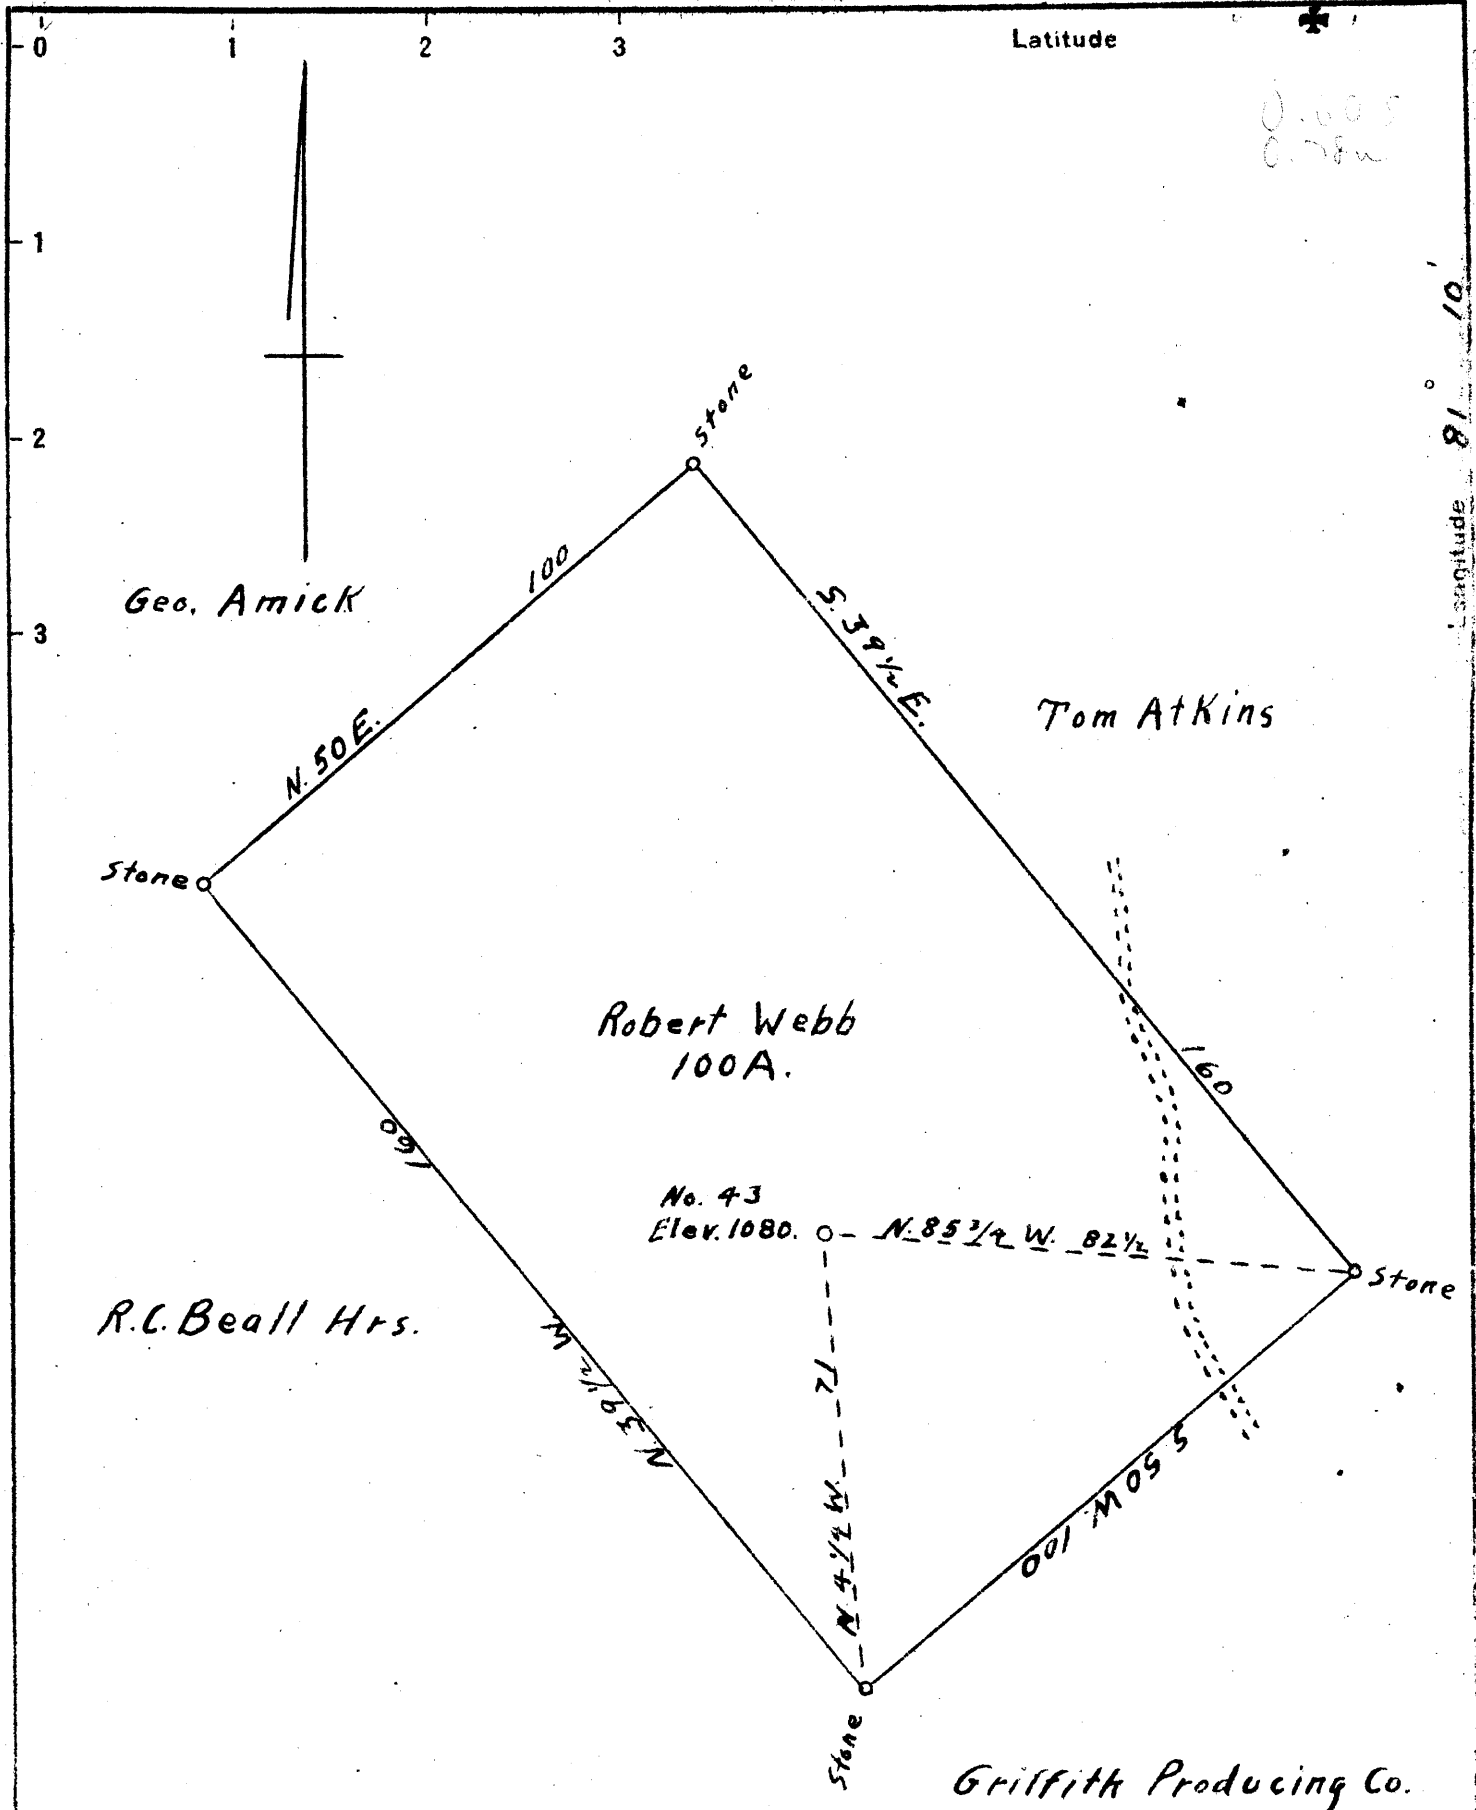

New Location
 Drill Deeper
 Abandonment

Company R. J. Newman
 Address Stockport, Ohio
 Farm Robert Webb
 Tract _____ Acres 100 Lease No. _____
 Well (Farm) No. 43 Serial No. _____
 Elevation (Spirit Level) 1080.
 Quadrangle Harrisville
 County Ritchie District Grant
 Engineer A. K. Westfall
 Engineer's Registration No. County Surveyor
 File No. _____ Drawing No. _____
 Date Oct 23, 1943 Scale 1" = 30 Poles

STATE OF WEST VIRGINIA
 DEPARTMENT OF MINES
 OIL AND GAS DIVISION
 CHARLESTON

WELL LOCATION MAP
 FILE NO. RIT-696-A

+ Denotes location of well on United States Topographic Maps, scale 1 to 62,500, latitude and longitude lines being represented by border lines as shown.
 - Denotes one inch spaces on border line of original tracing.