

New Location
 Drill Deeper
 Abandonment

NOV 14 1944

MAP SH. 74 SQ. 5-23 W-19 F.B. 765 R 19

Company HOPE NATURAL GAS CO.
 Address CLARKSBURG, W.VA.
 Farm O. K. GAINER
 Tract _____ Acres 130 Lease No. 22696
 Well (Farm) No. _____ Serial No. 6094
 Elevation (Spirit Level) 1007'
 Quadrangle HOLBROOK
 County RITCHIE District UNION
 Engineer W.M. Bower
 Engineer's Registration No. 900
 File No. _____ Drawing No. _____
 Date 10-23-44 Scale 1" = 600'


STATE OF WEST VIRGINIA
 DEPARTMENT OF MINES
 OIL AND GAS DIVISION
 CHARLESTON

WELL LOCATION MAP
 FILE NO. RIC-707-A

+ Denotes location of well on United States Topographic Maps, scale 1 to 62,500, latitude and longitude lines being represented by border lines as shown.
 - Denotes one inch spaces on border line of original tracing



STATE OF WEST VIRGINIA
DEPARTMENT OF MINES
OIL AND GAS DIVISION

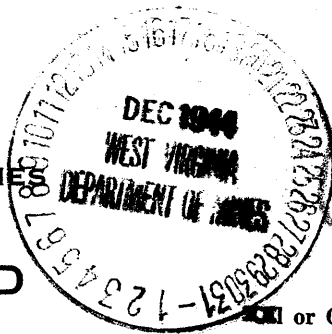

634

AD
707-A

WELL RECORD

Permit No. _____ Oil or Gas Well _____ (KIND)


Company Hope Natural Gas Company.
 Address 445 West Main St. Clarksburg, W. Va.
 Farm O.K. Gainer. Acres 130
 Location (waters) _____
 Well No. 6094 Elev. 1007
 District Union County Ritchie
 The surface of tract is owned in fee by _____
 Address _____
 Mineral rights are owned by _____
 Address _____
 Drilling commenced November 15, 1921
 Drilling completed December 30, 1921
 Date Shot _____ From _____ To _____
 With _____
 Open Flow _____ /10ths Water in _____ Inch
 _____ /10ths Merc. in _____ Inch
 Volume _____ Cu. Ft.
 Rock Pressure _____ lbs. _____ hrs.
 Oil _____ bbls., 1st 24 hrs.
 Fresh water none recorded feet _____ feet
 Salt water none recorded feet _____ feet

Casing and Tubing	Used in Drilling	Left in Well	Packers
Size			
16			Kind of Packer
13			
10	322	Pulled	Size of
8 1/4	1082	1082	
6 3/8	1836	Pulled	Depth set
5 3/16			
3	534	534	Perf. top
2	1228	1228	Perf. bottom
Liners Used			Perf. top
			Perf. bottom

Not cemented
 CASING CEMENTED _____ SIZE _____ No. Ft. _____ Date _____

None recorded
 COAL WAS ENCOUNTERED AT _____ FEET _____ INCHES
 _____ FEET _____ INCHES FEET _____ INCHES
 _____ FEET _____ INCHES FEET _____ INCHES

Formation	Color	Hard or Soft	Top	Bottom	Oil, Gas or Water	Depth Found	Remarks
Little Dunkard			970	1000			
Big Dunkard			1130	1200			
Gas sand			1280	1300			
First Salt			1340	1401	gas	1346	
Second Salt			1440	1460			
Third Salt			1495	1525			
Maxon			1725	1750	gas	1742	
Total depth				1762			

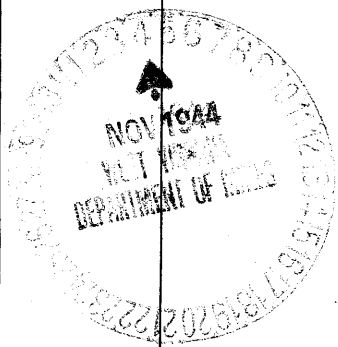

Formation	Color	Hard or Soft	Top	Bottom	Oil, Gas or Water	Depth Found	Remarks

Date November 3, 1944, 194

APPROVED Hope Natural Gas Company., Owner

By [Signature] Ass't. to Gen. Supt.
(Title)

