

New Location
Drill Deeper
Abandonment

Company Mc Call's Drilling Co. Inc
 Address 612 Keystone Bldg. Pittsburgh Pa.
 Farm H.B. Davis Sur. Hooker Wilson Hrs 05m.
 Tract _____ Acres 190 Lease No. _____
 Well (Farm) No. 1-15 Serial No. 15
 Elevation (Spirit Level) 883
 Quadrangle Holbrook
 County Ritchie District Clay
 Engineer A.K. Westfall
 Engineer's Registration No. _____
 File No. _____ Drawing No. _____
 Date 3/15/46 Scale 1" = 40 Poles

STATE OF WEST VIRGINIA
DEPARTMENT OF MINES
OIL AND GAS DIVISION
CHARLESTON

WELL LOCATION MAP
FILE NO RIT-755-A

+ Denotes location of well on United States Topographic Maps, scale 1" = 62,500, latitude and longitude lines being represented by border lines as shown.
 - Denotes one inch spaces on border line of original tracing.

WW

H.B. DAVIS (surf)
Hooker Wilson Hrs-05m No. 1(15) - McCall Drilling Co. - RIT-755-A

HOOKER WILSON AND H. B. DAVIS NO. 1 (15) WELL.

Clay District, Ritchie County, W. Va.

By McCall Drilling Co., 612 Keystone Bldg., Pittsburgh, Pa.

Abandoned under permit Rit-----A?

On.....acres.

Elevation, 887' L.

Surface owned by H. B. Davis, Pennsboro, W. Va., and minerals by Heirs of
Hooker Wilson, Pennsboro, W. Va.

Drilling commenced Aug. 19, 1925; completed Sept. 11, 1925.

Shot Oct. 24, 1925, at 1916-1920', with 20 qts.

Open flow, 9/10ths W. in 2" after shot.

Rock pressure, 195 lbs. in 30 min.

10" casing, 309' (pulled); 8 1/2", 1027' (pulled); 6 3/4", 1775'; 2" tubing, 2015'.

Anchor packer, 6 3/4" x 2, set at 1890'.

Gas well. Abandonment reported to Dept. of Mines May 21, 1946.

Record to RCT from Mrs. Griffith September 11, 1946. Old File No. 712.

	Top.	Bottom.
Little Darkard Sand	840	- 860
Big Darkard Sand	940	- 990
Gas Sand	1023	- 1045
1st Salt Sand	1105	- 1230
2nd Salt Sand	1234	- 1430
Broken sand	1556	- 1600
Sand	1650	- 1680
Little Lime	1734	- 1742
Big Lime	1750	- 1815
Big Injun Sand	1815	- 1924
Slate shells	1924	- 2024
Total depth		2024



712

STATE OF WEST VIRGINIA
DEPARTMENT OF MINES
OIL AND GAS DIVISION

WELL RECORD

Permit No. R12755-A


Oil or Gas Well Gas
(KIND)

Company McCall Drilling Company
Address #612 Keystone Bldg., Pgh. Pa.
Farm Hooker Wilson & H.B. Davis Acres.....
Location (waters).....
Well No. 1-15 Elev. 883
District Clay County Ritchie
The surface of tract is owned in fee by H.B. Davis,
Pennsboro, W. Va. Address.....
Mineral rights are owned by Heirs of Hooker Wilson
Pennsboro, W. Va. Address.....
Drilling commenced August 19, 1925
Drilling completed Sept. 11th, 1925
Date Shot Oct. 24 From 1916 To 1920
With 20 Qt.
Open Flow 9/10ths Water in 2" A.S. Inch
..... /10ths Merc. in..... Inch
Volume..... Cu. Ft.
Rock Pressure 195 lbs. 30 Min. hrs.
Oil..... bbls., 1st 24 hrs.
Fresh water..... feet..... feet
Salt water..... feet..... feet

Casing and Tubing	Used in Drilling	Left in Well	Packers
Size			
16			Kind of Packer.....
13			Anchor
10	309	none	Size of <u>6-5/8" x</u>
8 1/4	1027	None	2" Depth set <u>1890'</u>
6 5/8	1775	1775	
5 3/16			
3			Perf. top.....
2	2015	2015	Perf. bottom.....
Liners Used			Perf. top.....
			Perf. bottom.....

CASING CEMENTED..... SIZE..... No. Ft..... Date.....
COAL WAS ENCOUNTERED AT..... FEET..... INCHES
..... FEET..... INCHES..... FEET..... INCHES
..... FEET..... INCHES..... FEET..... INCHES

Formation	Color	Hard or Soft	Top	Bottom	Oil, Gas or Water	Depth Found	Remarks
Little Dunkard			840	860			
Big "			940	990			
Gas Sand			1023	1045			
1st Salt			1105	1230			
2nd Salt			1234	1430			
Broken Sand			1556	1600			
Sand			1650	1680			
Little Lime			1734	1742			
Big Lime			1750	1815			
Big Injun			1815	1924			
Slate Shells			1924	2024			
Total Depth			2024				

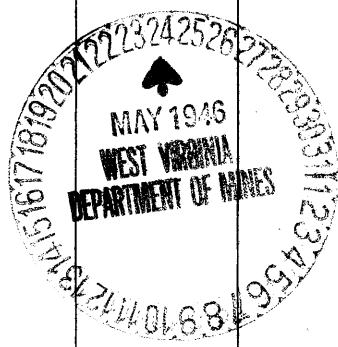

Formation	Color	Hard or Soft	Top	Bottom	Oil, Gas or Water	Depth Found	Remarks

Date May 21st, 1946, 194

APPROVED McCall Drilling Company, Owner

By _____ (Title)