


Company OTTO NELLE OIL & GAS CO.
 Address CORNWALLIS, W. VA.
 Farm HARLEY MAHONEY
 Tract _____ Acres 152 Lease No. _____
 Well (Farm) No. 8, 18, 19, 25 Serial No. _____
 Elevation (Spirit Level) 695, 949, 960, 737
 Quadrangle HARRISVILLE
 County RITCHIE District GRANT **NC**
 Engineer B. F. RINEHART
 Engineer's Registration No. 648
 File No. _____ Drawing No. 650-GR
 Date Nov. 22, 1947 Scale 1 in. = 500 ft.

STATE OF WEST VIRGINIA
 DEPARTMENT OF MINES
 OIL AND GAS DIVISION
 CHARLESTON

WELL LOCATION MAP

FILE NO. Rit-805-A-#18
Rit-807-A-#19

- + Denotes location of well on U ited States Topographic Maps, scale 1 to 62,500, latitude and longitude lines being represented by border lines as shown.
- Denotes one inch spaces on border line of original tracing.

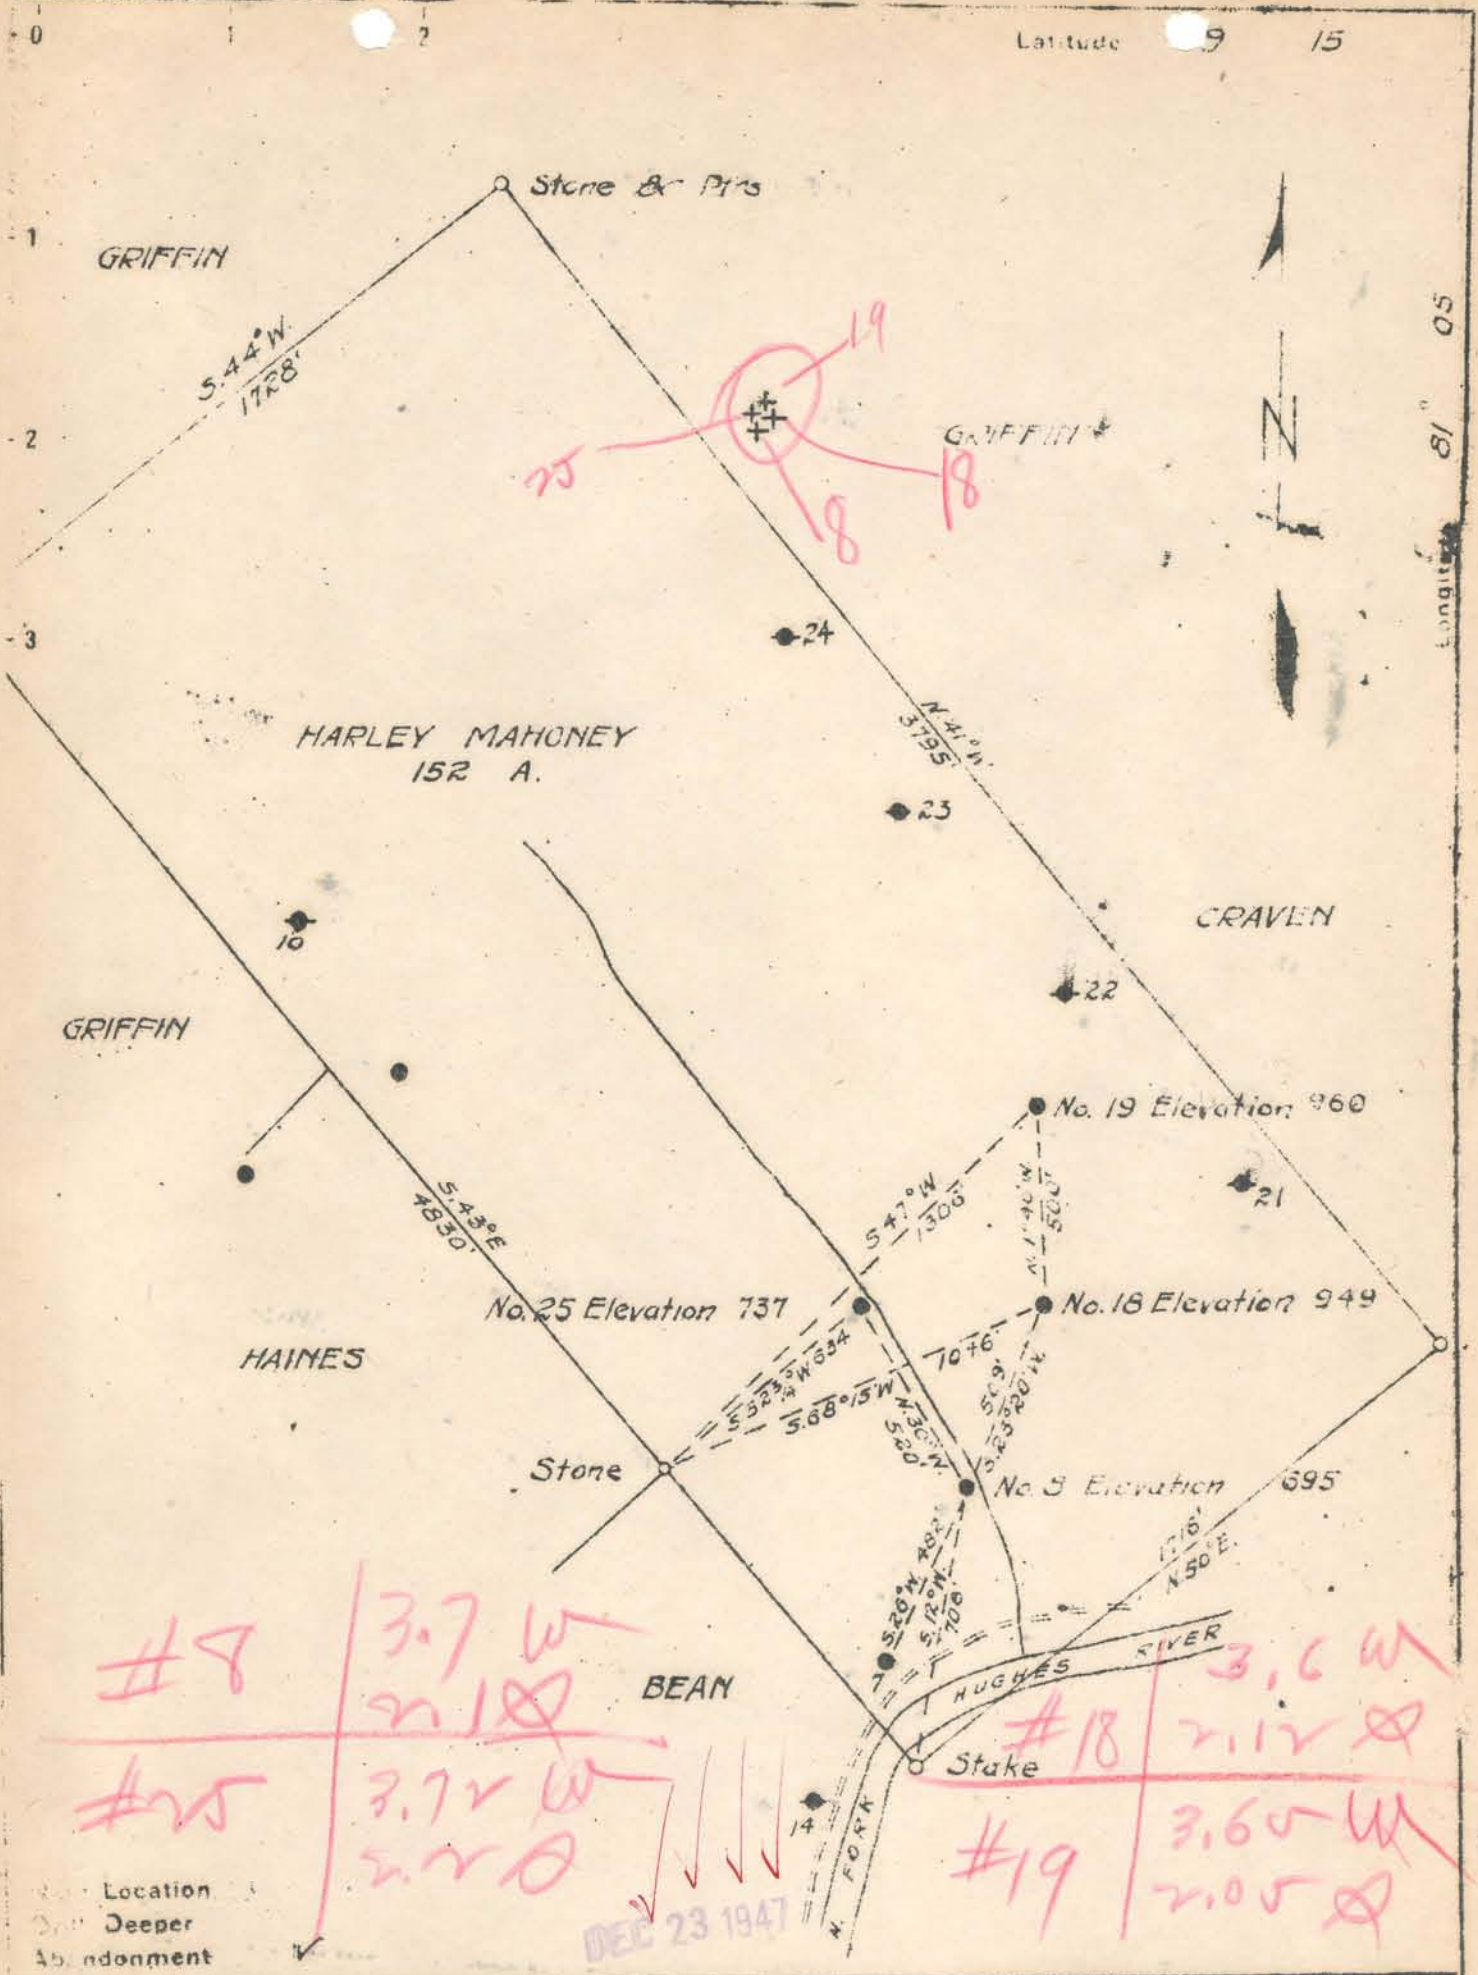

Company OTTO NELLE OIL & GAS CO.
 Address CORNWALLIS, W. VA.
 Farm HARLEY MAHONEY
 Tract _____ Acres 152 Lease No. _____
 Well Farm No. 8, 18, 19, 25 Serial No. _____
 Elevation (Spirit Level) 695, 949, 960, 737
 Quadrangle HARRISVILLE
 County RITCHIE District GRANT
 Engineer B. F. RINEHART
 Engineer's Registration No. 648
 File No. _____ Drawing No. 650-GR
 Date Nov. 22, 1947 Scale 1 in. = 500 ft.

STATE OF WEST VIRGINIA
 DEPARTMENT OF MINES
 OIL AND GAS DIVISION
 CHARLESTON

WELL LOCATION MAP
 FILE NO. RIT-805-A-#18
RIT-806-A-#19

+ Denotes location of well on United States Topographic Maps, scale 1 to 62,500, latitude and longitude lines being represented by border lines as shown

- Denotes one inch spaces on border line of original tracing

dup
No.