

Company OTTO NELLE OIL & GAS CO.

Address CORNWALLIS, W. VA.

Farm HARLEY MAHONEY

Tract _____ Acres 152 Lease No. _____

Well (Farm) No. 8, 18, 19, 25 Serial No. _____

Elevation (Spirit Level) 695, 949, 960, 737

Quadrangle HARRISVILLE

County RITCHIE District GRANT NC

Engineer B. F. RINEHART

Engineer's Registration No. 648

File No. _____ Drawing No. 650-GR

Date Nov. 22, 1947 Scale 1 in. = 500 ft.

STATE OF WEST VIRGINIA
DEPARTMENT OF MINES
OIL AND GAS DIVISION
CHARLESTON


#9-100-A

WELL LOCATION MAP

FILE NO. Rit-805-A-#18
Rit-807-A-#19

+ Denotes location of well on U ited States Topographic Maps, scale 1 to 62,500, latitude and longitude lines being represented by border lines as shown.

- Denotes one inch spaces on border line of original tracing.

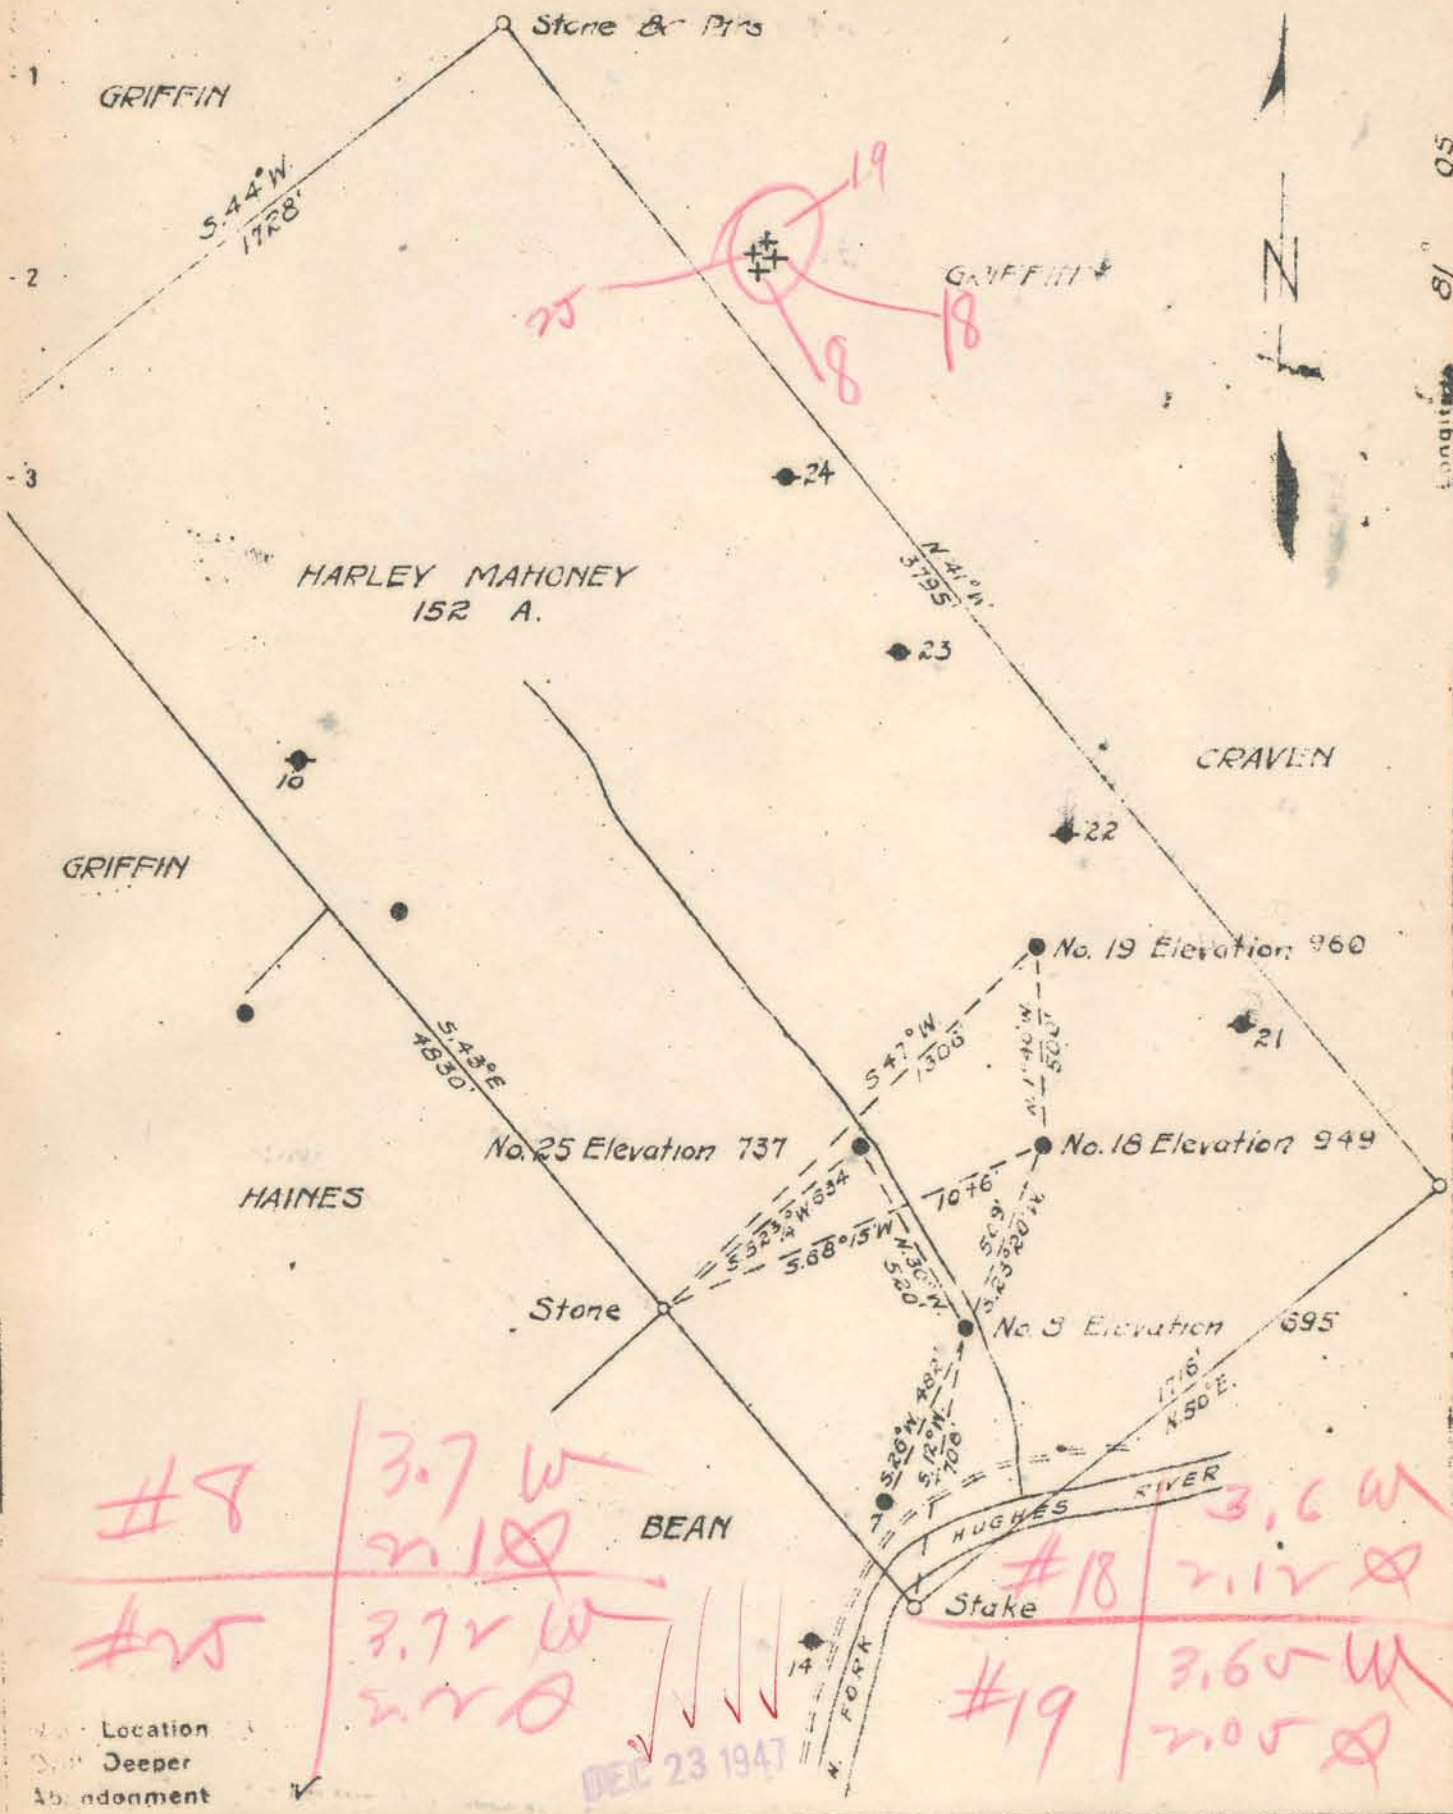

Company OTTO NELLE OIL & GAS CO.
 Address CORNWALLIS, W. VA.
 Farm HARLEY MAHONEY
 Tract _____ Acres 152 Lease No. _____
 Well Farm No. 8, 18, 19, 25 Serial No. _____
 Elevation (Spirit Level) 695, 949, 960, 737
 Quadrangle HARRISVILLE
 County RITCHIE District GRANT
 Engineer B. F. RINEHART
 Engineer's Registration No. 648
 File No. _____ Drawing No. 650-GR
 Date Nov. 22, 1947 Scale 1 in. = 500 ft.

STATE OF WEST VIRGINIA
 DEPARTMENT OF MINES
 OIL AND GAS DIVISION
 CHARLESTON

WELL LOCATION MAP

FILE NO. Rit-805-A-#18
Rit-806-A-#19

+ Denotes location of well of United States Topographic Maps, scale 1 to 62,500, latitude and longitude lines being represented by border lines as shown

- Denotes one inch spaces on border line of original tracing

dup No.

NO