


Latitude 39° 10'

Longitude 81° 15'

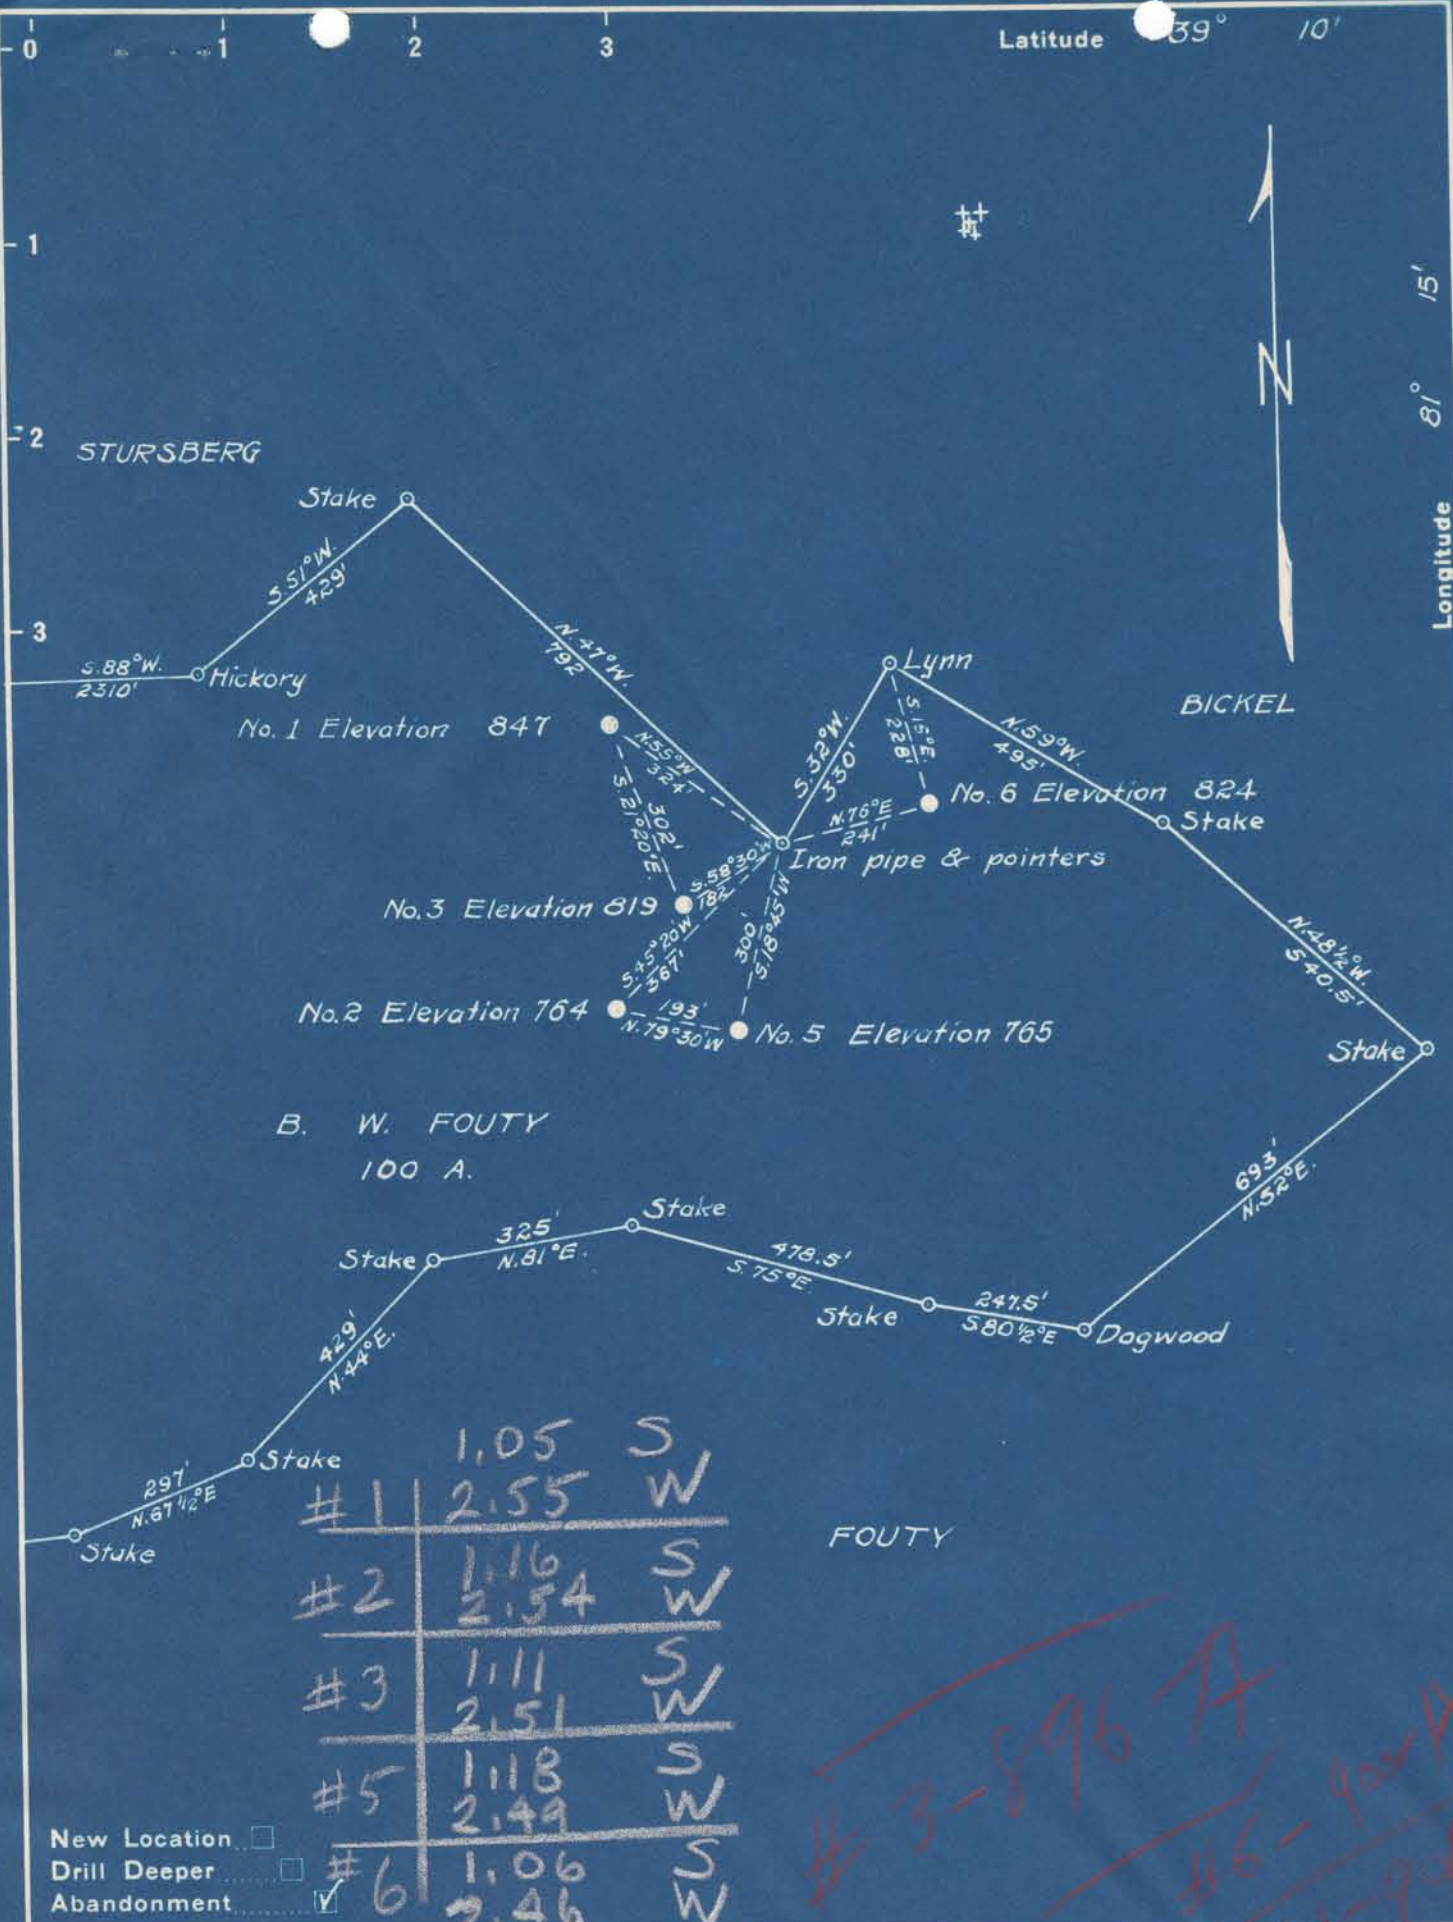

New Location
 Drill Deeper
 Abandonment

Company P. O. BURG

Address CORNWALLIS, W. VA.

Farm B. W. FOUTY

Tract _____ Acres 100 Lease No. _____

Well (Farm) No. 1, 2, 3, 5, 6 Serial No. _____

Elevation (Spirit Level) 847, 764, 819, 765, 824

Quadrangle ELIZABETH

County RITCHIE District GRANT

Engineer B. F. RINEHART

Engineer's Registration No. 648

File No. _____ Drawing No. 701-GR

Date July 31, 1948 Scale 1 in. = 300 ft.

STATE OF WEST VIRGINIA
 DEPARTMENT OF MINES
 OIL AND GAS DIVISION
 CHARLESTON

WELL LOCATION MAP
 FILE NO. Rit-859-A-#2

+ Denotes location of well on United States Topographic Maps, scale 1 to 62,500, latitude and longitude lines being represented by border lines as shown.

- Denotes one inch spaces on border line of original tracing.

B. W. FOUTTY NO. 2 WELL.

859A

Grant District, Ritchie County, W. Va.
By Burgoyne & Marshall, Cornwallis, W. Va.
Abandoned under permit Nit-.....-11
On 100 acres, on Hughes River.
Elevation, 764' L.
Surface and minerals owned by B. W. Foutty, Route 2, Petroleum, W. Va.
Date of completion, unknown.
Shot at 950-962', with 10 qts.
4-7/8" casing, 820'.
Oil well. Record to Dept. of Mines stamped Aug. 7, 1948.
Record to RCT from Mrs. Griffith Jan. 22, 1949. Old File No. 782.

	Top.	Bottom.
Maxton Sand gas	737	-
Keener Sand gas	868	-
Oil pay	953	- 965
Total depth		982



STATE OF WEST VIRGINIA
DEPARTMENT OF MINES
OIL AND GAS DIVISION

782

WELL RECORD

Permit No. Ab 859-A Oil or Gas Well _____ (KIND)

Company Burgy and Marshall
 Address Cornwallis, W.Va.
 Farm B W Foutty Acres 100
 Location (waters) Hughes River
 Well No. 3 Elev. 764
 District Grant County Ritchie
 The surface of tract is owned in fee by B W Foutty
Petroleum Address W.Va. Route 3
 Mineral rights are owned by B W Foutty
Petroleum Address W.Va. Route 3
 Drilling commenced Unknown
 Drilling completed Unknown
 Date Shot Unknown From 950 To 962
 With 10 qts.
 Open Flow /10ths Water in _____ Inch
 /10ths Merc. in _____ Inch
 Volume _____ Cu. Ft.
 Rock Pressure _____ lbs. _____ hrs.
 Oil _____ bbls., 1st 24 hrs.
 Fresh water _____ feet _____ feet
 Salt water _____ feet _____ feet

Casing and Tubing	Used in Drilling	Left in Well	Packers
Size			
16			Kind of Packer
13			
10			Size of
8 1/4			Depth set
6 1/2			
5 3/16			
3 1/2 4 7/8	820	830	Perf. top
2			Perf. bottom
Liners Used			Perf. top
			Perf. bottom

CASING CEMENTED _____ SIZE _____ No. Ft. _____ Date _____
 COAL WAS ENCOUNTERED AT _____ FEET _____ INCHES
 _____ FEET _____ INCHES _____ FEET _____ INCHES
 _____ FEET _____ INCHES _____ FEET _____ INCHES

Formation	Color	Hard or Soft	Top	Bottom	Oil, Gas or Water	Depth Found	Remarks
Moxon gas			737				
Keener gas			868				
Oil pay			953				
				965			
				Total depth 982			

