

New Location   
 Drill Deeper   
 Abandonment

0.01 SW  
 4.38 W


Company CARL D. PERKINS  
 Address MOLE HILL, W. VA.  
 Farm JACOB RIGGS  
 Tract \_\_\_\_\_ Acres 35 Lease No. \_\_\_\_\_  
 Well (Farm) No. 1 Serial No. SC  
 Elevation (Spirit Level) 661  
 Quadrangle HARRISVILLE  
 County RITCHIE District MURPHY  
 Engineer B. F. RINEHART  
 Engineer's Registration No. 648  
 File No. \_\_\_\_\_ Drawing No. 718-MR  
 Date Oct. 9, 1948 Scale 1 in. = 300 ft.

STATE OF WEST VIRGINIA  
 DEPARTMENT OF MINES  
 OIL AND GAS DIVISION  
 CHARLESTON

**WELL LOCATION MAP**  
 FILE NO. Rit-899-A

+ Denotes location of well on United States Topographic Maps, scale 1 to 62,500, latitude and longitude lines being represented by border lines as shown.

- Denotes one inch spaces on border line of original tracing.

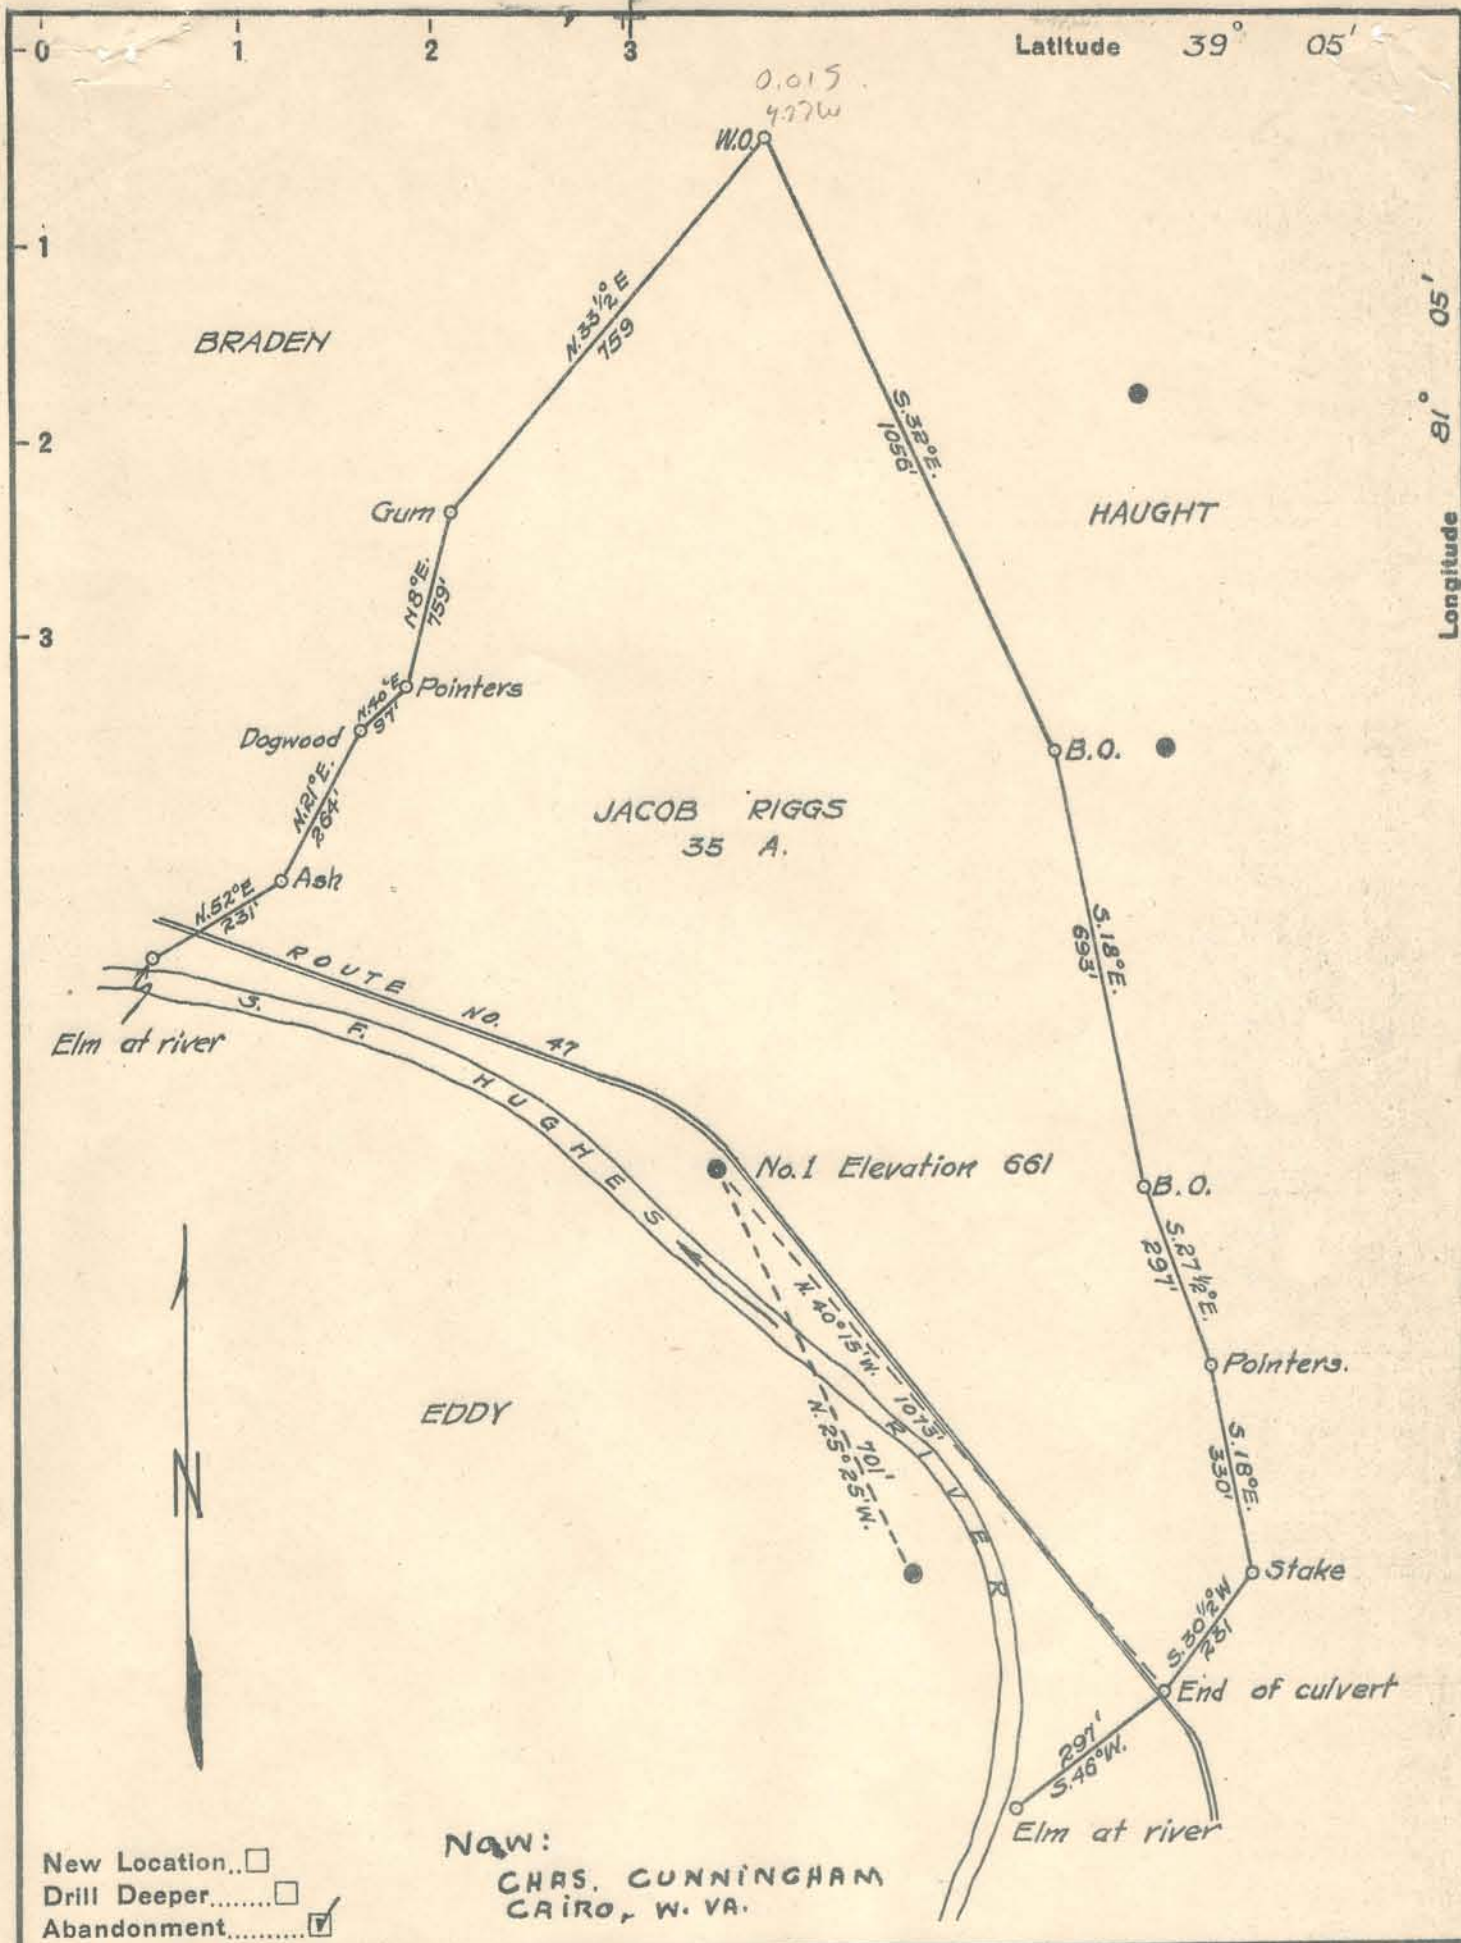

New Location...   
 Drill Deeper.....   
 Abandonment.....

Now:  
 CHAS. CUNNINGHAM  
 CAIRO, W. VA.

Company	CARL D. PERKINS		
Address	MOLE HILL, W. VA.		
Farm	JACOB RIGGS		
Tract	Acres	35	Lease No.
Well (Farm) No.	1	Serial No.	
Elevation (Spirit Level)	661		
Quadrangle	HARRISVILLE		
County	RITCHIE	District	MURPHY
Engineer	B. F. RINEHART		
Engineer's Registration No.	648		
File No.	Drawing No. 718-MR		
Date	Oct. 9, 1948	Scale	1 in. = 300 ft.

STATE OF WEST VIRGINIA  
 DEPARTMENT OF MINES  
 OIL AND GAS DIVISION  
 CHARLESTON

**WELL LOCATION MAP**  
 FILE NO. Rit-899-A

+ Denotes location of well on United States Topographic Maps, scale 1 to 62,500, latitude and longitude lines being represented by border lines as shown.

- Denotes one inch spaces on border line of original tracing.

JACOB RIGGS NO. 1 WELL.

Murphy District, Ritchie County, W. Va.

By Carl D. Perkins, Mole Hill (Mountain), W. Va.

Abandoned under permit Rit-899-A? ..... Quadrangle.  
On 35 acres.

Elevation, 661' L.

Surface owned by Jacob Riggs.

Date of completion, etc., not given.

6 $\frac{5}{8}$ " casing, 1422'; 2" tubing, 1422'.

Oil well. Record to Dept. of Mines stamped Feb. 28, 1955.

Record to RCT from Mrs. Griffith June 17, 1955. Old File No. 1101.

	Top.	Bottom.
Gas Sand	1132	- 1207
Salt Sand	1377	- 1462
Maxton Sand	1512	- 1577
Total depth		1580

JACOB RIGGS NO. 1 WELL.

899A

Murphy District, Ritchie County, W. Va.  
By Carl D. Perkins, Hole Hill (Mountain), W. Va.  
Abandoned under permit Rit-.....-A7 ..... quadrangle.  
On 35 acres.  
Elevation, 661' L.  
Surface owned by Jacob Riggs.  
Date of completion, etc., not given.  
6 3/4" casing, 1422'; 2" tubing, 1422'.  
Oil well. Record to Dept. of Mines stamped Feb. 26, 1955.  
Record to RCT from Mrs. Griffith June 17, 1955. Old File No. 1101.

	Top.	Bottom.
Gas Sand	1132	- 1207
Salt Sand	1377	- 1462
Maxton Sand	1512	- 1577
Total depth		1580