


Latitude 39° 10'

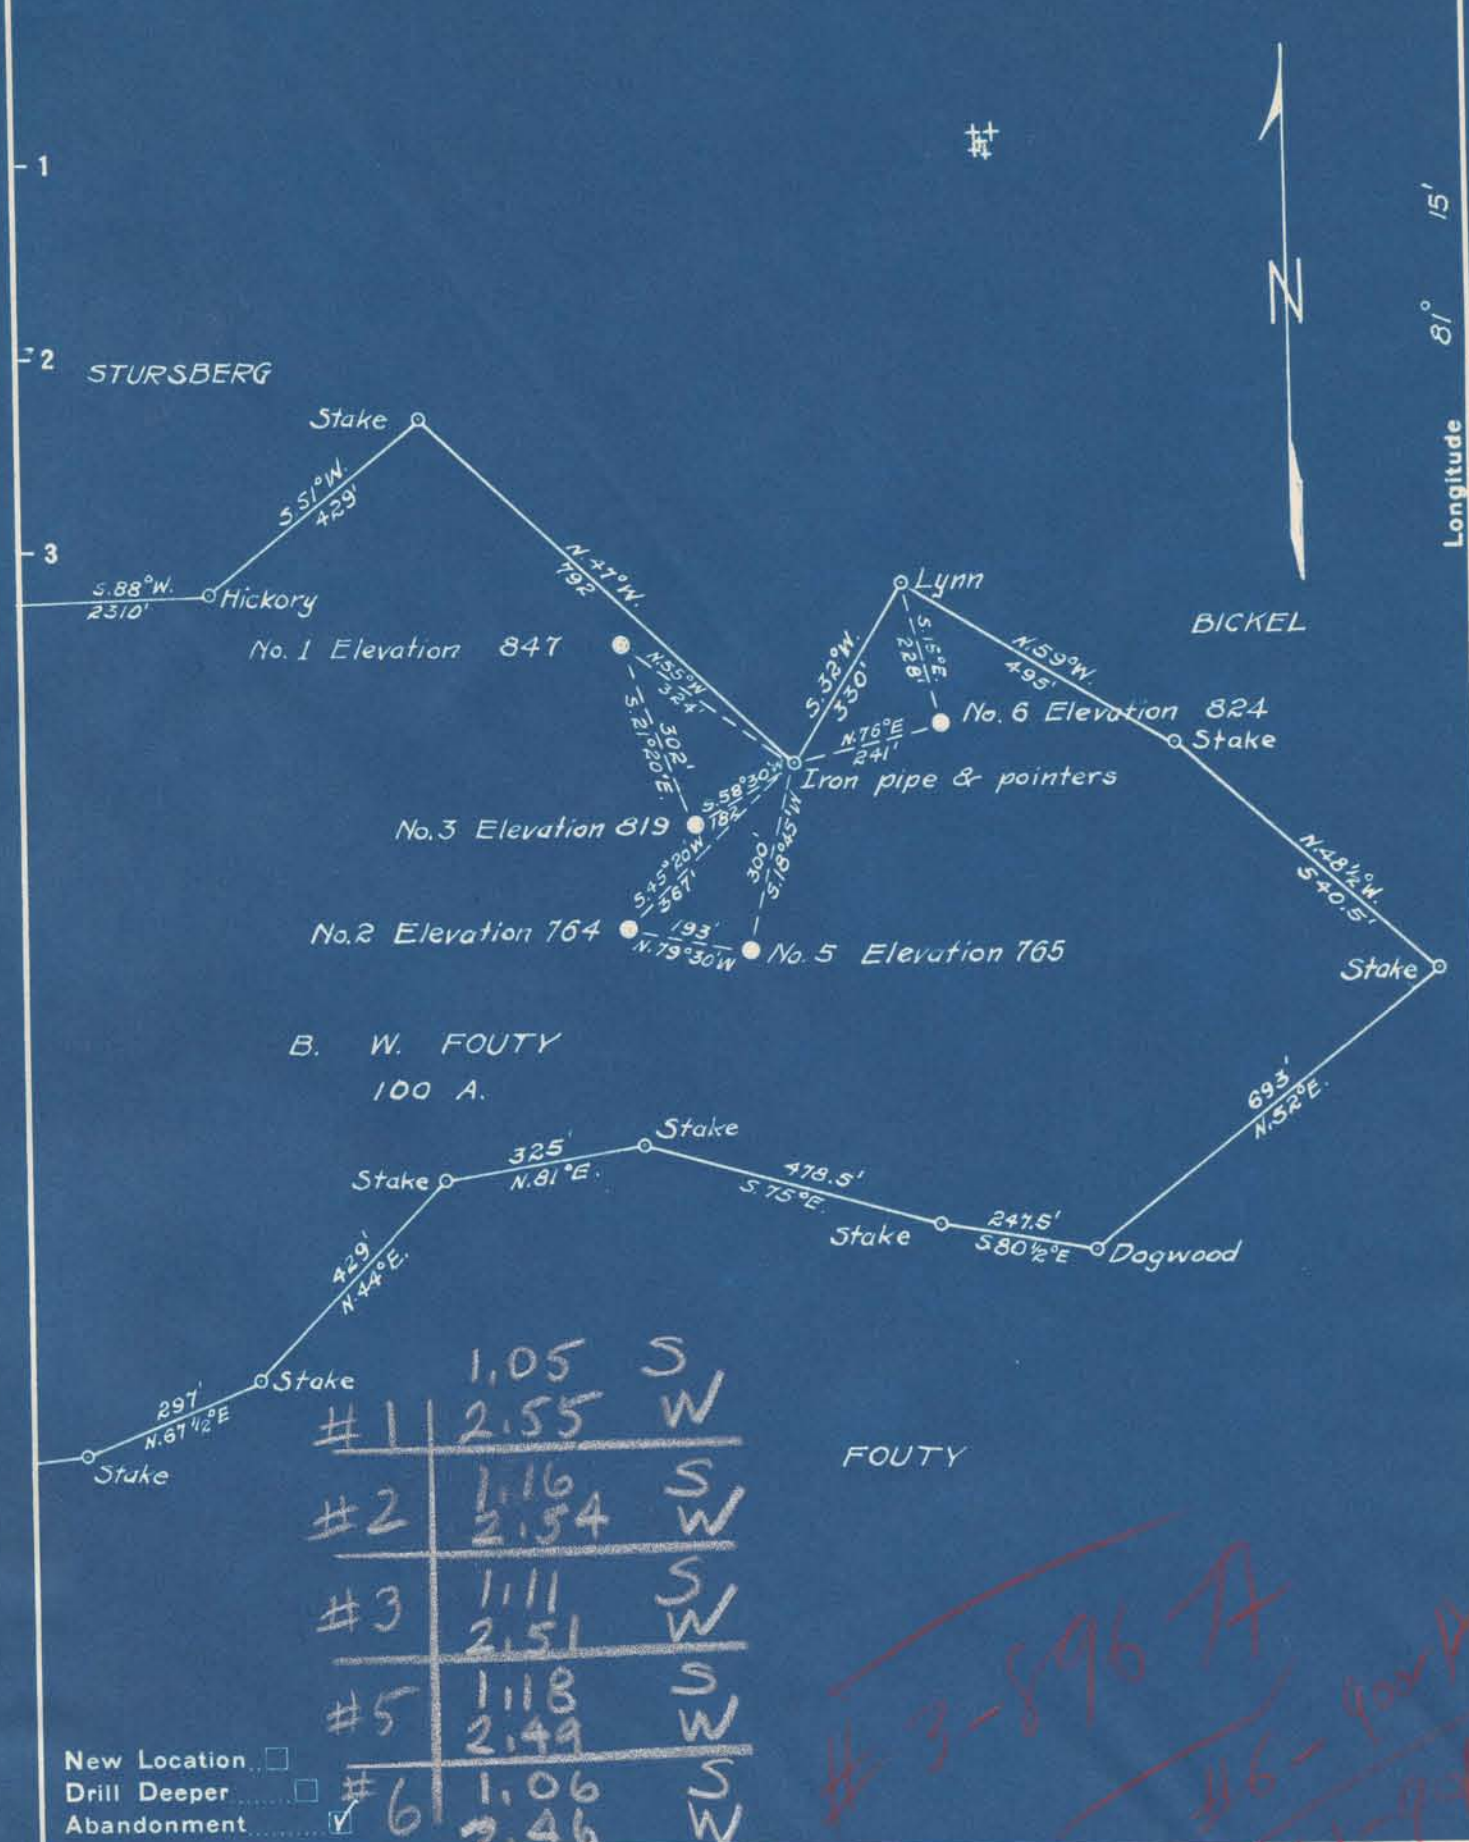

B. W. FOUTY
100 A.

#1	1,05	S
#2	2,55	W
#3	1,16	S
#5	2,54	W
#6	1,11	S
	2,51	W
	1,18	S
	2,49	W
	1,06	S
	2,46	W

New Location
 Drill Deeper
 Abandonment

#3-896 A
#6-400 A
#1-921 A

Company P. O. BURG
 Address CORNWALLIS, W. VA.
 Farm B. W. FOUTY
 Tract _____ Acres 100 Lease No. _____
 Well (Farm) No. 1,2,3,5,6 Serial No. _____
 Elevation (Spirit Level) 847, 764, 819, 765, 824
 Quadrangle ELIZABETH
 County RITCHIE District GRANT
 Engineer B. F. RINEHART
 Engineer's Registration No. 648
 File No. _____ Drawing No. 701-GR
 Date July 31, 1948 Scale 1 in. = 300 ft.

STATE OF WEST VIRGINIA
 DEPARTMENT OF MINES
 OIL AND GAS DIVISION
 CHARLESTON

WELL LOCATION MAP
 FILE NO. Rit-859-A-#2

+ Denotes location of well on United States Topographic Maps, scale 1 to 62,500, latitude and longitude lines being represented by border lines as shown.

- Denotes one inch spaces on border line of original tracing.