


Latitude 39° 10'

Longitude 81° 15'

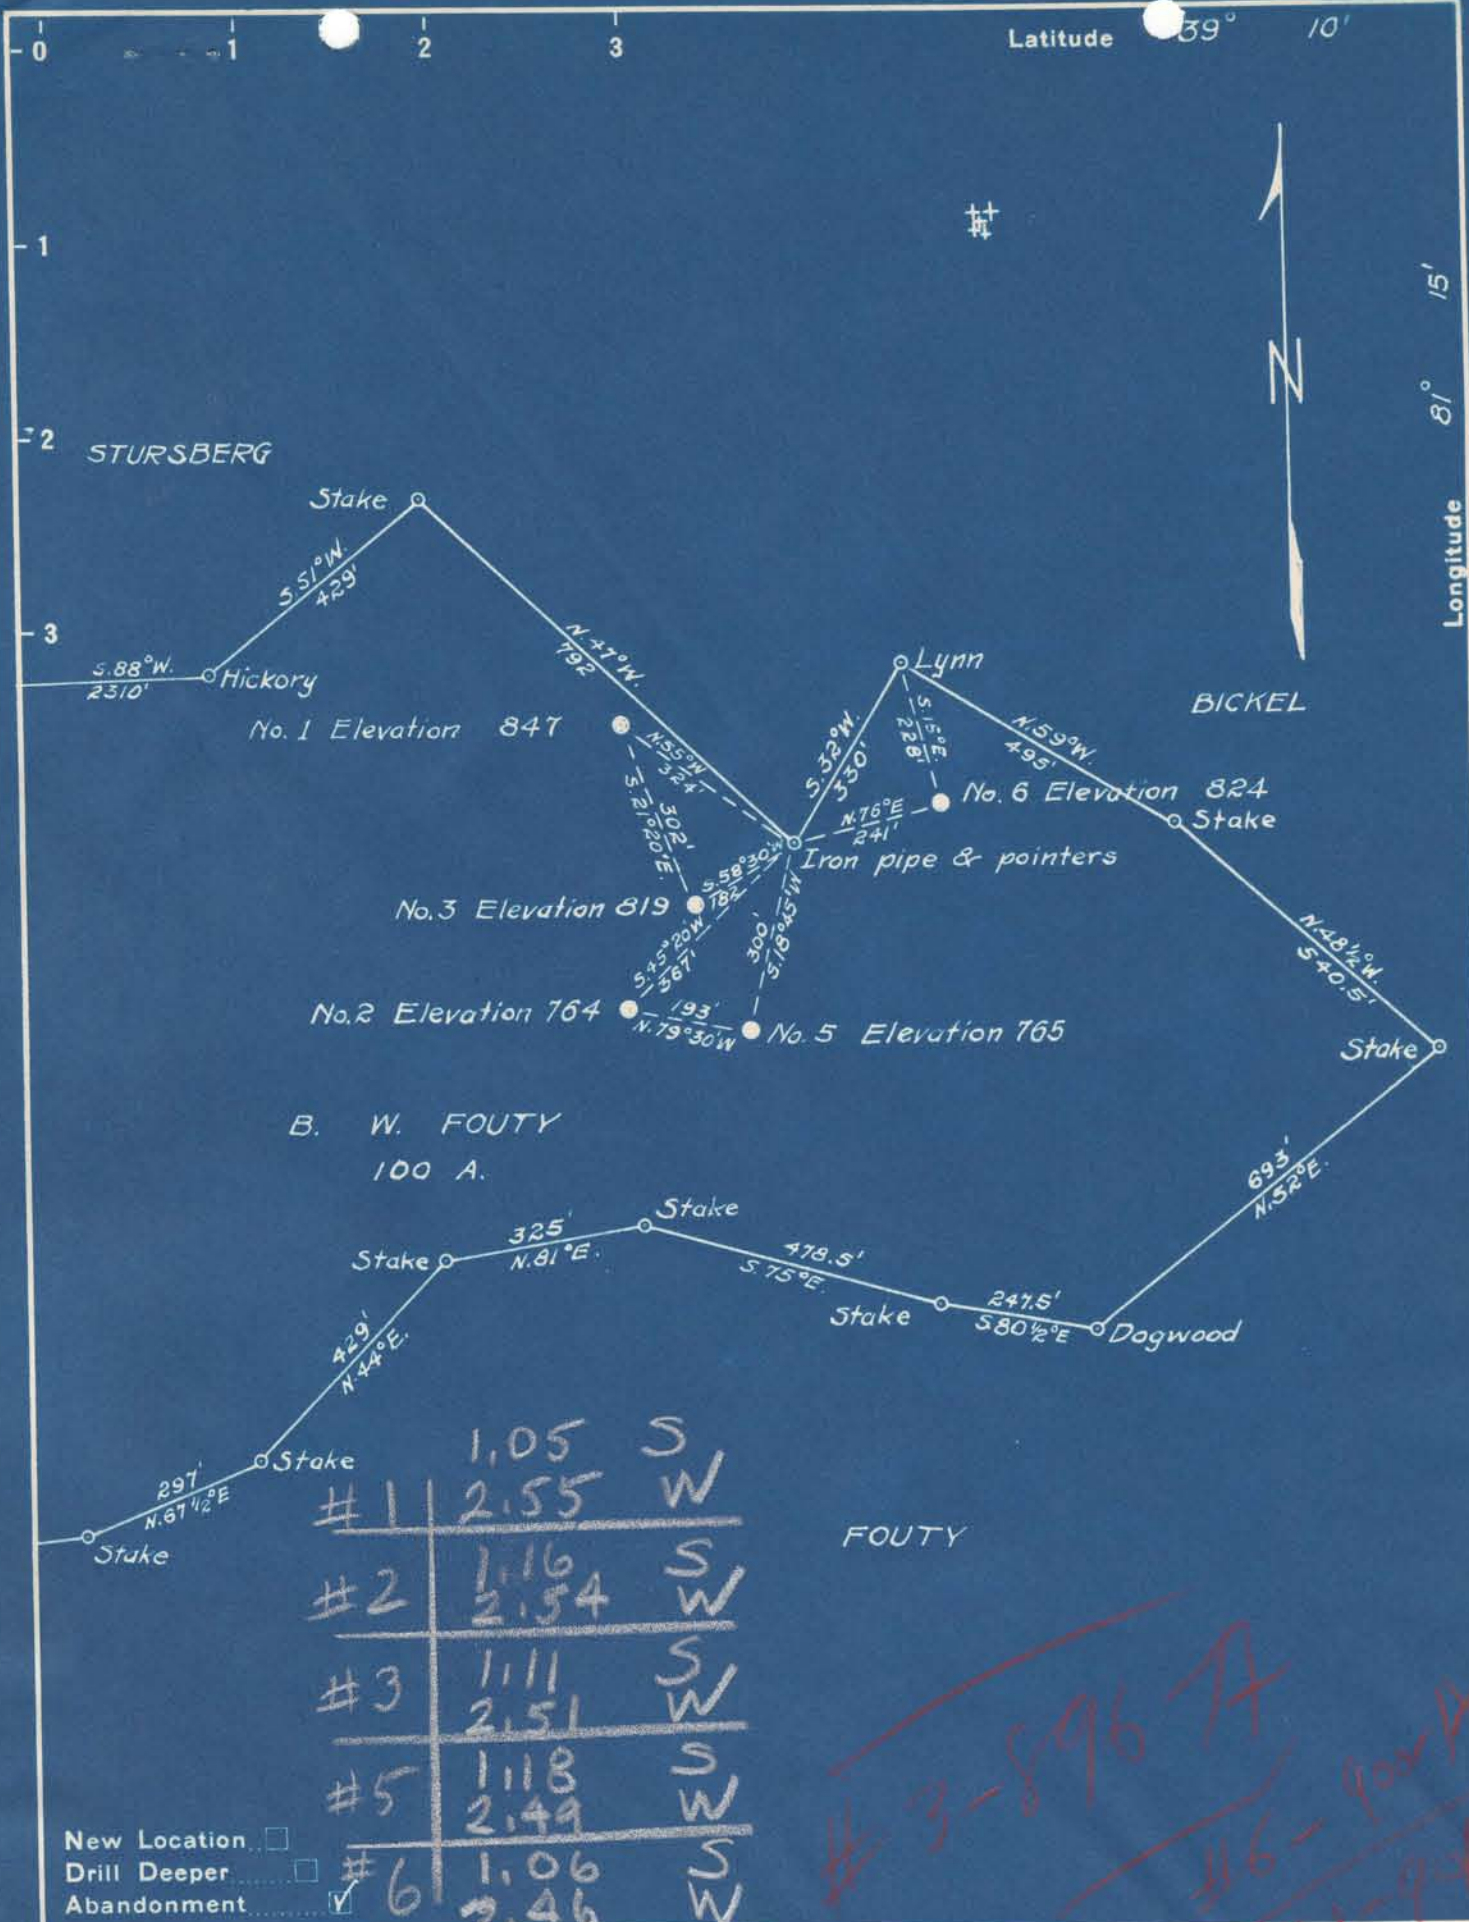

Company P. O. BURG

Address CORNWALLIS, W. VA.

Farm B. W. FOUTY

Tract _____ Acres 100 Lease No. _____

Well (Farm) No. 1,2,3,5,6 Serial No. _____

Elevation (Spirit Level) 847, 764, 819, 765, 824

Quadrangle ELIZABETH

County RITCHIE District GRANT

Engineer B. F. RINEHART

Engineer's Registration No. 648

File No. _____ Drawing No. 701-GR

Date July 31, 1948 Scale 1 in. = 300 ft.

STATE OF WEST VIRGINIA
 DEPARTMENT OF MINES
 OIL AND GAS DIVISION
 CHARLESTON

WELL LOCATION MAP
 FILE NO. Rit-859-A-#2

+ Denotes location of well on United States Topographic Maps, scale 1 to 62,500, latitude and longitude lines being represented by border lines as shown.

- Denotes one inch spaces on border line of original tracing.