


Latitude 39° 20'

Longitude 81° 05'

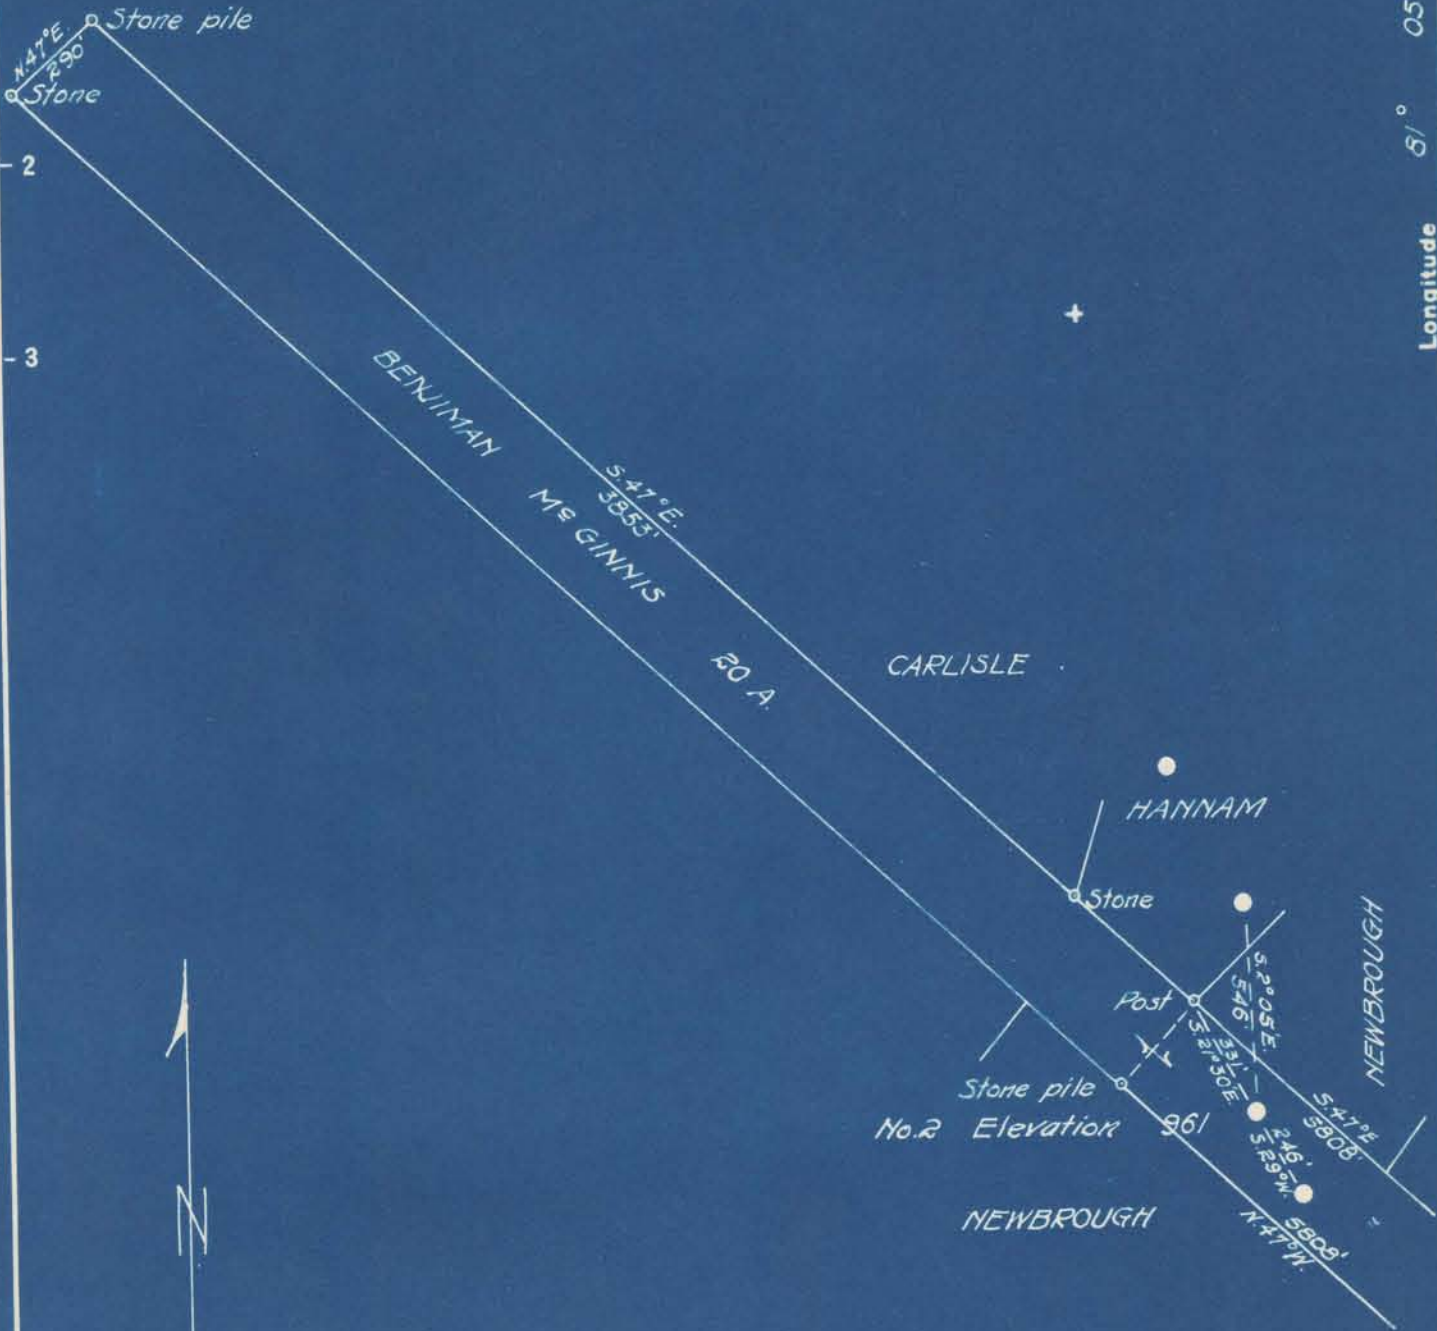

S 3.00
W 1.92

New Location
 Drill Deeper
 Abandonment

Company GENERAL OIL CO.
 Address PARKERSBURG, W. VA.
 Farm BENJIMAN McGINNIS
 Tract _____ Acres 57 Lease No. _____
 Well (Farm) No. 2 Serial No. _____
 Elevation (Spirit Level) 961
 Quadrangle SALTY MARYS
 County RITCHIE District GRANT
 Engineer B. F. RINEHART
 Engineer's Registration No. 648
 File No. _____ Drawing No. 761-GR
 Date July 29, 1950 Scale 1 in. = 500 ft.

STATE OF WEST VIRGINIA
 DEPARTMENT OF MINES
 OIL AND GAS DIVISION
 CHARLESTON

WELL LOCATION MAP
 FILE NO. Rit-987-A

+ Denotes location of well on United States Topographic Maps, scale 1 to 62,500, latitude and longitude lines being represented by border lines as shown.

- Denotes one inch spaces on border line of original tracing.



STATE OF WEST VIRGINIA
DEPARTMENT OF MINES
OIL AND GAS DIVISION

848

WELL RECORD

Permit No. RT 7 987-A

Oil or Gas Well Oil
(KIND)

Company General Oil Co., Inc.
P. O. Box 1755
Address 215 - 4th St., Parkersburg, W. Va.
Farm Benjamin McGinnis Acres 57
Location (waters) Bonds Creek
Well No. 2 Elev. 961
District Grant County Ritchie
The surface of tract is owned in fee by Benjamin McGinnis Address Ellenboro, W. Va.
Mineral rights are owned by Benjamin McGinnis Address Ellenboro, W. Va.

Drilling commenced Not known
Drilling completed Not known
Date Shot Not known From _____ To _____
With _____
Open Flow /10ths Water in _____ Inch
/10ths Merc. in _____ Inch
Volume _____ Cu. Ft.
Rock Pressure _____ lbs. _____ hrs.
Oil _____ bbls., 1st 24 hrs.
Fresh water _____ feet _____ feet
Salt water _____ feet _____ feet

Casing and Tubing	Used in Drilling	Left in Well	Packers
Size			Kind of Packer
16			
13			
10			Size of
8 1/4			Depth set
6 5/8		1650'	
5 3/16			Perf. top
3			Perf. bottom
2			Perf. top
Liners Used			Perf. bottom

CASING CEMENTED	SIZE	No. Ft.	Date
COAL WAS ENCOUNTERED AT _____ FEET _____ INCHES			
_____ FEET _____ INCHES _____ FEET _____ INCHES			
_____ FEET _____ INCHES _____ FEET _____ INCHES			

Formation	Color	Hard or Soft	Top	Bottom	Oil, Gas or Water	Depth Found	Remarks
Well purchased by us in 1947 - No well record. The only information we have is Oil - First pay 1,717' Second pay 1,726' to 1,734' Total depth 1736' No information as to how much well made							



9

(Over)

SEP - 9 1950

