


Latitude 39° 05'

Longitude 81° 00'

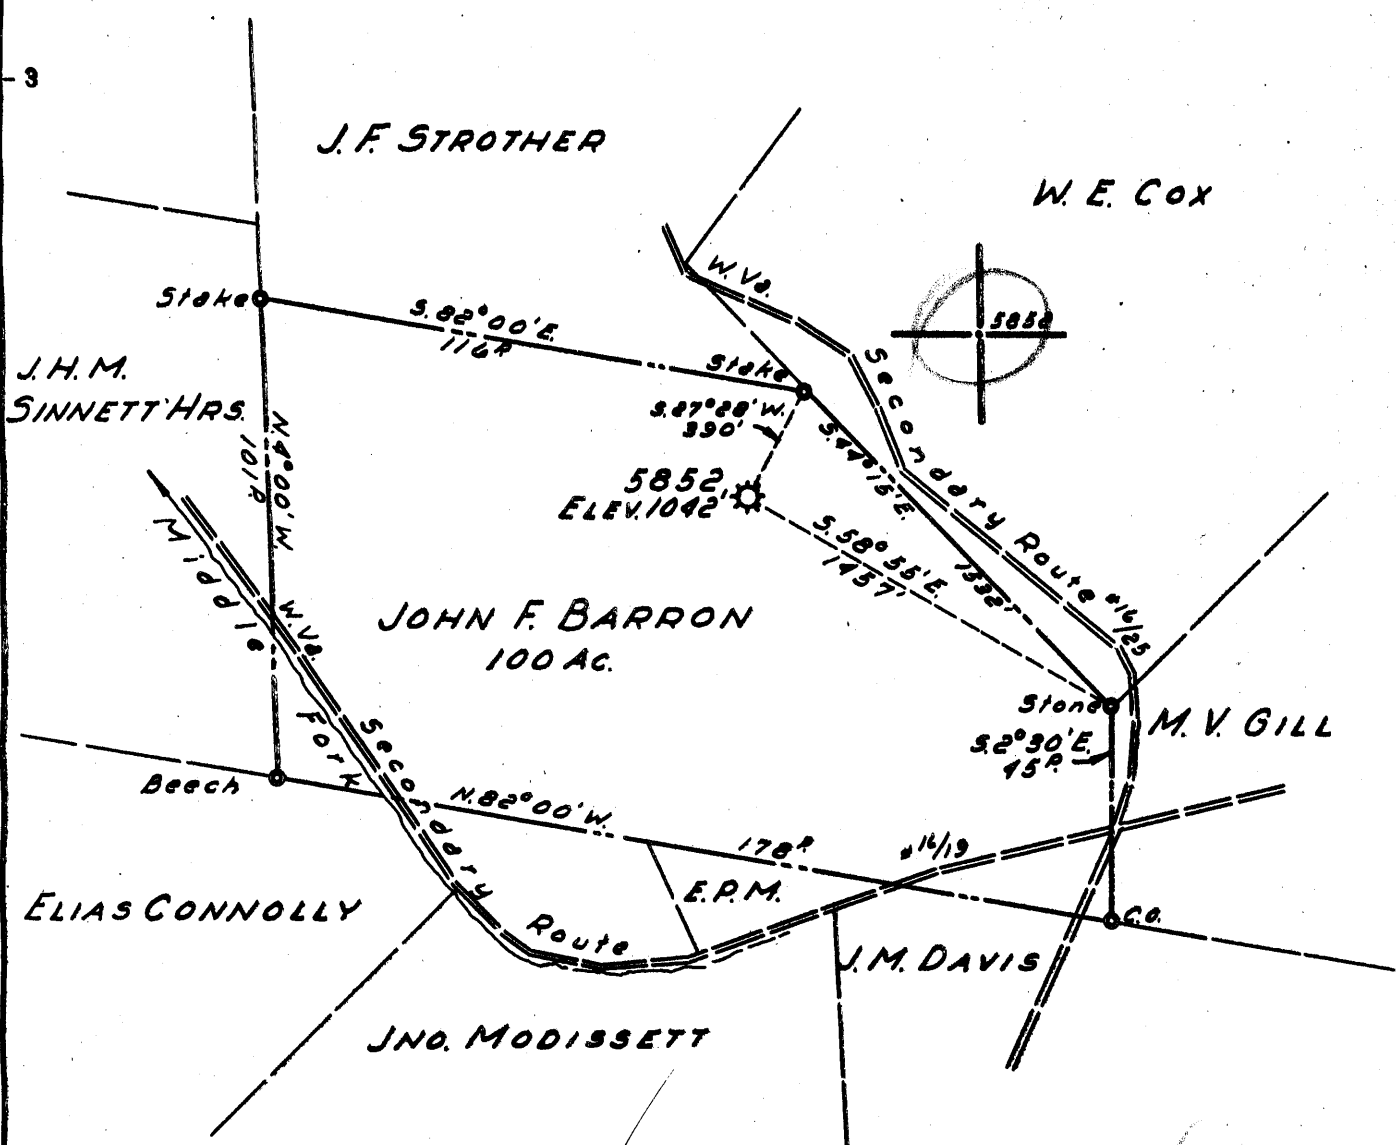

- New Location...
- Drill Deeper.....
- Abandonment.....

JUN 29 1953

MAP SH. 88: 30. S. 29 W. 25: F.B. 578 P. 20-21.

Company HOPE NATURAL GAS CO.
 Address CLARKSBURG, W. VA.
 Farm JOHN F. BARRON
 Tract _____ Acres 100 Lease No. 22736
 Well (Farm) No. _____ Serial No. 5852
 Elevation (Spirit Level) 1042'
 Quadrangle HARRISVILLE
 County RITCHIE District MURPHY
 Engineer Wm H Bradley
 Engineer's Registration No. 2425
 File No. _____ Drawing No. _____
 Date 4-8-53 Scale 1" = 40 FEET

STATE OF WEST VIRGINIA
 DEPARTMENT OF MINES
 OIL AND GAS DIVISION
 CHARLESTON

WELL LOCATION MAP
 FILE NO. RIT-1198-A

- + Denotes location of well on United States Topographic Maps, scale 1 to 62,500, latitude and longitude lines being represented by border lines as shown.
- Denotes one inch spaces on border line of original tracing.

JUG

JOHN F. BARRON NO. 5852 - HOPE NAT. GAS CO. - RIT-1198-A