

New Location
 Drill Deeper
 Abandonment 6395

MAY 31 1955 #6395
 Map Sht. 81; S-25; W-21; F.B. 1129, P. 19-21

Company HOPE NATURAL GAS CO.
 Address CLARKSBURG, W. VA.
 Farm MAXWELL BROS.
 Tract _____ Acres 318 Lease No. 37961
 Well (Farm) No. _____ Serial No. 6162-6333
 Elevation (Spirit Level) AS SHOWN
 Quadrangle HOLBROOK
 County RITCHIE District MURPHY
 Engineer Sam H. Bradley
 Engineer's Registration No. 2425
 File No. _____ Drawing No. _____
 Date MAY 12, 1955 Scale 1" = 30 P.

STATE OF WEST VIRGINIA
 DEPARTMENT OF MINES
 OIL AND GAS DIVISION
 CHARLESTON

WELL LOCATION MAP
 FILE NO. Rit-1243-A-#6395

+ Denotes location of well on United States Topographic Maps, scale 1 to 62,500, latitude and longitude lines being represented by border lines as shown.
 - Denotes one inch spaces on border line of original tracing.

MAXWELL BROS #6395 HOPE N G CO RIT-1243-A



STATE OF WEST VIRGINIA
DEPARTMENT OF MINES
OIL AND GAS DIVISION

1160

Quadrangle Holbrook
Permit No. 1242A

WELL RECORD


Oil or Gas Well Gas
(KIND)

Company Hope Natural Gas Company
Address 445 West Main St., Clarksburg, W. Va.
Farm Maxwell Heirs (Bros) Acres 318
Location (waters) _____
Well No. 6395 Elev. 1037
District Murphy County Ritchie
The surface of tract is owned in fee by _____
Address _____
Mineral rights are owned by _____
Address _____
Drilling commenced 10-18-23
Drilling completed 11-17-23
Date Shot 2-18-41 From 1941 To 2029
With 105 Qts.
Open Flow _____ /10ths Water in _____ Inch
_____ /10ths Merc. in _____ Inch
Volume _____ Cu. Ft.
Rock Pressure _____ lbs. _____ hrs.
Oil None bbls., 1st 24 hrs.
Fresh water None Recorded feet _____ feet
Salt water 1420' feet _____ feet

Casing and Tubing	Used in Drilling	Left in Well	Packers
Size			
16			Kind of Packer
13			
10			Size of
8 1/4	<u>495'</u>	<u>344'</u>	<u>Artin</u>
6 5/8	<u>1098'</u>	<u>1116'</u>	Depth set
5 3/16	<u>1884'</u>	<u>1884'</u>	
3	<u>1879-9'</u>		Perf. top
2			Perf. bottom
Liners Used			Perf. top
			Perf. bottom

CASING CEMENTED _____ SIZE _____ No. Ft. _____ Date _____
No Cementing
COAL WAS ENCOUNTERED AT _____ FEET _____ INCHES
No Coal
_____ FEET _____ INCHES FEET _____ INCHES
_____ FEET _____ INCHES FEET _____ INCHES

Formation	Color	Hard or Soft	Top	Bottom	Oil, Gas or Water	Depth Found	Remarks
Little Dunkard			1000	1015			
Big Dunkard			1070	1080			
Gas Sand			1130	1260			
First Salt			1280	1490			
2nd Salt			1540	1590			
MAXON			1690	1720			
Little Lime			1855	1871			
Blue Monday			1871	1875			
Pencil Cave			1875	1884			
BIG LIME			1884	1940			
BIG INJUN			1940	2000			
					<u>1420 Salt Water</u>		
					<u>Gas</u>	<u>1942-60-82</u>	
Total Depth				2031'			

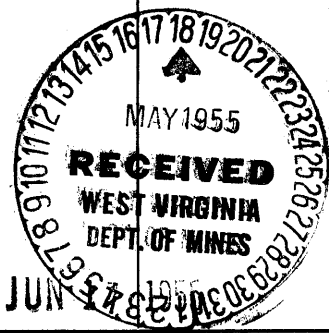

Formation	Color	Hard or Soft	Top	Bottom	Oil, Gas or Water	Depth Found	Remarks

Date **May 12,** _____, 19 **55**

APPROVED **Hope Natural Gas Company**, Owner

By _____ (Title) *Bailey*