

New Location...
 Drill Deeper.....
 Abandonment.....

JAN 16 1956

Company Pierson, Feick Skidmore, & Feick
 Address % Clyde Pierson, Walker W.Va R2
 Farm Kate McCollum
 Tract _____ Acres 118 3/8 Lease No. _____
 Well (Farm) No. 1 Serial No. _____
 Elevation (Spirit Level) 712'
 Quadrangle Harrisville
 County Ritchie District Grant
 Engineer Robert R. Anderson
 by O. Meredith
 Engineer's Registration No. 296
 File No. _____ Drawing No. _____
 Date 4/9 56 Scale 1 in = 30 Poles

STATE OF WEST VIRGINIA
 DEPARTMENT OF MINES
 OIL AND GAS DIVISION
 CHARLESTON

WELL LOCATION MAP
 FILE NO. RT-1249-A

+ Denotes location of well on United States Topographic Maps, scale 1 to 62,500, latitude and longitude lines being represented by border lines as shown.
 - Denotes one inch spaces on border line of original tracing.



STATE OF WEST VIRGINIA
DEPARTMENT OF MINES
OIL AND GAS DIVISION

1106

Quadrangle _____

WELL RECORD

Permit No. 12114


Oil or Gas Well _____
(KIND)

Company Siersol, Reick, Sidmore & Reick
 Address Sulker, Rt 2, VA
 Farm Gate, No. Collum Acres 118 7/10
 Location (waters) Runnes River, north fork
 Well No. 1. Elev. 712'
 District Grant County Ritchie
 The surface of tract is owned in fee by ROY, ONEY PENNY
Cairo W. Va. Address _____
 Mineral rights are owned by SAME
 Address _____
 Drilling commenced about 1930
 Drilling completed about same
 Date Shot From _____ To _____
 With _____
 Open Flow /10ths Water in _____ Inch
 /10ths Merc. in _____ Inch
 Volume _____ Cu. Ft.
 Rock Pressure _____ lbs. _____ hrs.
 Oil _____ bbls., 1st 24 hrs.
 Fresh water _____ feet _____ feet
 Salt water _____ feet _____ feet

Casing and Tubing	Used in Drilling	Left in Well	Packers
Size			Kind of Packer
16			
13			
10			Size of
8 3/4	350	none	
6 3/8	1250	1250	Depth set
5 3/16			
3			Perf. top
2			Perf. bottom
Liners Used			Perf. top
			Perf. bottom

CASING CEMENTED _____ SIZE _____ No. Ft. _____ Date _____
 COAL WAS ENCOUNTERED AT _____ FEET _____ INCHES
 _____ FEET _____ INCHES _____ FEET _____ INCHES
 _____ FEET _____ INCHES _____ FEET _____ INCHES

Formation	Color	Hard or Soft	Top	Bottom	Oil, Gas or Water	Depth Found	Remarks
clay & red rock			000	850'			
red cave			850'	950'			
shale & slate			950'	1250'			
big lime			1250	1325'			
slate & shale			1325'	1500'			
first salt sand & third			1500'	1610'			
shale			1610'	1750'			
maxon sand			1750'	1774'			
			total depth	1774'			

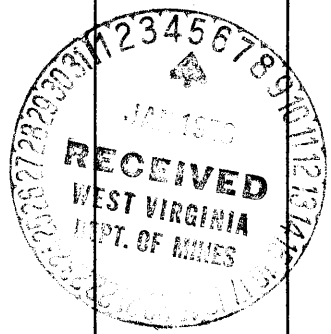

JUNE 21 1956

Formation	Color	Hard or Soft	Top	Bottom	Oil, Gas or Water	Depth Found	Remarks

Date 1 3, 1916

APPROVED Piersol, Frank, & Fuchs, Owner

By E R Piersol