

#1 0.3W
 4.0 @
 #2 0.119 W
 3.93 @

MAR 26 1956

New Location...
 Drill Deeper.....
 Abandonment.....

Company Piersol, Feick Skidmore & Feick
 Address R2 Walker, W.Va.
 Farm Sarah McKinney
 Tract _____ Acres 84 3/4 Lease No. _____
 Well (Farm) No. Land 2 Serial No. _____
 Elevation (Spirit Level) #1-762' #2-770'
 Quadrangle Harrisville
 County Ritchie District Grant
 Engineer Robert R. Anderson
 Engineer's Registration No. 296
 File No. _____ Drawing No. _____
 Date March 6, 1956 Scale 1 in = 30 poles

STATE OF WEST VIRGINIA
 DEPARTMENT OF MINES
 OIL AND GAS DIVISION
 CHARLESTON

WELL LOCATION MAP
 FILE NO. Rit-1255-A-#1
Rit-1256-A-#2

+ Denotes location of well on United States Topographic Maps, scale 1 to 62,500, latitude and longitude lines being represented by border lines as shown.

- Denotes one inch spaces on border line of original tracing.

SARAH MCKINNEY NOS. 1 & 2 - PIERSOL, FEICK, SKIDMORE & FEICK - RIT-1255-56A



STATE OF WEST VIRGINIA
DEPARTMENT OF MINES
OIL AND GAS DIVISION

1115

Quadrangle _____

WELL RECORD

Permit No. _____

Oil or Gas Well _____
(KIND)


Company Piersol, Peick, Skidmore & Peick
 Address Walker, rt, 2 NVA
 Farm Sarah, Mc Henry Acres 84.3/4
 Location (waters) Hughes, River
 Well No. 2 Elev. 770
 District Grant County Ritchie
 The surface of tract is owned in fee by Fred, Bausher
Cairo W.VA Address _____
 Mineral rights are owned by N.A. Welch
Parkersburg, W.VA Address _____
 Drilling commenced about 1903
 Drilling completed same
 Date Shot From _____ To _____
 With _____
 Open Flow /10ths Water in _____ Inch
 /10ths Merc. in _____ Inch
 Volume _____ Cu. Ft.
 Rock Pressure _____ lbs. _____ hrs.
 Oil _____ bbls., 1st 24 hrs.
 Fresh water _____ feet _____ feet
 Salt water _____ feet _____ feet

Casing and Tubing	Used in Drilling	Left in Well	Packers
Size			Kind of Packer
16			
13			
10	255'	none	Size of
8 3/4	800'	none	
6 1/4	1312	1312	Depth set
5 3/16			
3			Perf. top
2	1730	1730	Perf. bottom
Liners Used			Perf. top
			Perf. bottom

CASING CEMENTED _____ SIZE _____ No. Ft. _____ Date _____

COAL WAS ENCOUNTERED AT _____ FEET _____ INCHES
 _____ FEET _____ INCHES _____ FEET _____ INCHES
 _____ FEET _____ INCHES _____ FEET _____ INCHES

Formation	Color	Hard or Soft	Top	Bottom	Oil, Gas or Water	Depth Found	Remarks
clay & red rock			000	955'			
red cave			955'	1055			
shale & slate			1055	1355			
lime			1355'	1430'			
slate & shale			1430'	1610'			
first & third salt sand			1610'	1730'			
			total depth	1730'			

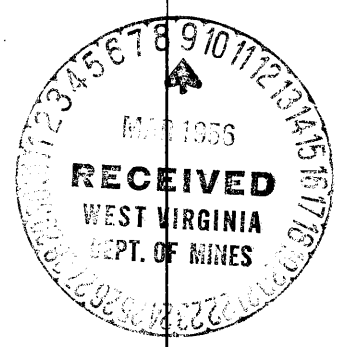

JUNE 21 1956

Formation	Color	Hard or Soft	Top	Bottom	Oil, Gas or Water	Depth Found	Remarks

Date 3-6 1956, 19

APPROVED Piersol, Feick, & Feick, Owner

By E. R. Piersol
(Title)