

Surface owned by J.A. Statler et al.  
 Address: Mr. J.A. Statler, Pennsboro, W. Va.  
 No Coal.

New Location..   
 Drill Deeper.....   
 Abandonment.....

DEC. 26 1956

*Handwritten signatures and initials:*  
 J.R.M.  
 1.42

Company James R. Moses  
 Address Salem, W. Va.  
 Farm George C. Boyce  
 Tract \_\_\_\_\_ Acres 40 Lease No. \_\_\_\_\_  
 Well (Farm) No. L Serial No. \_\_\_\_\_  
 Elevation (Spirit Level) Floor -- 1061.49  
Ground - 1058.64  
 Quadrangle West Union  
 County Ritchie District Clay  
 Engineer Elsworth Haines  
 Engineer's Registration No. 2221  
 File No. \_\_\_\_\_ Drawing No. \_\_\_\_\_  
 Date Nov. 30th, 1956 Scale 1" = 500 Feet

STATE OF WEST VIRGINIA  
 DEPARTMENT OF MINES  
 OIL AND GAS DIVISION  
 CHARLESTON

**WELL LOCATION MAP**  
 FILE NO. Rit-1267-B

+ Denotes location of well on United States Topographic Maps, scale 1 to 62,500, latitude and longitude lines being represented by border lines as shown.

- Denotes one inch spaces on border line of original tracing.

GEORGE C. BOYCE No. 1 — JAMES R. MOSES — RIT-1267-B



1121

STATE OF WEST VIRGINIA  
DEPARTMENT OF MINES  
OIL AND GAS DIVISION

Quadrangle West Union

Permit No. 1767A

WELL RECORD

Oil or Gas Well X (KIND)

Company James R. Moses  
Address Salem, West Virginia  
Farm George C. Boyce Acres 40  
Location (waters) Charley's Run  
Well No. 1 Elev. 1061.49'  
District Clay County Ritchie  
The surface of tract is owned in fee by J. A. Statler et al  
Pennsboro, W. Va. Address \_\_\_\_\_  
Mineral rights are owned by \_\_\_\_\_  
Address \_\_\_\_\_


Casing and Tubing	Used in Drilling	Left in Well	Packers
Size			Kind of Packer
16			
13			
10	14'	14'	Size of
8 1/4	350'	350'	
6 5/8	1220'	1220'	Depth set
5 3/16	1927'	1927'	
3			Perf. top
2	1970'	1970'	Perf. bottom
Liners Used			Perf. top
			Perf. bottom

Drilling commenced \_\_\_\_\_  
Drilling completed 1930  
Date Shot From 2061' To 2071'  
With 30 qts Glycerin  
Open Flow /10ths Water in \_\_\_\_\_ Inch  
/10ths Merc. in \_\_\_\_\_ Inch  
Volume \_\_\_\_\_ Cu. Ft.  
Rock Pressure \_\_\_\_\_ lbs. \_\_\_\_\_ hrs.  
Oil \_\_\_\_\_ bbls., 1st 24 hrs.  
WELL ACIDIZED \_\_\_\_\_  
WELL FRACTURED \_\_\_\_\_


CASING CEMENTED \_\_\_\_\_ SIZE \_\_\_\_\_ No. Ft. \_\_\_\_\_ Date \_\_\_\_\_  
COAL WAS ENCOUNTERED AT \_\_\_\_\_ FEET \_\_\_\_\_ INCHES  
\_\_\_\_\_ FEET \_\_\_\_\_ INCHES \_\_\_\_\_ FEET \_\_\_\_\_ INCHES  
\_\_\_\_\_ FEET \_\_\_\_\_ INCHES \_\_\_\_\_ FEET \_\_\_\_\_ INCHES

RESULT AFTER TREATMENT \_\_\_\_\_  
ROCK PRESSURE AFTER TREATMENT \_\_\_\_\_  
Fresh Water \_\_\_\_\_ Feet \_\_\_\_\_ Salt Water \_\_\_\_\_ Feet \_\_\_\_\_

Formation	Color	Hard or Soft	Top	Bottom	Oil, Gas or Water	Depth	Remarks
Pittsburgh Coal			700	701			
Slate			701	707			
Lime			707	725			
Slate			725	772			
Red Rock			772	802			
Lime			802	---			
Cow Run			1080	---			
Slate			1080	1128			
Gas Sand			1128	1168			
Slate			1168	1188			
Red Rock			1188	1193			
Lime			1195	1200			
Sandy Slate			1200	1252			
FIRST SALT SAND			1252	1400			
Blue Slate			1400	1402			
Sand			1402	1407			
Slate			1407	1431			
Sand			1431	1445			
Black Slate			1445	1455			
Lime			1455	1460			
Blue Slate			1460	1505			
Lime			1505	1515			
Sand			1515	1545			
Slate			1545	1555			
THIRD SALT SAND			1555	1600			
Sandy Slate			1600	1635			
Black Slate			1635	1645			
Sand			1645	1660			
Black Slate			1660	1725			
Sandy Lime			1725	1730			

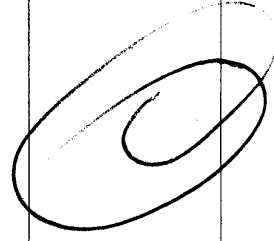

Little water at 1350'

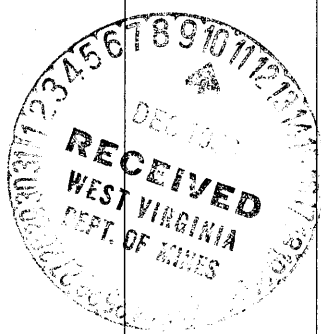

Formation	Color	Hard or Soft	Top	Bottom	Oil, Gas or Water	Depth Found	Remarks
Slate			1730	1731			
Sand			1731	1746			
Black Slate			1746	1750			
Sand			1750	1824			
MAXTON SAND			1824	1845	Show of Oil - SLM		
Black Slate			1845	1855			
LITTLE LIME			1855	1870			
Blue Slate			1870	1880			
BIG LIME			1880	1985			
Top of Big Injun			1998				
Break of Slate			2020	2027	First Gas (SLM) 2061 to 2064'		
Break			2064	2066			
Sand			2066	2072	Gas		
Bottom of Injun			2101				
Break			2101	2102			
Squaw Sand			2102	2112			
Black Slate			2112	2125			
Total Depth				2125			

Date \_\_\_\_\_, 19\_\_\_\_

APPROVED \_\_\_\_\_, Owner

By \_\_\_\_\_  
(Title)