

Company	<u>HOPE NATURAL GAS CO.</u>		
Address	<u>CLARKSBURG, W.VA.</u>		
Farm	<u>W.A. BEALL</u>		
Tract	Acres	Lease No.	
	<u>338</u>	<u>19907</u>	
Well (Farm) No.	Serial No.		
	<u>6280</u>		
Elevation (Spirit Level)	<u>1221'</u>		
Quadrangle	<u>HOLBROOK</u>		
County	District		
<u>RITCHIE</u>	<u>MURPHY</u>		
Engineer	<u>Guy H. Bradley</u>		
Engineer's Registration No.	<u>2425</u>		
File No.	Drawing No.		
Date	Scale		
<u>9/16/57</u>	<u>1" = 50 P.</u>		

STATE OF WEST VIRGINIA  
DEPARTMENT OF MINES  
OIL AND GAS DIVISION  
CHARLESTON

**WELL LOCATION MAP**  
FILE NO. Rit-1274-A

+ Denotes location of well on United States Topographic Maps, scale 1 to 62,500, latitude and longitude lines being represented by border lines as shown.

- Denotes one inch spaces on border line of original tracing.



1120

STATE OF WEST VIRGINIA  
DEPARTMENT OF MINES  
OIL AND GAS DIVISION

*Ho Brook*

Quadrangle \_\_\_\_\_

Perm. No. *1274 A*

WELL RECORD

Oil or Gas Well Gas  
(KIND)

Company Hope Natural Gas Company  
Address Clarksburg, W. Va.  
Farm W. A. Beall Acres 338

Location (waters) \_\_\_\_\_  
Well No. 6280 Elev. 1221  
District Murphy County Ritchie

The surface of tract is owned in fee by \_\_\_\_\_  
Address \_\_\_\_\_

Mineral rights are owned by \_\_\_\_\_  
Address \_\_\_\_\_

Drilling commenced 3-28-23

Drilling completed 4-28-23

Date Shot 6-1-23 From Berea To \_\_\_\_\_

With 30 Qts.

Open Flow /10ths Water in \_\_\_\_\_ Inch

/10ths Merc. in \_\_\_\_\_ Inch

Volume Original Test ~~XXXXX~~ 134.4 M Cu. Ft.

Rock Pressure Orig. 500# lbs. \_\_\_\_\_ hrs.

Oil \_\_\_\_\_ bbls., 1st 24 hrs.

WELL ACIDIZED No

WELL FRACTURED No

Casing and Tubing	Used in Drilling	Left in Well	Packers
Size			Kind of Packer _____
16			
13			
10			Size of _____
8 3/4	<u>475</u>	<u>Pulled</u>	
6 5/8	<u>1261</u>	<u>1261</u>	Depth set _____
5 3/16	<u>2045</u>	<u>2045</u>	
3			Perf. top _____
2			Perf. bottom _____
Liners Used			Perf. top _____
			Perf. bottom _____

CASING CEMENTED \_\_\_\_\_ SIZE \_\_\_\_\_ No. Ft. \_\_\_\_\_ Date \_\_\_\_\_

No Cementing

COAL WAS ENCOUNTERED AT \_\_\_\_\_ FEET \_\_\_\_\_ INCHES

No Coal

\_\_\_\_\_ FEET \_\_\_\_\_ INCHES \_\_\_\_\_ FEET \_\_\_\_\_ INCHES



\_\_\_\_\_ FEET \_\_\_\_\_ INCHES \_\_\_\_\_ FEET \_\_\_\_\_ INCHES

RESULT AFTER TREATMENT \_\_\_\_\_

ROCK PRESSURE AFTER TREATMENT \_\_\_\_\_

Fresh Water No Record Feet \_\_\_\_\_ Salt Water \_\_\_\_\_ Feet \_\_\_\_\_

Formation	Color	Hard or Soft	Top	Bottom	Oil, Gas or Water	Depth	Remarks
Big Dunkard			1086	1123			
Gas Sand			1237	1322	Gas	1316	Smell
1st Salt Sand			1650	1796'	Gas	Salt Sand	
2nd Salt			1808	1822			
Maxon			1938	1969			
Little Lime			1986	2007			
Pencil Cave			2007	2016			
Big Lime			2016	2094			
BIG INJUN			2094	2138			
BEREA			2500	2510	Gas	2506-10	

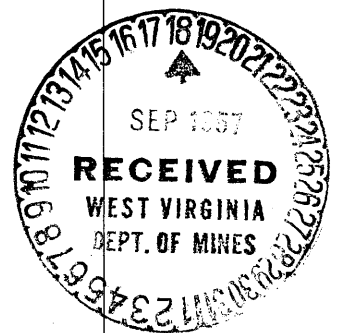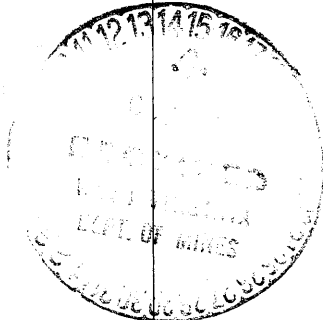

September 10, 1957  
B. R. NUZUM  
General Superintendent

By *Wiley*

DEC 6 1957 Hope Natural Gas Company