

New Location
 Drill Deeper
 Abandonment

APR 12 1959

Formerly Hope Natural Gas Co. Well No 6826

392 W
 5.77 R

Company LURAY LAND, INC.
 Address POINT PLEASANT, W. VA.
 Farm W.F. SNODGRASS
 Tract _____ Acres 106 Lease No. _____
 Well (Farm) No. 1 Serial No. 6826
 Elevation (Spirit Level) 845'
 Quadrangle HOLBROOK
 County RITCHIE District MURPHY
 Engineer H.P. SUTER
 Engineer's Registration No. 1805
 File No. _____ Drawing No. _____
 Date 22 MAR. 1959 Scale 1" = 30 POLES.

STATE OF WEST VIRGINIA
 DEPARTMENT OF MINES
 OIL AND GAS DIVISION
 CHARLESTON

WELL LOCATION MAP
 FILE NO. RIT-1292-A

+ Denotes location of well on United States Topographic Maps, scale 1 to 62,500, latitude and longitude lines being represented by border lines as shown.
 - Denotes one inch spaces on border line of original tracing.

W.F. SNODGRASS No. 1 (6826) - LURAY LAND INC - RIT-1292-A



1143

STATE OF WEST VIRGINIA
DEPARTMENT OF MINES
OIL AND GAS DIVISION

Quadrangle Holbrook
Permit No. Rit-1292-A

WELL RECORD

Oil or Gas Well X (KIND)


Company Hope Natural Gas Company
Address Clarksburg, West Virginia
Farm W. F. Snodgrass Acres 106
Location (waters) _____
Well No. 6826 (1) Elev. 945
District Murphy County Ritchie
The surface of tract is owned in fee by _____
Address _____
Mineral rights are owned by _____
Address _____
Drilling commenced Sept. 1926
Drilling completed Feb. 23, 1927
Date Shot _____ From _____ To _____
With _____
Open Flow _____ /10ths Water in _____ Inch
_____ /10ths Merc. in _____ Inch
Volume _____ Cu. Ft.
Rock Pressure _____ lbs. _____ hrs.
Oil _____ bbls., 1st 24 hrs.
WELL ACIDIZED _____
WELL FRACTURED _____

Casing and Tubing	Used in Drilling	Left in Well	Packers
Size			Kind of Packer _____
16			
13			
10	214	Pulled	Size of _____
8 1/4	1006	Pulled	
6 3/8	1725	1725	Depth set _____
5 3/16			
3			Perf. top _____
2	1875	1875	Perf. bottom _____
Liners Used			Perf. top _____
			Perf. bottom _____

CASING CEMENTED _____ SIZE _____ No. Ft. _____ Date _____
COAL WAS ENCOUNTERED AT _____ FEET _____ INCHES
_____ FEET _____ INCHES FEET _____ INCHES
_____ FEET _____ INCHES FEET _____ INCHES

RESULT AFTER TREATMENT _____
ROCK PRESSURE AFTER TREATMENT _____
Fresh Water _____ Feet Salt Water _____ Feet

Formation	Color	Hard or Soft	Top	Bottom	Oil, Gas or Water	Depth	Remarks
Little Dunkard Sand			715	730			
Big Dunkard Sand			810	840			
1st Salt Sand			1075	1225		Gas at 1500	
2nd Salt Sand			1425	1530		Gas at 1566	
Maxon Sand			1545	1589			
Big Lime			1687	1757			
Injun Sand			1757	1845		Gas at 1775-1783 1815-1825 1847-1845	
Total Depth				1880			

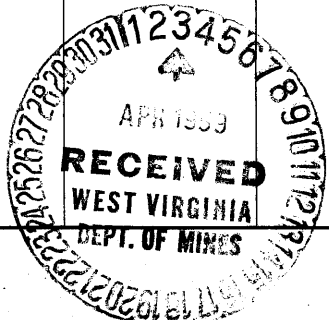

JUL 23 1959

Formation	Color	Hard or Soft	Top	Bottom	Oil, Gas or Water	Depth Found	Remarks

Date **March 5,** 19**59**

APPROVED **LuRay Land, Inc.** Owner
 By *Byron M. Finch*
Byron M. Finch (Title) **Consultant**