

New Location   
 Drill Deeper   
 Abandonment

Formerly Hope Natural Gas Co. Well N° 6254

Company LURAY LAND, INC.  
 Address POINT PLEASANT, W. VA.  
 Farm MAXWELL BROS.  
 Tract            Acres 461 Lease No.             
 Well (Farm) No. 1 Serial No.             
 Elevation (Spirit Level) 968'  
 Quadrangle HOLBROOK  
 County RITCHIE District UNION  
 Engineer H. P. SUTER  
 Engineer's Registration No. 1805  
 File No.            Drawing No.             
 Date 24 MAR. 1959 Scale 1" = 50 POLES

STATE OF WEST VIRGINIA  
 DEPARTMENT OF MINES  
 OIL AND GAS DIVISION  
 CHARLESTON

**WELL LOCATION MAP**  
 FILE NO. Rit-1293-A

+ Denotes location of well on United States Topographic Maps, scale 1 to 62,500, latitude and longitude lines being represented by border lines as shown.  
 - Denotes one inch spaces on border line of original tracing.

MAXWELL BROS. No. 1 (675A) - LURAY LAND, INC. - RIT-1293-A



1141

STATE OF WEST VIRGINIA  
DEPARTMENT OF MINES  
OIL AND GAS DIVISION

Quadrangle Holbrook

Permit No. 1293A

WELL RECORD

~~Oil~~ or Gas Well \_\_\_\_\_ (KIND)


Company Hope Natural Gas Company  
Address Clarksburg, West Virginia  
Farm Maxwell Heirs Acres 46  
Location (waters) \_\_\_\_\_  
Well No. 6254 Elev. 968  
District Union County Ritchie  
The surface of tract is owned in fee by \_\_\_\_\_  
Address \_\_\_\_\_  
Mineral rights are owned by \_\_\_\_\_  
Address \_\_\_\_\_


Casing and Tubing	Used in Drilling	Left in Well	Packers
Size			Kind of Packer
16			
13			
10			Size of
8 1/4			
6 5/8	1116'	1116'	Depth set
5 3/16	1868'	1868'	
3			Perf. top
2	1928'	1928'	Perf. bottom
Liners Used			Perf. top
			Perf. bottom

Drilling commenced Dec. 18, 1922  
Drilling completed Mar. 19, 1923  
Date Shot 10-22-27 From Injun To \_\_\_\_\_  
With \_\_\_\_\_  
Open Flow /10ths Water in \_\_\_\_\_ Inch  
/10ths Merc. in \_\_\_\_\_ Inch  
Volume \_\_\_\_\_ Cu. Ft.  
Rock Pressure \_\_\_\_\_ lbs. \_\_\_\_\_ hrs.  
Oil \_\_\_\_\_ bbls., 1st 24 hrs.  
WELL ACIDIZED \_\_\_\_\_  
WELL FRACTURED \_\_\_\_\_

CASING CEMENTED \_\_\_\_\_ SIZE \_\_\_\_\_ No. Ft. \_\_\_\_\_ Date \_\_\_\_\_  
COAL WAS ENCOUNTERED AT \_\_\_\_\_ FEET \_\_\_\_\_ INCHES  
\_\_\_\_\_ FEET \_\_\_\_\_ INCHES FEET \_\_\_\_\_ INCHES  
\_\_\_\_\_ FEET \_\_\_\_\_ INCHES FEET \_\_\_\_\_ INCHES

RESULT AFTER TREATMENT \_\_\_\_\_  
ROCK PRESSURE AFTER TREATMENT \_\_\_\_\_  
Fresh Water \_\_\_\_\_ Feet Salt Water \_\_\_\_\_ Feet

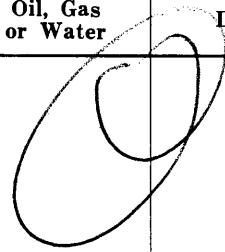Formation	Color	Hard or Soft	Top	Bottom	Oil, Gas or Water	Depth	Remarks
L. Dunkard			800	820	 Gas at 1876-79 1876-91		
B. Dunkard			950	963			
Gas Sand			995	1010			
Sand			1115	1135			
1st Salt Sand			1380	1415			
2nd Salt Sand			1625	1680			
Maxon Sand			1730	1745			
Sand			1805	1825			
Big Line			1825	1876			
Injun Sand			1876	1895			

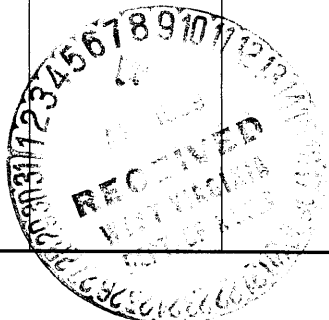

Formation	Color	Hard or Soft	Top	Bottom	Oil, Gas or Water	Depth Found	Remarks

Date **March 5,** 19**59**

**Lutay Land, Inc.**, Owner

APPROVED *Byron M. Finch*

By **Byron M. Finch** (Title) **Consultant**