

Company Loris Swadley et al., C.I. Collins Agt.  
 Address Pennsboro, W. Va.  
 Farm Ritchie Co. Agricultural Fair Assn.  
 Tract 1 Acres 33 Lease No. \_\_\_\_\_  
 Well (Farm) No. 1 Serial No. \_\_\_\_\_  
 Elevation (Spirit Level) 795'  
 Quadrangle West Union  
 County Ritchie District Clay  
 Engineer Parker E. Peters  
 Field - W.P. Ireland  
 Engineer's Registration No. 435  
 File No. \_\_\_\_\_ Drawing No. \_\_\_\_\_  
 Date Aug. 19, 1959 Scale 1" = 20 P.

STATE OF WEST VIRGINIA  
 DEPARTMENT OF MINES  
 OIL AND GAS DIVISION  
 CHARLESTON

WELL LOCATION MAP  
 FILE NO. Rit-1304-A

+ Denotes location of well on United States Topographic Maps, scale 1 to 62,500, latitude and longitude lines being represented by border lines as shown.  
 - Denotes one inch spaces on border line of original tracing.

LORIS SWADLEY ET AL -  
 RITCHIE CO. AGR. FAIR ASSN 06-1 - (C.I. COLLINS AGENT) - RIT 1218-A



1153

STATE OF WEST VIRGINIA  
DEPARTMENT OF MINES  
OIL AND GAS DIVISION

Quadrangle West Union

Permit No. 1304A

WELL RECORD

Oil or Gas Well Gas  
(KIND)

Company Louis Shelley et al (G.I. Collins)  
Address ...  
Farm Richie Co. Agricultural Fair Assn.  
Location (waters) ...  
Well No. ... Elev. ...  
District Clay County Richie  
The surface of tract is owned in fee by ...  
Mineral rights are owned by ...

Casing and Tubing	Used in Drilling	Left in Well	Packers
Size			Kind of Packer
16			
13			Anchor packer
10	1000'		Size of
8 3/4	170'		
6 5/8	1000'	1000'	Depth set 1240'
5 3/16			
3			Perf. top
2	1140'	1240'	Perf. bottom
Liners Used			Perf. top
			Perf. bottom

Drilling commenced ...  
Drilling completed June 22, 1959  
Date Shot ... From ... To ...  
With ...  
Open Flow ... /10ths Water in ... Inch  
... /10ths Merc. in ... Inch  
Volume ... Cu. Ft.  
Rock Pressure ... lbs. ... hrs.  
Oil ... bbls., 1st 24 hrs.

CASING CEMENTED 3/5/8 SIZE 1691' No. Ft. ... Date ...


COAL WAS ENCOUNTERED AT 1197 FEET ... INCHES  
... FEET ... INCHES ... FEET ... INCHES  
... FEET ... INCHES ... FEET ... INCHES

WELL ACIDIZED ...  
WELL FRACTURED ...  
RESULT AFTER TREATMENT ...  
ROCK PRESSURE AFTER TREATMENT ...  
Fresh Water ... Feet ... Salt Water ... Feet ...

Formation	Color	Hard or Soft	Top	Bottom	Oil, Gas or Water	Depth	Remarks
Water			25'				
Pittsburg Coal			485'	450'			
Sand			610	575			
Little Duncard			790	810			
Big			800	825			
Coal			1107	1112			
1st Salt			1112	1180			
2nd			1180	1300			
Maxon			1315	1345			
Pencil Cave			1368	1675			
Big Line			1375	1700			
Injun Sand			1750	1730 1860'			
					Gas	1242	
					total depth	1297	

This is all the record available for this well

NOV 5 1959

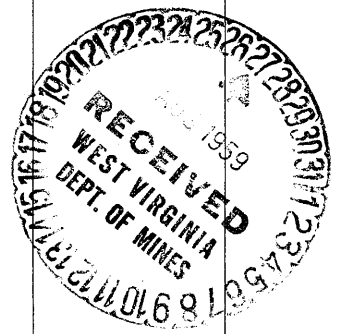

Formation	Color	Hard or Soft	Top	Bottom	Oil, Gas or Water	Depth Found	Remarks

Date August 19 -, 1917  
 APPROVED Lucia J. Swadby and  
Hilchie Co. Agricultural, Owner  
Fair Assn.  
 By M. P. Ireland Surveyor  
 (Title)