


Latitude 39° 15'

Longitude 81° 05'

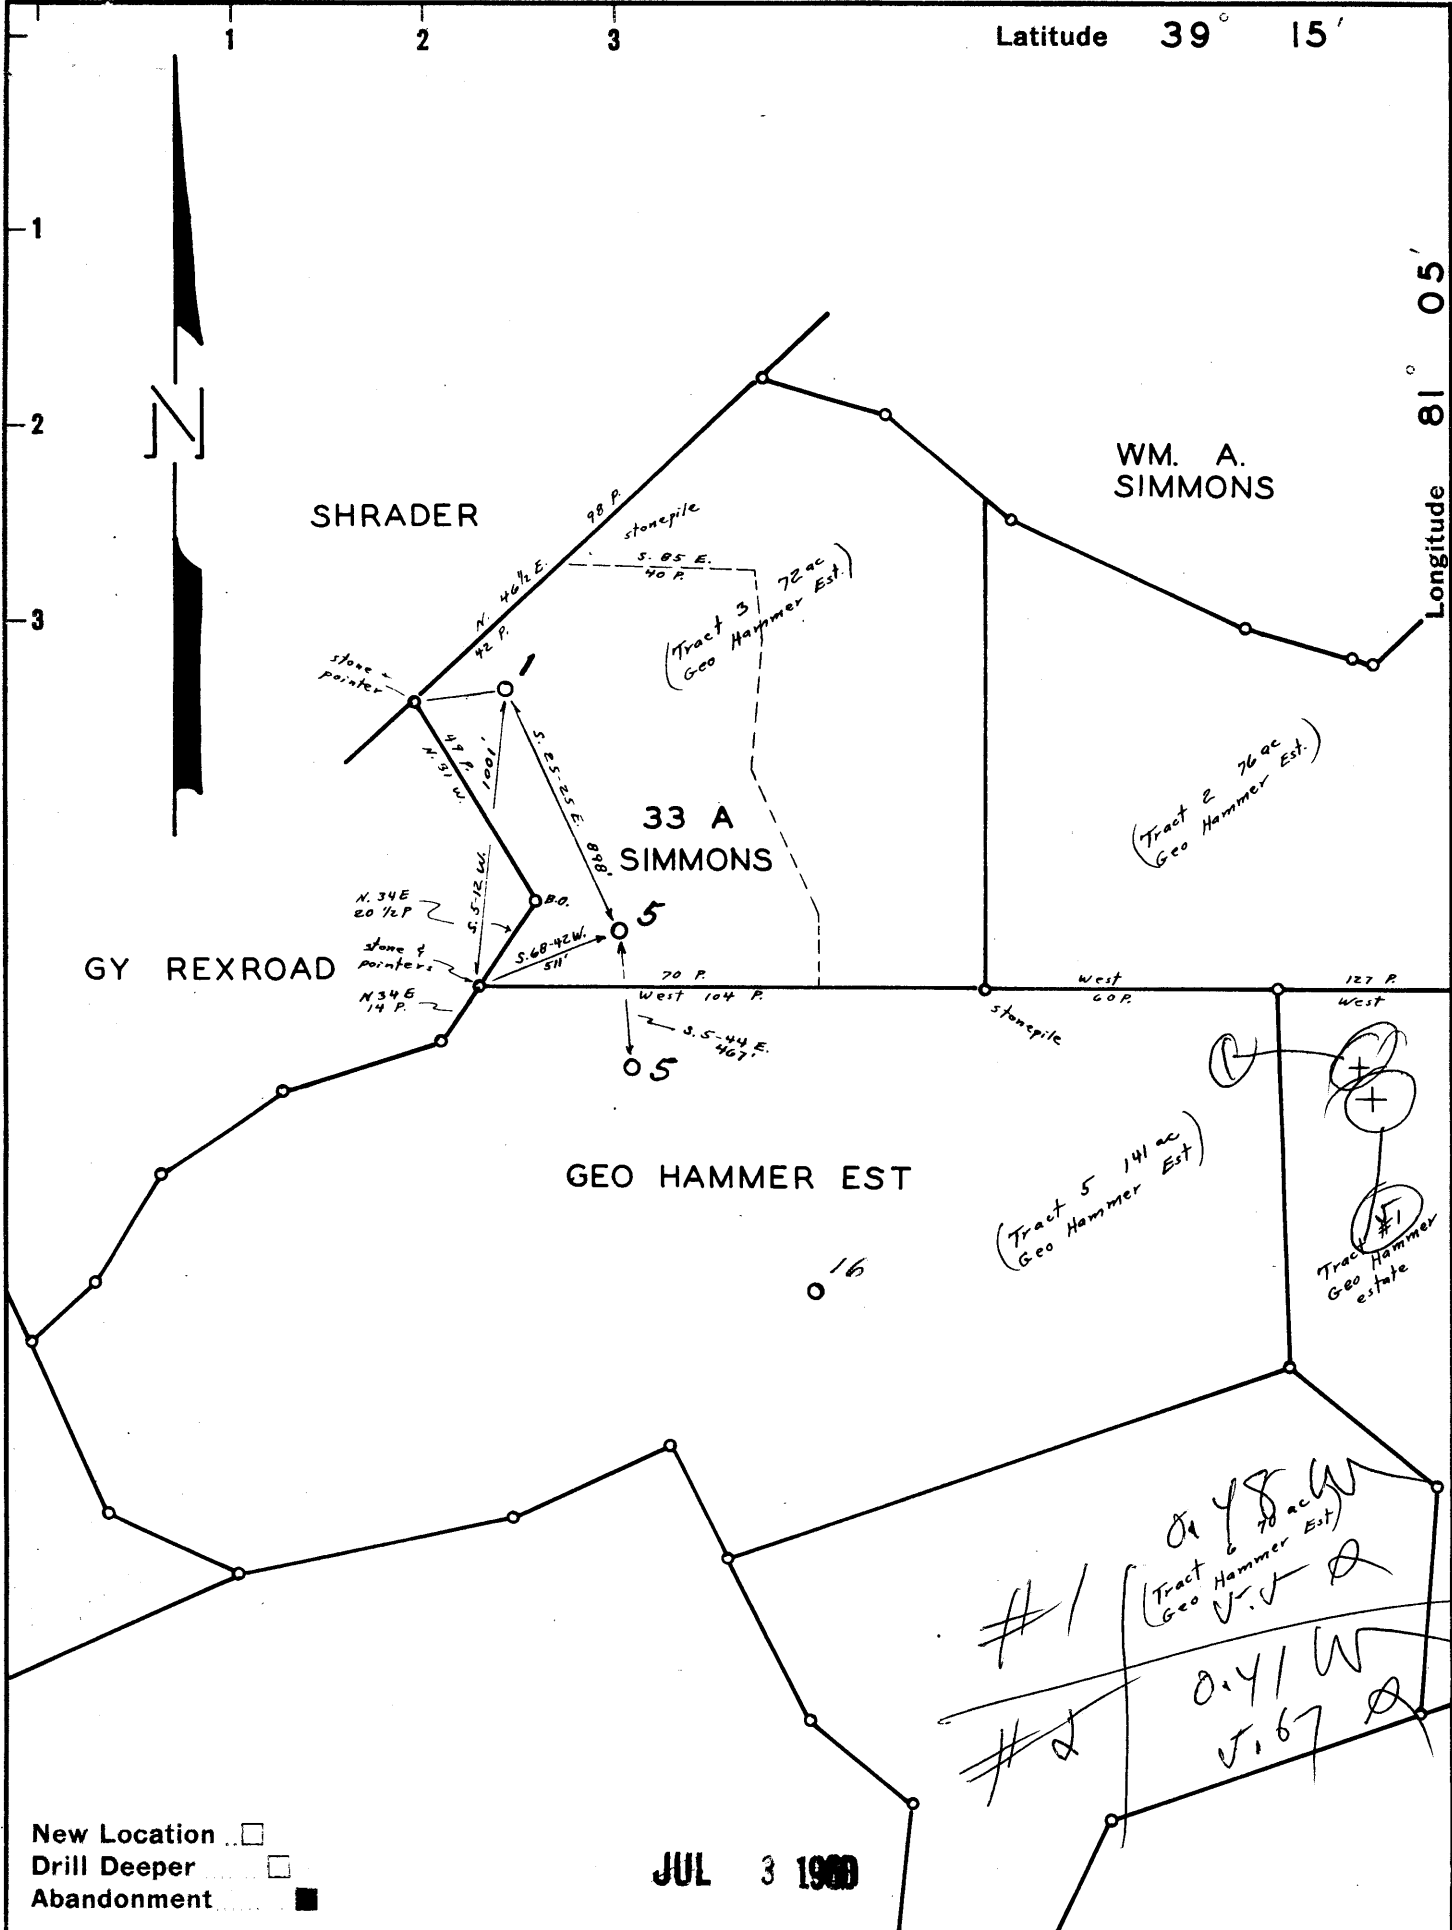

New Location

Drill Deeper

Abandonment

JUL 3 1960

Company HANLON OIL COMPANY

Address SISTERSVILLE, W. VA.

Farm CHARLEY E. SIMMONS

Tract _____ Acres 33 Lease No. _____

Well (Farm) No. 1 & 5 Serial No. _____

Elevation (Spirit Level) 1179 & 1122

Quadrangle HARRISVILLE, W. VA.

County RITCHIE District MURPHY

Engineer M.B. GOAD

Engineer's Registration No. IND 4040

File No. _____ Drawing No. _____

Date JUNE 1960 Scale 1" = 40 P.

STATE OF WEST VIRGINIA
DEPARTMENT OF MINES
OIL AND GAS DIVISION
CHARLESTON

WELL LOCATION MAP

FILE NO. RIT - 1315-A #1
Rit - 1316-A - #5

+ Denotes location of well on United States Topographic Maps, scale 1 to 62,500, latitude and longitude lines being represented by border lines as shown.

- Denotes one inch spaces on border line of original tracing.

CHARLEY E. SIMMONS NO. 1 & 5 - HANLON OIL CO. - RIT-1315-16-A



1172

STATE OF WEST VIRGINIA
DEPARTMENT OF MINES
OIL AND GAS DIVISION

Quadrangle Harrisville, W. Va.

Permit No. 1316A

WELL RECORD

Oil or Gas Well _____ (KIND)

Company Hanlon Oil Company
 Address Sistersville, W. Va.
 Farm C. E. Simmons Acres 33
 Location (waters) _____
 Well No. 5 Elev. 1122
 District Murphy County Ritchie
 The surface of tract is owned in fee by _____
 Address _____
 Mineral rights are owned by _____
 Address _____
 Drilling commenced _____
 Drilling completed Aug. 10, 1910
 Date Shot Aug 13, 1910 and Aug. 26, 1910
 With 40 qts. and 30 qts.
 Open Flow _____ /10ths Water in _____ Inch
 _____ /10ths Merc. in _____ Inch
 Volume _____ Cu. Ft.
 Rock Pressure _____ lbs. _____ hrs.
 Oil _____ bbls., 1st 24 hrs.
 WELL ACIDIZED _____
 WELL FRACTURED _____


Casing and Tubing	Used in Drilling	Left in Well	Packers
Size			Kind of Packer _____
16			
13			Size of _____
10			
8 1/4			Depth set _____
6 5/8		1616	
5 3/16			Perf. top _____
3			Perf. bottom _____
2			Perf. top _____
Liners Used			Perf. bottom _____

CASING CEMENTED _____ SIZE _____ No. Ft. _____ Date _____

COAL WAS ENCOUNTERED AT _____ FEET _____ INCHES
 _____ FEET _____ INCHES FEET _____ INCHES
 _____ FEET _____ INCHES FEET _____ INCHES

RESULT AFTER TREATMENT _____
 ROCK PRESSURE AFTER TREATMENT _____
 Fresh Water _____ Feet Salt Water _____ Feet

Formation	Color	Hard or Soft	Top	Bottom	Oil, Gas or Water	Depth	Remarks
Keener			2080				
Big Injun			2120	2130			
Bottom of Hole				2140			

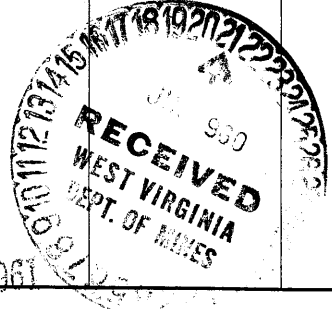

Formation	Color	Hard or Soft	Top	Bottom	Oil, Gas or Water	Depth Found	Remarks

Date June 17, 1960

APPROVED HANLON OIL COMPANY, Owner

By *J. B. May* (Title) **Secretary**

2