

Latitude 39° 15'

Longitude 80° 55'



E. C. RICHARD
114 AC.

F. G. HANKINS
63 AC.

BRENT TAYLOR
125 AC.

J. O. CROSS
90 AC.

L. S. HULL
93 AC.

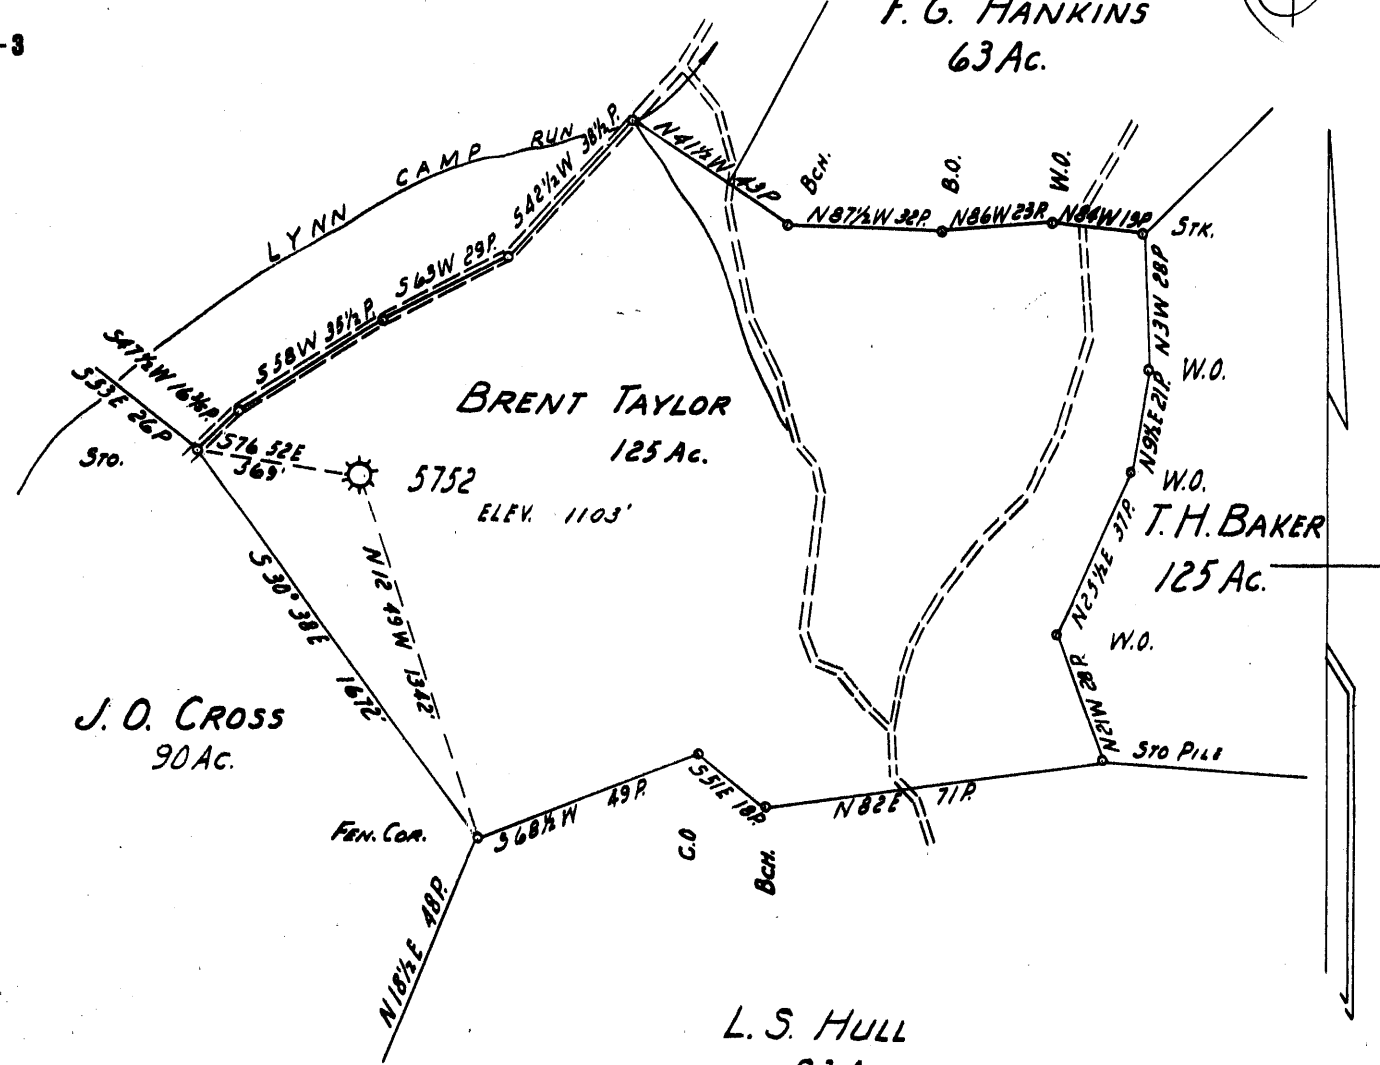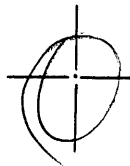

- New Location ..
- Drill Deeper
- Abandonment.....

DEC 28 1960

MAP SHEET 67 SQUARES S16 W18 FB 1233 PG. 9

*0.7 W
m 68 2*

Company HOPE NATURAL GAS CO.
 Address CLARKSBURG, W.VA.
 Farm BRENT TAYLOR
 Tract _____ Acres 125 AC. Lease No. 36052
 Well (Farm) No. _____ Serial No. 5752
 Elevation (Spirit Level) 1103'
 Quadrangle HOLBROOK
 County RITCHIE District CLAY
 Engineer Guy H. Bradley
 Engineer's Registration No. 2425
 File No. _____ Drawing No. _____
 Date NOV. 2, 1960 Scale 1" = 40P.

STATE OF WEST VIRGINIA
DEPARTMENT OF MINES
OIL AND GAS DIVISION
CHARLESTON

WELL LOCATION MAP
FILE NO. Rit-1331-A

+ Denotes location of well on United States Topographic Maps, scale 1 to 62,500, latitude and longitude lines being represented by border lines as shown.

- Denotes one inch spaces on border line of original tracing.



(1181)

STATE OF WEST VIRGINIA
DEPARTMENT OF MINES
OIL AND GAS DIVISION

Quadrangle HOLBROOK

Permit No. 1331A

WELL RECORD

Oil or Gas Well Gas
(KIND)

Company Hope Natural Gas Company
Clarksburg, W. Va.
Address _____
Farm Brent Taylor Acres 125

Location (waters) _____
Well No. 5752 Elev. 1103
District Clay County Mitchell

The surface of tract is owned in fee by _____
Address _____

Mineral rights are owned by _____
Address _____

Drilling commenced 9-29-20
11-1-20
Drilling completed _____
Date Shot 8-21-25 From Injun To _____
With 25 qts

Open Flow _____ /10ths Water in _____ Inch
_____ /10ths Merc. in _____ Inch

Volume Exhausted Cu. Ft.

Rock Pressure 77 lbs. 77 hrs.

Oil 1922 No test bbls., 1st 24 hrs.

WELL ACIDIZED No

WELL FRACTURED No

Casing and Tubing	Used in Drilling	Left in Well	Packers
Size			Kind of Packer
16			
13			
10			Size of
8 1/4	<u>1097</u>	<u>1097</u>	
6 3/8	<u>1940</u>	<u>1940</u>	Depth set
5 3/16			
3	<u>2061</u>	<u>2061</u>	Perf. top
2			Perf. bottom
Liners Used			Perf. top
			Perf. bottom

CASING CEMENTED _____ SIZE _____ No. Ft. _____ Date _____
No record of cementing

COAL WAS ENCOUNTERED AT 185 FEET 60 INCHES

_____ FEET _____ INCHES _____ FEET _____ INCHES


_____ FEET _____ INCHES _____ FEET _____ INCHES

RESULT AFTER TREATMENT _____

ROCK PRESSURE AFTER TREATMENT _____

Fresh Water No record Feet _____ Salt Water _____ Feet _____

Formation	Color	Hard or Soft	Top	Bottom	Oil, Gas or Water	Depth	Remarks
Small			930	960			
Little Duckard			930	960			
Big Duckard			1095	1125			
Gas Sand			1170	1235			
Sand			1260	1285			
First Salt			1415	1465			
2nd Salt			1495	1600			
3rd Salt			1625	1750	Gas	173 1/2	
Horton Sand			1780	1830			
BIG LIME			1909	1979	Oil	1922	
Big Injun			1979	205 1/2	Gas	1980	
Total Depth				2097'			

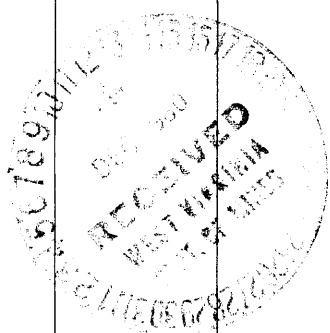

December 9, 1960
[Signature]
Hope Natural Gas Co.