

Surface owned by Gale Clark, MacFarlan, W. Va. *4.13 W*
 No Coal *2.12 A*

New Location
 Drill Deeper
 Abandonment

JUL 30 1961

On 800' Map No. 13 Sqs. 527 W 30.

Company P. & J. Development Co., Inc.
 Address Hamlin, W. Va.
 Farm Sarah J. Lemon
 Tract _____ Acres 555 Lease No. _____
 Well (Farm) No. 3 Serial No. _____
 Elevation (Spirit Level) 1142.
 Quadrangle Harrisville
 County Ritchie District Murphy
 Engineer Elsworth Haines
 Engineer's Registration No. 2221.
 File No. _____ Drawing No. _____
 Date June 28th, 1961. Scale 1" = 800 Feet

STATE OF WEST VIRGINIA
 DEPARTMENT OF MINES
 OIL AND GAS DIVISION
 CHARLESTON

WELL LOCATION MAP
 FILE NO. Rit-1336-A

+ Denotes location of well on United States Topographic Maps, scale 1 to 62,500, latitude and longitude lines being represented by border lines as shown.

- Denotes one inch spaces on border line of original tracing.



1182

STATE OF WEST VIRGINIA
DEPARTMENT OF MINES
OIL AND GAS DIVISION

Harrisonville

Quadrangle _____

Permit No. 1336-A

WELL RECORD

Oil or Gas Well Oil
(KIND)

Company South Penn Oil Co.
Address Parkersburg, W. Va.
Farm Sarah J. Lemon Acres 555
Location (waters) Dutchman Run
Well No. 3 Elev. 1142
District Murphy County Ritchie
The surface of tract is owned in fee by _____
Address _____

Mineral rights are owned by _____
Address _____
Drilling commenced 1916
Drilling completed 1916
Date Shot 1/3/27 From 1959' To 1980'
With 80 Qts.

Open Flow _____ /10ths Water in _____ Inch
_____ /10ths Merc. in _____ Inch

Volume _____ Cu. Ft.
Rock Pressure _____ lbs. _____ hrs.
Oil _____ bbls., 1st 24 hrs.

WELL ACIDIZED _____

WELL FRACTURED _____

RESULT AFTER TREATMENT _____

ROCK PRESSURE AFTER TREATMENT _____


Fresh Water _____ Feet Salt Water _____ Feet

Casing and Tubing	Used in Drilling	Left in Well	Packers
Size			Kind of Packer
16			<u>Wall</u>
13			
10	<u>133'</u>	<u>None</u>	Size of <u>6-5/8" x</u>
8 1/4	<u>1213'</u>	<u>1213'</u>	<u>8-1/4"</u>
6 5/8	<u>1838'</u>	<u>1838'</u>	Depth set <u>1832'</u>
5 3/16	<u>516'</u>	<u>516'</u>	
3			Perf. top _____
2	<u>1980'</u>	<u>1980'</u>	Perf. bottom _____
Liners Used			Perf. top _____
			Perf. bottom _____

CASING CEMENTED _____ SIZE _____ No. Ft. _____ Date _____

COAL WAS ENCOUNTERED AT _____ FEET _____ INCHES
_____ FEET _____ INCHES FEET _____ INCHES
_____ FEET _____ INCHES FEET _____ INCHES

Formation	Color	Hard or Soft	Top	Bottom	Oil, Gas or Water	Depth	Remarks
1st. Cow Run			960	975			
2nd. Cow Run			1200	1229			
Sand			1540	1630			
Salt Sand			1931				
Salt Sand			1960	1980	Oil & Gas	1965'	1832' SLM
Salt Sand Break			1983	1985	Water	1985'	1965' SLM
Total Depth				1989			

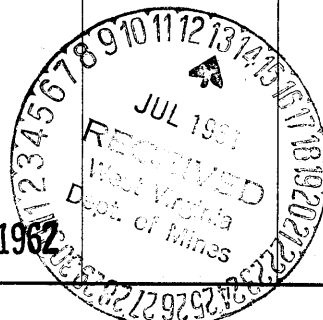

APR 6 1962

(over)