


Plat of proposed Location of Well No 1 of Shrader, Berkley & McKay, of Middlebourne, W. Va. on the Ross Wright farm of 50 Acres, Located in McElroy District, Tyler County.

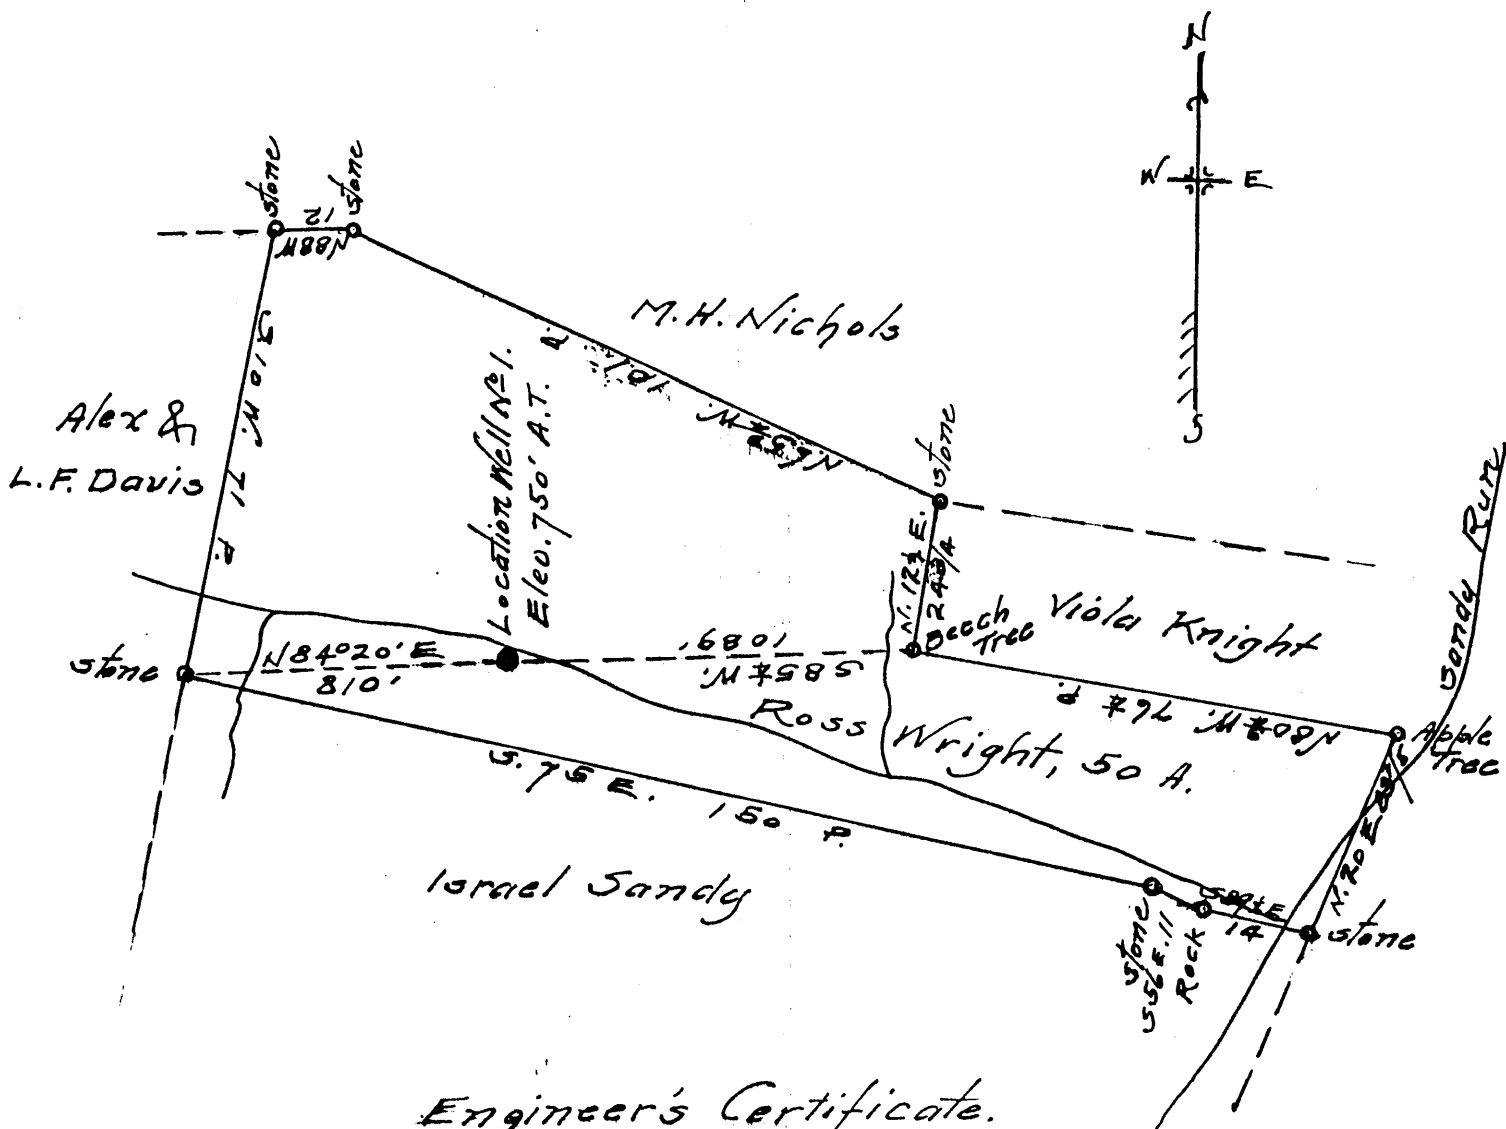

Engineer's Certificate.

I, the undersigned hereby certify that this map is correct and shows all the information to the best of my knowledge and belief, required by the Oil and Gas Section of the Mining Laws of West Virginia.

P. F. Berkley.
Engineer for Co.

Tyl-8

Acknowledged before me, a notary public, in and for Tyler County, West Va., this 2nd. day of October, 1930.

M. C. Burghachur
Notary public.


My Commission expires
Nov. 10, 1932

LATITUDE

39° 25'

80° 45'

LONGITUDE

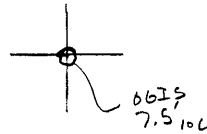

7'5 OGIS topo location

7.5' 106	<u>2.50 S</u>	15' 106	<u>2.50 S</u>
	<u>1.41 W</u>	(calc.)	<u>1.41 W</u>

Company _____

Farm _____

Quad Shirley (West Union) ^{15'} EC

County Tyler

District McElroy

WELL LOCATION MAP

File No. 095-8

WEST VIRGINIA DEPARTMENT OF MINES
Oil and Gas Section
PRELIMINARY DATA SHEET NO. 1

File No. Well No.
Shrader, Berkley & McKay Company, of Middlebourne, W. Va.
on the P. Ross Wright Farm
containing 50 acres. Location No. 1
McElroy District, in Tyler County, West Virginia.

The surface of the above tract is owned in fee by P. Ross Wright
of West Union, W. Va. address, and the mineral rights are owned by
P. Ross Wright of West Union, W. Va.

The oil and gas privileges are held under lease by the above named company, and this well is drilled under
permit No. Tyl-3 issued by the West Virginia Department of Mines, Oil and Gas Section,
October 14, 1930.

Elevation of surface at top of well, 845 ft. A. T. Spirit Barometric.

The number of feet of the different sized casings used in the well.
Six feet 13" size. Wood conductor
feet size, csg. 112 ft. feet 10" sized csg.
956 feet 8" size, csg. 1742 feet 5-3/16 sized csg.
feet size, csg. feet sized csg.
packer of size, set at
packer of size, set at
in casing perforated at feet to feet.
in casing perforated at feet to feet.

Coal was encountered at 487 feet; thickness 12 inches, and at
feet; thickness inches; and at feet; thickness inches.

Liners were used as follows: (Give details)
.....
.....
.....

February 3, 1931. Date.

Approved. Shrader Berkley and McKay, Owner.
By J. O. Shrader (Title)

Tyler 8

Shrader, Berkley & McKay Company

Middlebourne, W. Va. Address

Ty 1-8

COMPLETION DATA SHEET

NO. 2

FORMATION RECORD

Name	Color	Character	Oil, Gas or Water	Top	Bottom	Thickness	Total Depth	Remarks
Vgh Coal		No good		488	489	12"		
B. Dunkard		good		954				
Salt Sand				1125	1170	45'		
2. Sash				1310	1425	115'		
Maxton Sand				1634	1654	20'		
Slate Red				1654	1687	33'		
Rock				1687	1703	16'		
L. Lime				1703	1709	6'		
Pencil Coal				1709	1717	8'		
2nd. Lime				1717	1723	6'		
Pencil Coal				1723	1730	7'		
3rd. Lime				1737	1835	98'		
Big Lime		Hard		1835	1910	75'		
Big Limestone	Varied	good		1845	1850			
Oil & Gas show				1896	1897			
Little gas show								
							1944	

Well was not shot at.....feet; well was shot at.....feet.

Fresh water at.....35.....feet; salt fresh water at.....feet.

Well was ~~producing~~ hole.
dry

Feb 3, 1931
Date

Approved Shrader, Berkley & McKay
Owner

NOTE: All bottom formations must be noted as indicated above and all key-rocks and oil and gas sands must be recorded under their proper geological names in the district as well as any local names commonly used in the district for such strata.