


0
1
2
3

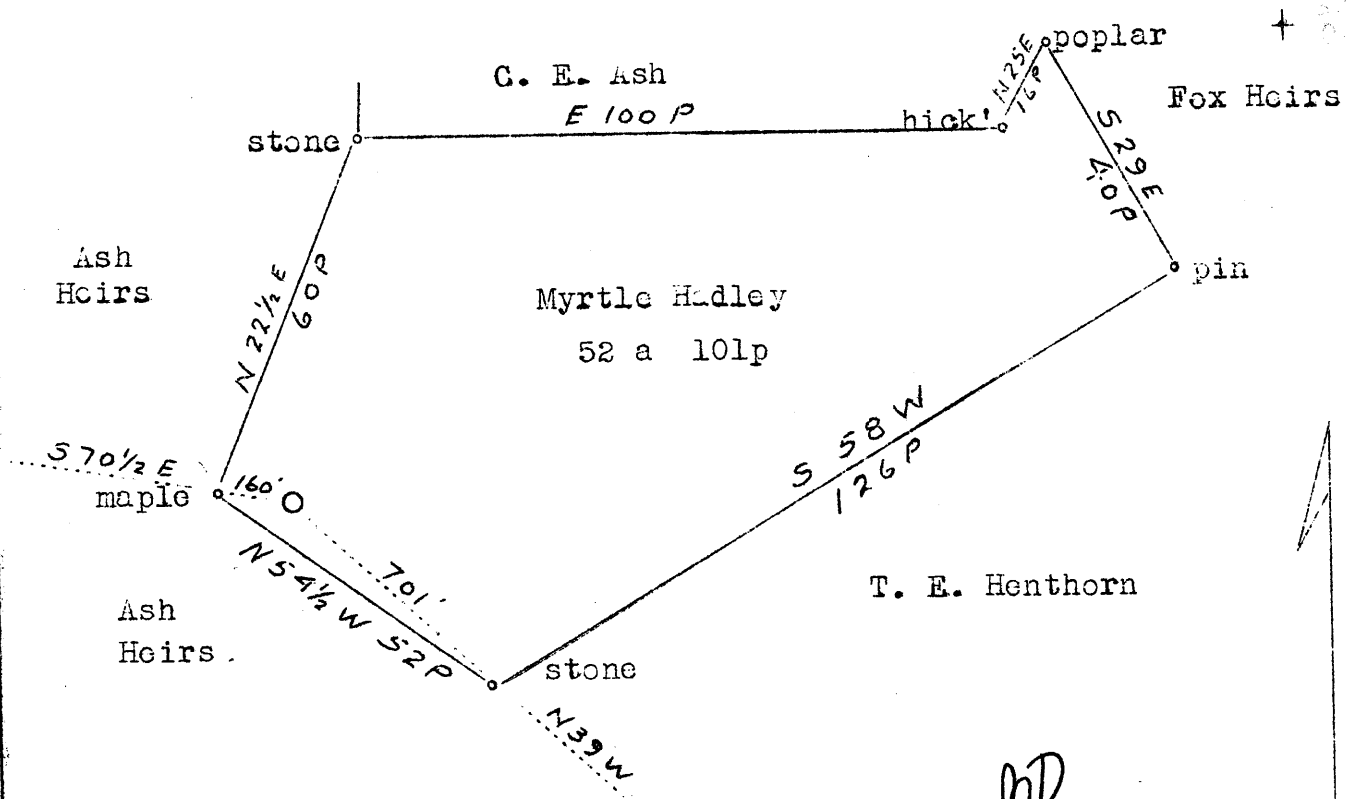

ABD
5/37

Company	W. H. MILLER
Address	Salem, W. Va.
Farm	Myrtle Hadley
Tract	1 Acres 52 Lease No.
Well (Farm) No.	1 Serial No.
Elevation (Spirit Level)	848'
Quadrangle	West Union NC
County	Tyler District Meade
Engineer	J. S. Haught
Engineer's Registration No.	Co. Surv.
File No.	Drawing No.
Date	11-20-36 Scale 1"-30 rods

STATE OF WEST VIRGINIA
~~Department of Mines~~
 OIL AND GAS DIVISION
 CHARLESTON

WELL LOCATION MAP
 File No. 44 60

+ Denotes location of well on U. S. Topographic Maps, scale 1 to 62,500, latitude and longitude lines being represented by border lines as shown

- Denotes one inch space on border line of original tracing.

WEST VIRGINIA DEPARTMENT OF MINES
OIL AND GAS DIVISION

WELL RECORD

Permit No. Tyl-60

Oil or Gas Well Dry
(Kind)

Company W. H. Miller
Address Parkersburg, West Va.
Farm Myrtle Hadley Acres 54
Location (waters) Sancho Creek
Well No. 1 Elev. 1144'
District Meade County Tyler
The surface of tract is owned in fee by Myrtle Hadley
Address Middlebourne, W. Va.
Mineral rights are owned by Myrtle Hadley
Address Middlebourne, W. Va.
Drilling commenced December 23, 1936
Drilling completed May 10, 1937
Date shot May 11, 1937 Depth of shot 1744
Open Flow /10ths Water in Inch
/10ths Merc. in Inch
Volume Cu. Ft.
Rock Pressure lbs. hrs.
Oil bbls., 1st 24 hrs.
Fresh water feet feet
Salt water feet feet

Casing and Tubing	Used in Drilling	Left in Well	Packers
Size			
16			Kind of Packer
13			
10	130'		Size of
8 1/4	735'		
6 5/8	870'		Depth set
5 3/16	1639'		
3			Perf. top
2			Perf. bottom
Liners Used			Perf. top
			Perf. bottom

CASING CEMENTED SIZE No. FT. Date
COAL WAS ENCOUNTERED AT FEET INCHES
 FEET INCHES FEET INCHES
 FEET INCHES FEET INCHES

Formation	Color	Hard or Soft	Top	Bottom	Oil Gas or Water	Depth Found	Remarks
Surface			0	90			
Sand			90	125	Water	120'	Hole full
Sand, hard		Hard	125	175			
Red Rock			175	195			
Pink "			275	290			
Big Red			620	650			
1st. Cow							
Run Sand			800	840	Water	825	3 bailers per hour
2nd. Cow							
Run Sand			925	950			
1st. Salt Sand			1050	1100			
2nd. Salt Sand			1130	1155			
3rd. Salt Sand			1220	1350	Water	1300	
Maxon Sand			1368	1511			
Cairo Salt Sand			1607	1640	Water	1627	
Lime			1640	1680			
Keener sand			1680	1700			
Break			1700	1705			
Big Injun			1705	1785	Gas	1714	Small show
"					Oil	1742	
Total Depth				1785			