


AM

LATITUDE 39° 25'

LONGITUDE 80° 55'

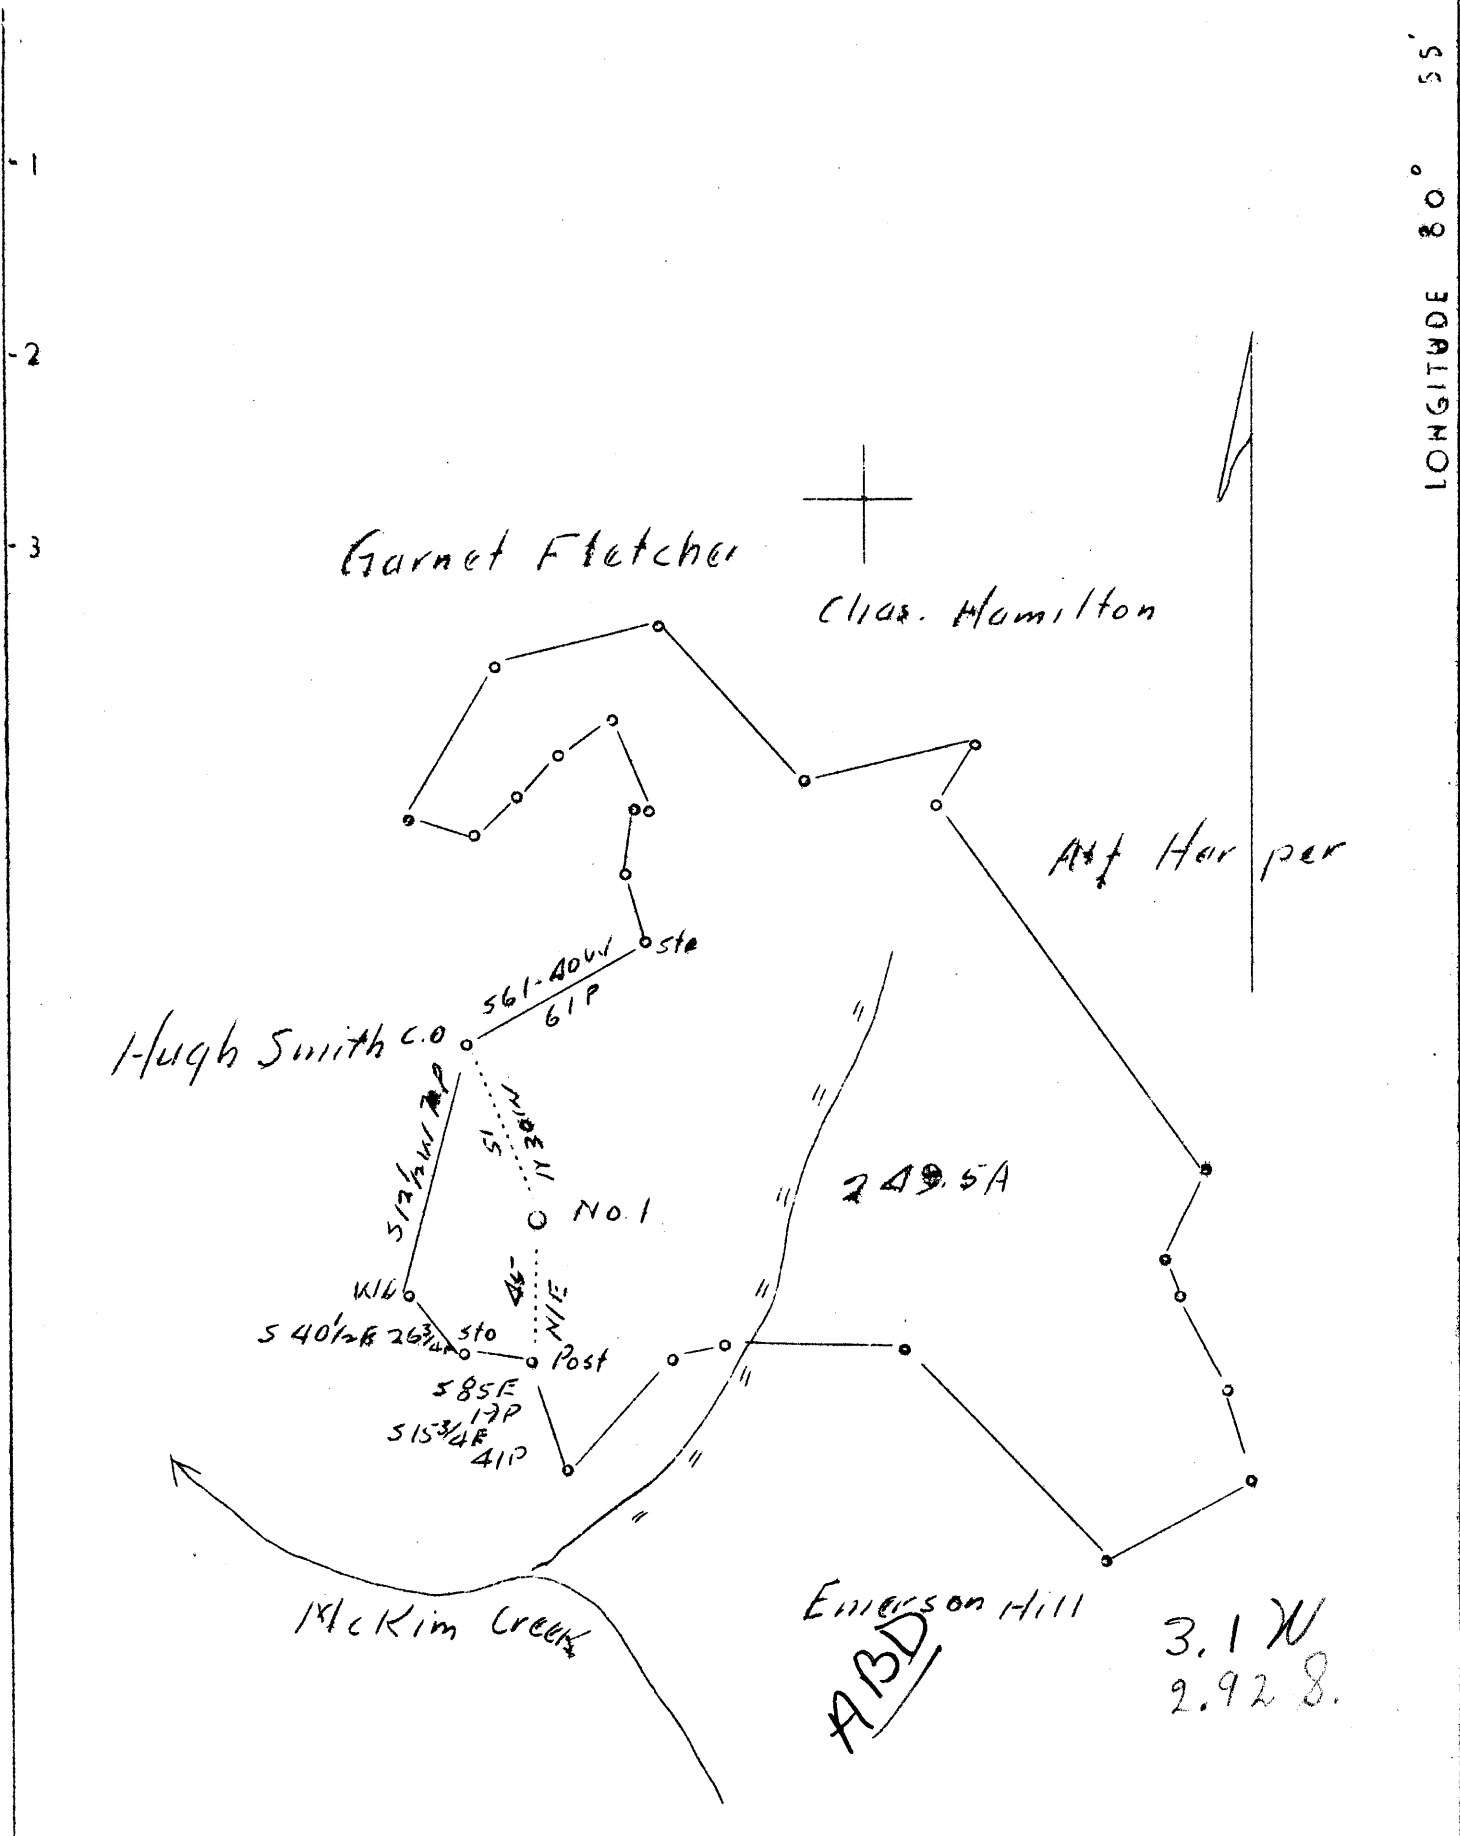

Company A.B. Lowther
 Address Alma, W. Va.
 Farm Grace E. & A.B. Lowther
 Tract 1 Acres 249.5 Lease No. _____
 Well (Farm) No. 1 Serial No. _____
 Elevation (Spirit Level) 975'
 Quadrangle West Union (W. U.)
 County Tyler District Meade
 Engineer J.V. Dunbar
 Engineer's Registration No. 65
 File No. C-23-L Drawing No. _____
 Date Sept. 27, 1932 Scale 1"-60 Rods

STATE OF WEST VIRGINIA
 Department of Mines
 OIL AND GAS DIVISION
 CHARLESTON

WELL LOCATION MAP

File No. TYL-84

+ Denotes location of well on United States Topographic Maps, scale 1 to 62,500, latitude and longitude lines being represented by border lines as shown.

— Denotes one inch spaces on border line of original tracing.

WEST VIRGINIA DEPARTMENT OF MINES
OIL & GAS DIVISION
W E L L R E C O R D

Permit No. Tyl. 84			Gas Well
West Union Quad.			CASING & TUBING
Company	A.B. Lowther		
Address	Alma, W.Va.		
Farm	Grace E. Lowther	Acres 250	8 1/2 590 Same
Location	McKim		6 5/8 1230
Well No.	1	Elev. - 975'	5 3/16 1615
District	Meade	Tyler County	
Surface	Grace E. Lowther, Alma, W.Va.		
Mineral	Same		
Commenced	Oct. 1937		
Completed	Dec. 1937		
Volume	about 40,000 C.F.		
Oil	None		

Red Rock	0	220	
Shale	220	275	
Sand & Shale	275	490	
Red Rock	490	500	
Sand & Shale	500	830	
Red Rock	830	855	
Sand & Shale	855	955	
Red Rock	955	990	
First Cow Run	990	1020	
Pink Rock	1020	1039	
Lime	1039	1080	
2nd Cow Run	1080	1110	
Shale	1110	1114	
1st Salt Sand	1114	1180	
Shale	1180	1190	
2nd Salt Sand	1190	1325	
Shale	1325	1365	
Sand & Shale	1365	1550	Little Water 1470
Shale	1550	1565	
Lime	1565	1575	
Sand	1575	1660	
Lime	1660	1675	
Shale	1675	1755	
Marxon	1755	1803	
Shale	1803	1815	
Little Lime	1815	1825	
Pencil Cave	1825	1830	
Big Lime	1830	1925	
Injun Sand	1925	2026	Gas 1974-1981

1830
975

855

Present address A.B. Lowther, Middlebourne, W.Va.

1830-1925
975

1950