


M

Latitude 39° 25'

Longitude 80° 50'

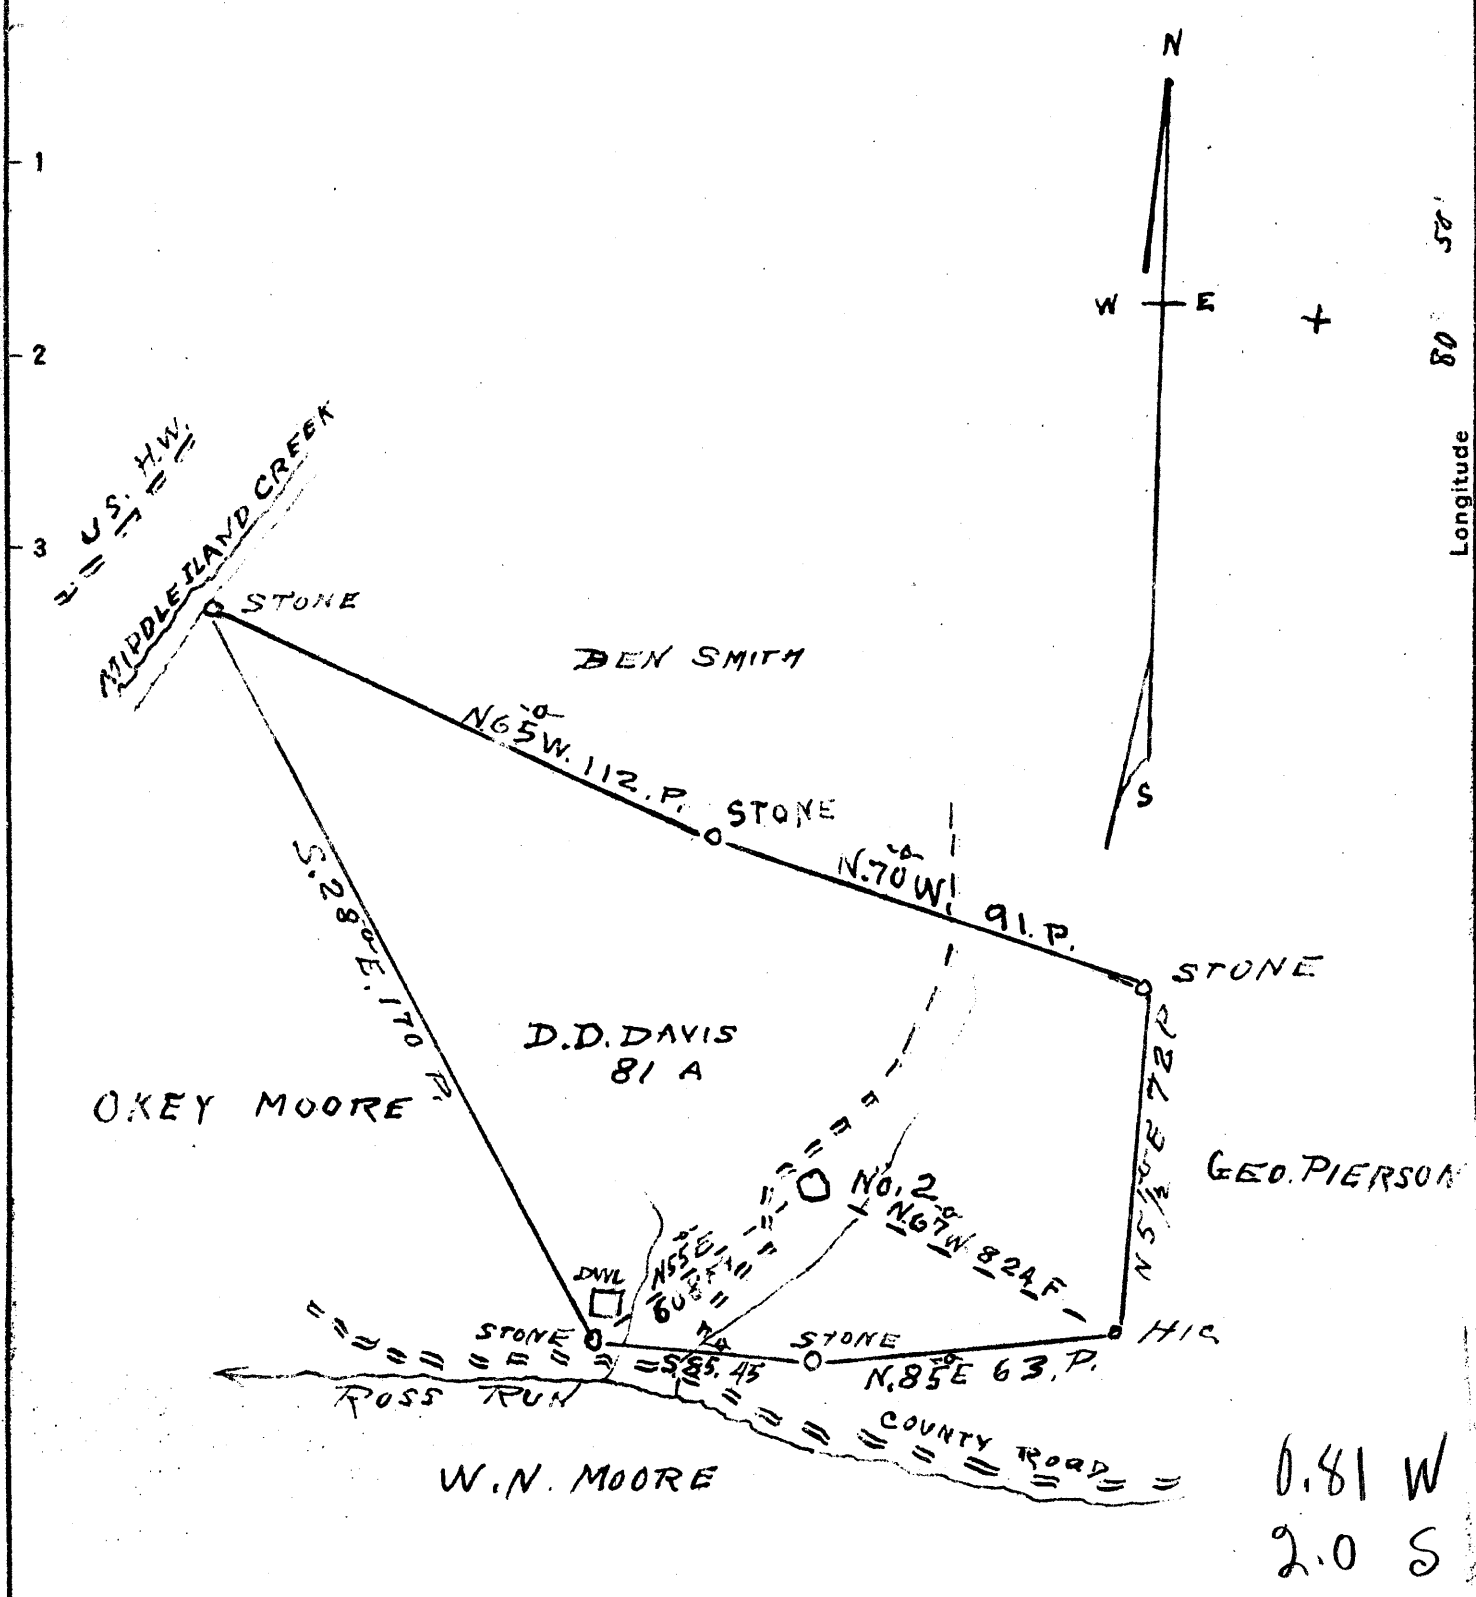

New Location X
 Drill Deeper
 Abandonment

SURVEYED AND PLATTED BY ROBERT CHALFANT PIKE W.V.A.

Company TYLER-WOOD OIL & GAS CO
 Address PARKERSBURG W.V.A
1/2 MOUNTAIN IRON SUPPLY CO
 Farm D.D. DAVIS
 Tract _____ Acres 81 Lease No. _____
 Well (Farm) No. 2 Serial No. _____
 Elevation (Spirit Level) 830
 Quadrangle WEST UNION
 County TYLER District CENTERVILLE
 Engineer J. V. Dumbler
 Engineer's Registration No. 65
 File No. C-23- Drawing No. _____
 Date Mar 21st 1948 Scale AD P. 10. 1 INCH

STATE OF WEST VIRGINIA
 DEPARTMENT OF MINES
 OIL AND GAS DIVISION
 CHARLESTON

WELL LOCATION MAP
 FILE NO. TYL-113

+ Denotes location of well on United States Topographic Maps, scale 1 to 62,500, latitude and longitude lines being represented by border lines as shown.

- Denotes one inch spaces on border line of original tracing.

WEST VIRGINIA DEPARTMENT OF MINES
OIL & GAS DIVISION
W E L L R E C O R D

Permit No. Tyl-113
West Union Quad.

Oil & Gas

CASING & TUBING

Company	Tyler-Wood Oil & Gas Co.	8-1/4	400	
Address	Parkersburg, W. Va.	6-5/8	1050	1050
Farm	D. D. Davis ACRES 81	5-3/16	1695	1695
Location	Ross Run	2		1885
Well No.	2 ELEV. 830			
District	Centerville - Tyler County			
Surface	D. D. Davis, Joseph Mills, W. Va.			
Mineral	Tyler-Wood O&G Co. Parkersburg, W. Va.			
Commenced	-			
Completed	- (Rec'd by Dept. Mines 10/21/40)			
Open Flow	-			
Volume	-			
Rock Pressure	-			
Oil	-			
Water	-			

Lime	496	525	
Slate	525	625	
Lime	625	635	
Red Rock	635	730	
Slate	730	745	
Red Rock	745	760	
Slate	760	810	
Red Rock	810	830	
Shells	830	870	
Blk. Slate	870	960	
Lime	960	975	
Slate	975	990	
Red Rock	990	1000	
Sandy Lime	1000	1005	
Slate	1005	1050	
Lime	1050	1055	
Slate&Shells	1055	1115	
Sand	1115	1130	
Blk. Slate	1130	1145	
Lime	1145	1155	
Sand	1155	1200	
Slate	1200	1235	
Sand	1235	1255	
Slate	1255	1260	
Sand	1260	1280	
Slate	1280	1340	
Sand	1340	1385	
Slate	1385	1470	
Sand	1470	1520	
Slate&Shells	1520	1600	
Maxon	1600	1642	Water
Slate	1642	1665	
Little Lime	1665	1676	
Slate	1676	1695	
Big Lime	1695	1812	Gas & Oil 1780-97
Big Injun	1812	1885	Gas & Oil 1865-75
Bottom of hole		1885	

1974
1131
1132
1133
1134
1135
1136
1137
1138
1139
1140