


New Location X
 Drill Deeper
 Abandonment

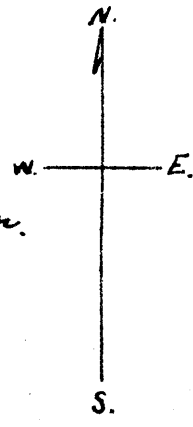

Company C. A. Bell & others.
 Address Fly, Ohio.
 Farm H. R. Fisher.
 Tract _____ Acres 139 Lease No. _____
 Well (Farm) No. 1. Serial No. _____
 Elevation (Spirit Level) 940'
 Quadrangle New Matamoras
 County Tyler District Union.
 Engineer Jno. Triplett.
 Engineer's Registration No. _____
 File No. _____ Drawing No. _____
 Date Sept. 4, 1908 Scale 30 P = 1"

STATE OF WEST VIRGINIA
 DEPARTMENT OF MINES
 OIL AND GAS DIVISION
 CHARLESTON

WELL LOCATION MAP
 FILE NO. Tyler-147

+ Denotes location of well on United States Topographic Maps, scale 1 to 62,500, latitude and longitude lines being represented by border lines as shown.

- Denotes one inch spaces on border line of original tracing

WEST VIRGINIA DEPARTMENT
OIL & GAS DIVISION
WELL RECORD

Permit No. Tyl 147
New Matamoras Quad.

-- Well
CASING & TUBING

Company
Address
Farm
Location
Well No.
District
Surface
Mineral

Commenced
Completed
Oil
No fresh Water
Salt Water

Lula O. Bell
Sistersville, W.Va.
H.R. Flesher Acres 139
Big Buffalo Creek
1 Elev. 940
Union Tyler County
H.R. Flesher, Friendly, W.Va.
H.R. Flesher, Friendly, W.Va.
Maude Marsteller, Elkins, W.Va.
April 11, 1945
July 9, 1945
 $\frac{1}{2}$ bbl. 1st 24 hrs.

35 bbl. per day 200'

8 $\frac{1}{2}$ 250' 250'
Liners used
200' 601 to 891'

No Packer

Casing not cemented

No coal

✓ Cow Run Gr S 917 927 Oil & Water 923