


Latitude 39

30'

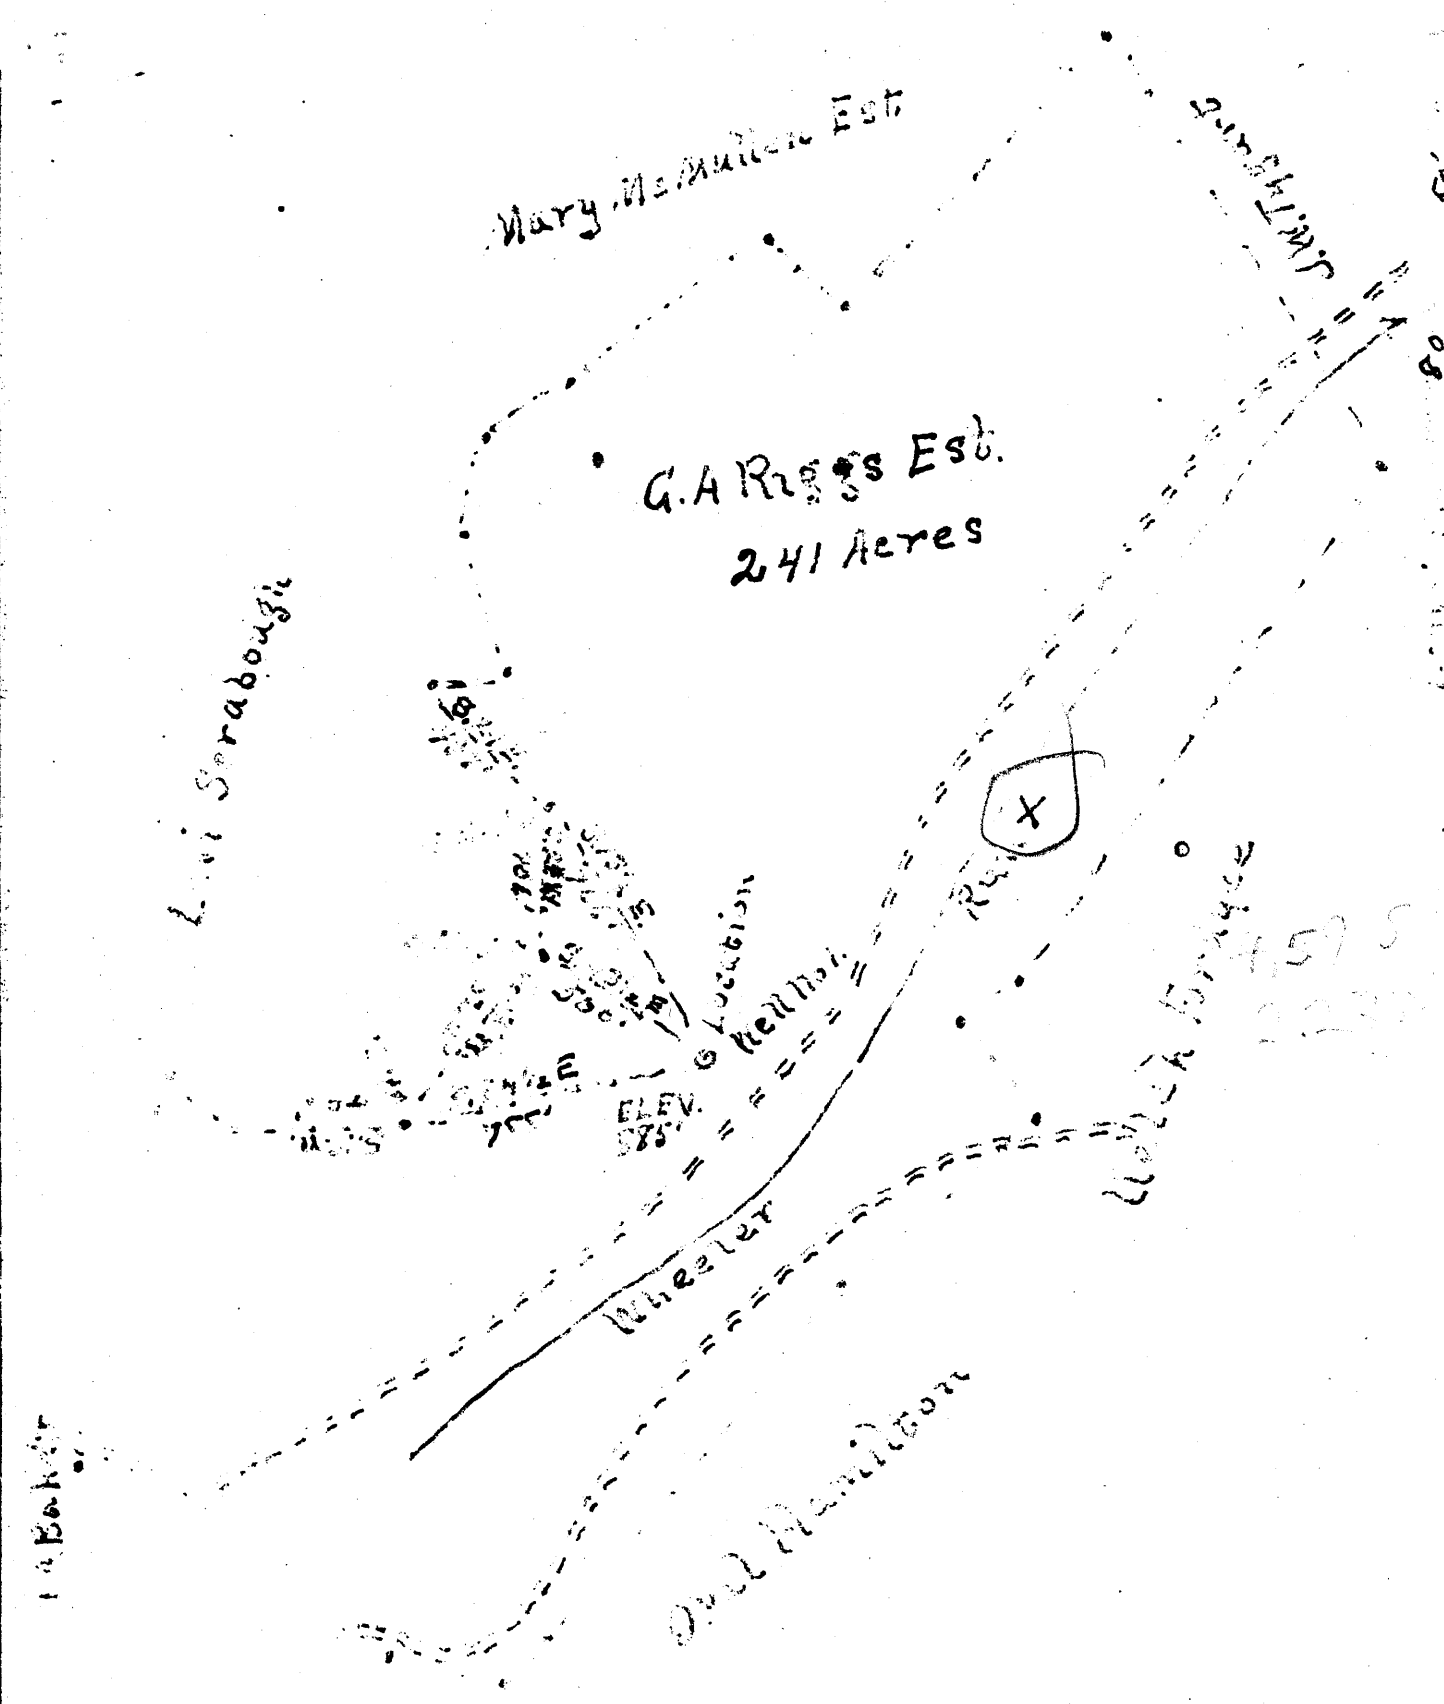

Location

Company	Albert Neely
Address	St. Marys N.C.
Farm	G.A. Riggs Estate
Acres	241
Well (Farm) No.	
Elevation	885'
County	Wet. Union NC
Dist.	Centerville
Scale	1" = 500'

TYL-150
 Tyl-150
 ✓

WEST VIRGINIA DEPARTMENT OF MINES
OIL & GAS DIVISION
W E L L R E C O R D

Permit No. Tyl 150
West Union Quad.
Company
Address
Farm
Location
Well No.
District
Surface
Commenced
Completed
Date shot
Open flow
Oil
Salt Water

Albert Neely
St. Marys, W.Va.
G.A. Riggs Heirs Acres 241

1 Elev. 885
Centerville Tyler County
G.A. Riggs Heirs, Alma, W.Va.
Aug. 6, 1945
Nov. 20, 1945
Nov. 22, 1945 Depth 2072..2082
No test
1/2 bbl. in 24 hrs.
1781'

Dry Hole
CASING & TUBING

10 700
8 1/2 1125
6 5/8 1916

Red Rock	964	876	
Slate & Shell	876	896	
Red Rock	896	924	
Little Dunkard	924	935	
Slate & Shell	935	952	
Sand H	952	960	
Red Rock	960	1000	
Pink Rock	1000	1050	
Slate	1050	1100	
Pink Rock	1100	1160	
Black Slate	1160	1170	
Sand	1170	1180	
Black Slate	1180	1192	
Slate & Shells	1192	1215	
Sand	1215	1228	
Slate & Shells	1228	1250	
Sand	1250	1282	
Slate	1282	1318	
Sand	1318	1378	
Slate	1378	1455	
Sand	1455	1490	
Slate	1490	1500	
Sand	1500	1554	
Slate	1554	1634	
Sand	1634	1721	
Slate	1721	1788	
Slate & Shell	1788	1792	
Sand	1792	1800	
Black Slate	1800	1840	
Sand	1840	1871	
Slate	1871	1873	
Little Lime	1873	1908	
Pencil Cave	1908	1916	
Big Lime	-1916	2001	Gas 2053
Sand	2001	2023	Gas 2072 to 2082
Big Injun	2023	2099	Oil 2072 to 2082
TOTAL DEPTH		2099	

1916
885
1781

1916
1781
1916