

77


Latitude 39 35'

0 1 2 3


1

2

3

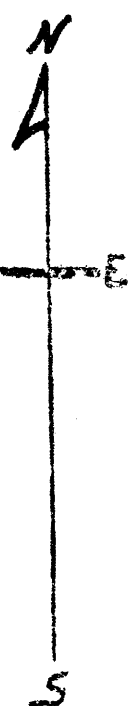

Longitude 80 50'

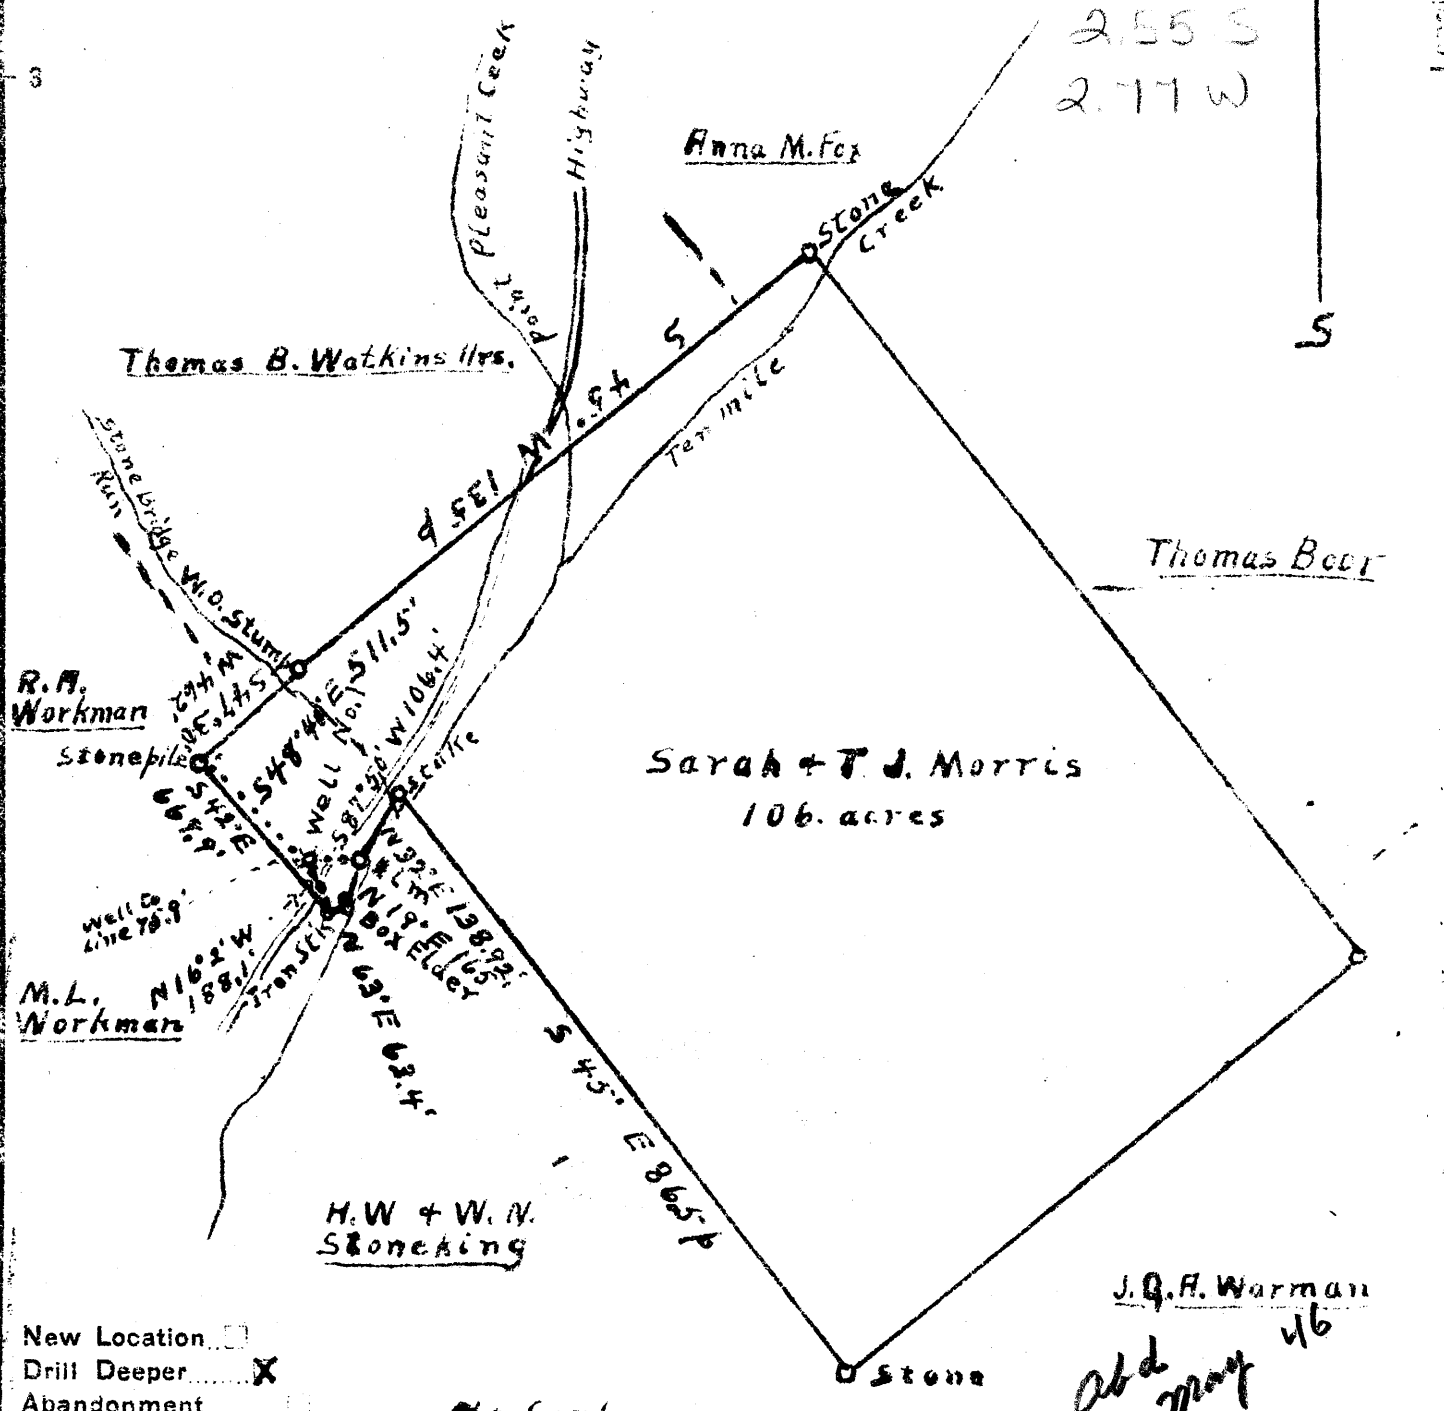

Company Pittsburgh Oil & Gas Co.
 Address 841 Oliver Bldg. Pittsburgh, Pa.
 Farm Sarah + T.J. Morris
 Tract _____ Acres 106a Lease No. _____
 Well (Farm) No. 1 Serial No. _____
 Elevation (Spirit Level) 705.3'
 Quadrangle New Martinsville
 County Tyler District Edsforth
 Engineer Don L. Riggle
 Engineer's Registration No. _____
 File No. 046-P Drawing No. 1242
 Date 3-11-46 Scale 1" = 400'
660'

STATE OF WEST VIRGINIA
 DEPARTMENT OF MINES
 OIL AND GAS DIVISION
 CHARLESTON

WELL LOCATION MAP
 FILE NO. TYL-153-D

+ Denotes location of well on United States Topographic Maps, scale 1 to 62,500, latitude and longitude lines being represented by border lines as shown.

- Denotes one inch spaces on border line of original tracing.



384

To be reported
153-D

STATE OF WEST VIRGINIA
DEPARTMENT OF MINES
OIL AND GAS DIVISION

WELL RECORD

Permit No. _____ Oil or Gas Well _____ (KIND)

Company Pittsburg Oil & Gas Company
 Address 841 Oliver Building
 Farm Sarah & T. J. Morris Acres 106
 Location (waters) _____
 Well No. 1 Elev. 705.3
 District Ellsworth County Tyler
 The surface of tract is owned in fee by _____
 Address _____
 Mineral rights are owned by _____
 Address _____
 Drilling commenced no record - this well purchased
 Drilling completed from McKelvy Oil & Gas Co.
 Date Shot _____ From _____ To _____
 With _____
 Open Flow _____ /10ths Water in _____ Inch
 _____ /10ths Merc. in _____ Inch
 Volume _____ Cu. Ft.
 Rock Pressure _____ lbs. _____ hrs.
 Oil _____ bbls., 1st 24 hrs.
 Fresh water _____ feet _____ feet
 Salt water _____ feet _____ feet

Casing and Tubing	Used in Drilling	Left in Well	Packers
Size			
16			Kind of Packer
13			
10			Size of
8 1/4			
6 5/8		1437	Depth set
5 3/16			
3			Perf. top
2			Perf. bottom
Liners Used			Perf. top
			Perf. bottom

CASING CEMENTED _____ SIZE _____ No. Ft. _____ Date _____
 COAL WAS ENCOUNTERED AT _____ FEET _____ INCHES
 _____ FEET _____ INCHES FEET _____ INCHES
 _____ FEET _____ INCHES FEET _____ INCHES

Formation	Color	Hard or Soft	Top	Bottom	Oil, Gas or Water	Depth Found	Remarks
Top of Keener	sand	1583					
First Pay		1591					
Total Depth		1608					

