
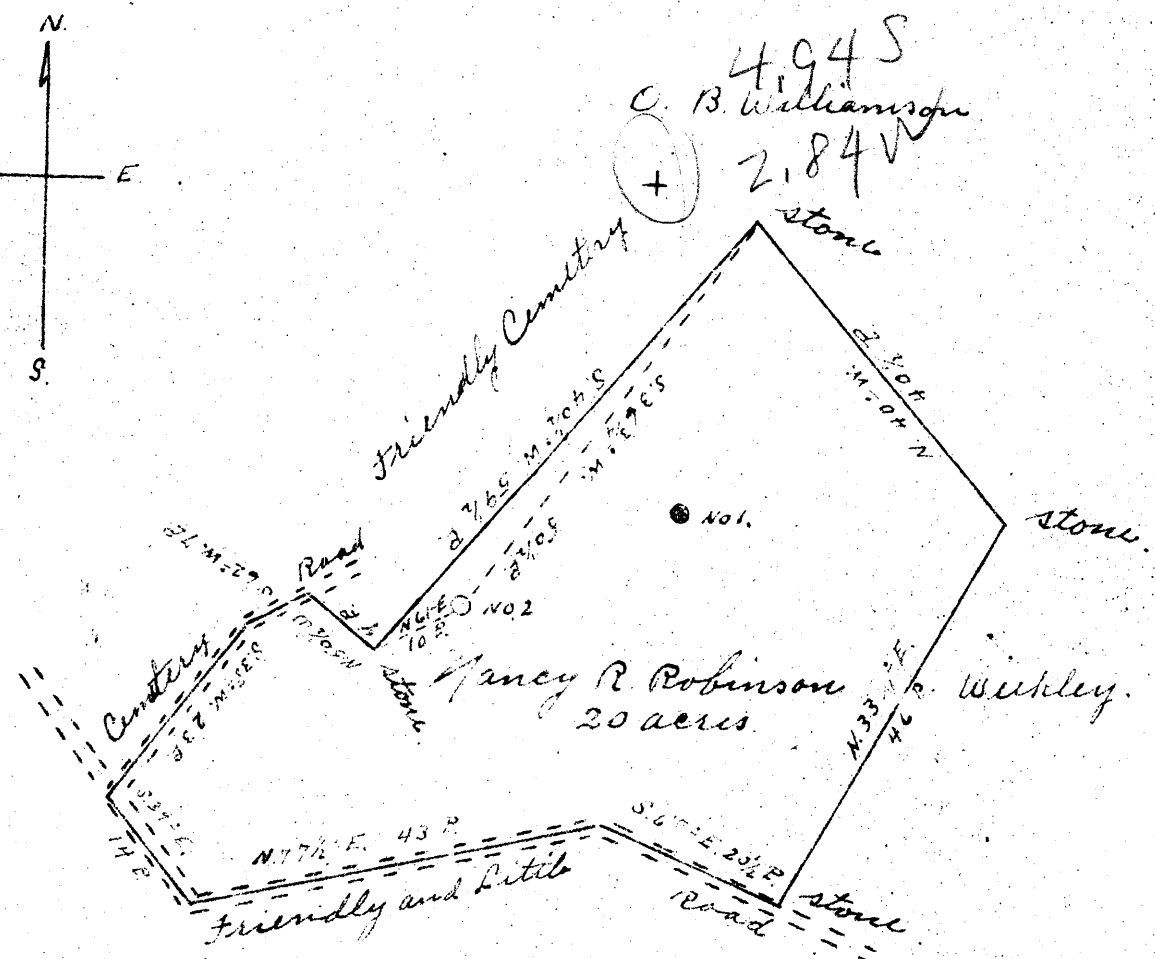


M

Latitude 39° 35'

Longitude 81° 00'

0 1 2 3
1
2
3

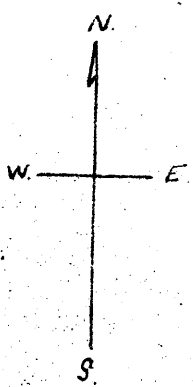

R. S. Jacobs

New Location
Drill Deeper
Abandonment

Company Carmel Oil Co.
 Address New Matamoras Ohio
 Farm Nancy R. Robinson
 Tract _____ Acres 20 Lease No. _____
 Well (Farm) No. 2 Serial No. _____
 Elevation (Spirit Level) 878'
 Quadrangle New Matamoras 50
 County Tyler District Almon
 Engineer Robert R. Anderson
By Geo. Triplett, Surveyor
 Engineer's Registration No. 296
 File No. _____ Drawing No. _____
 Date Sept. 12, 1949 Scale 1" = 20 P.

STATE OF WEST VIRGINIA
DEPARTMENT OF MINES
OIL AND GAS DIVISION
CHARLESTON

WELL LOCATION MAP
FILE NO. JYL-169

+ Denotes location of well on United States Topographic Map, scale 1 to 62,500. latitude and longitude being represented by border lines as shown.
- Denotes one inch spaces on border line of original tracing.

WEST VIRGINIA DEPARTMENT OF MINES
OIL & GAS DIVISION
W E L L R E C O R D

Permit No. Tyl 169
New Matamoras Quad.

Dry Hole
CASING & TUBING

Company	Carmel Oil Co.		
Address	New Matamoras, Ohio	10	100
Farm	Nancy Robinson A 40	8 1/2	750
Location		6 5/8	1378
Well No.	2	Elev. <u>8781</u>	
District	<u>Union</u> Tyler County		
Surface	Nancy Robinson, Box 13, Friendly, W.Va.		Coal 423' 12"
Mineral	Same		
Commenced	Oct. 3, 1949		
Completed	Oct. 26, 1949		

Top Soil & Clay		0	60	
Red Lime Red	H	60	85	
Shale Blue		85	100	
Sandy Lime Red	H	100	115	
Sand Wh	H	115	185	Broken
Shale & Lime Blue	S	185	295	
Sand Gr	H	295	305	Broken
Shale & Lime Grey	H	305	330	
Red Rock	S	330	340	
Lime & Shale Gr (Shells)		340	410	
Sand Gr	H	410	423	
✓ Coal Blk	S	423	424	Pittsburgh Coal
Sand Gr	Sharp	424	440	
Lime Shells Gr	Sharp	440	465	
Red Rock	S	465	480	
Shale Wh	S	480	545	
Red Rock	S	545	642	
Shale Bl	S	642	700	
Red Rock	S	700	745	
Shale Gr	S	745	833	
Lime Wh	H	833	875	Sandy
Shale Gr		875	980	
Lime Gr	H	980	1010	
Shale Gr		1010	1050	
✓ Salt Sand (C.S)	Sharp	1050	1095	
Shale Bl		1095	1170	
Sand Gr		1170	1175	
Slate Blk		1175	1180	
✓ Salt Sand	Sharp	1180	1230	
Shale		1230	1378	
✓ Salt Sand 3rd	Sharp	1378	1450	
Shale Blue		1450	1515	
✓ Sand		1515	1538	
✓ Lime Dk Bl		1538	1590	Broken
✓ Keener Sand		1590	1597	Gas 1590 Smell
Lime Break		1597	1604	
Sand Blue		1604	1638	
Sandy Shale		1638	1653	
✓ Injun Sand		1653	1805	Gas 1739 Smell(Injun Sand)
Shale & Slate Black		1805	1827	
T.D.			1827	

1590
423
1106

100
778
1722