


1

2

3

Latitude 39° 30'

Longitude 80° 15'

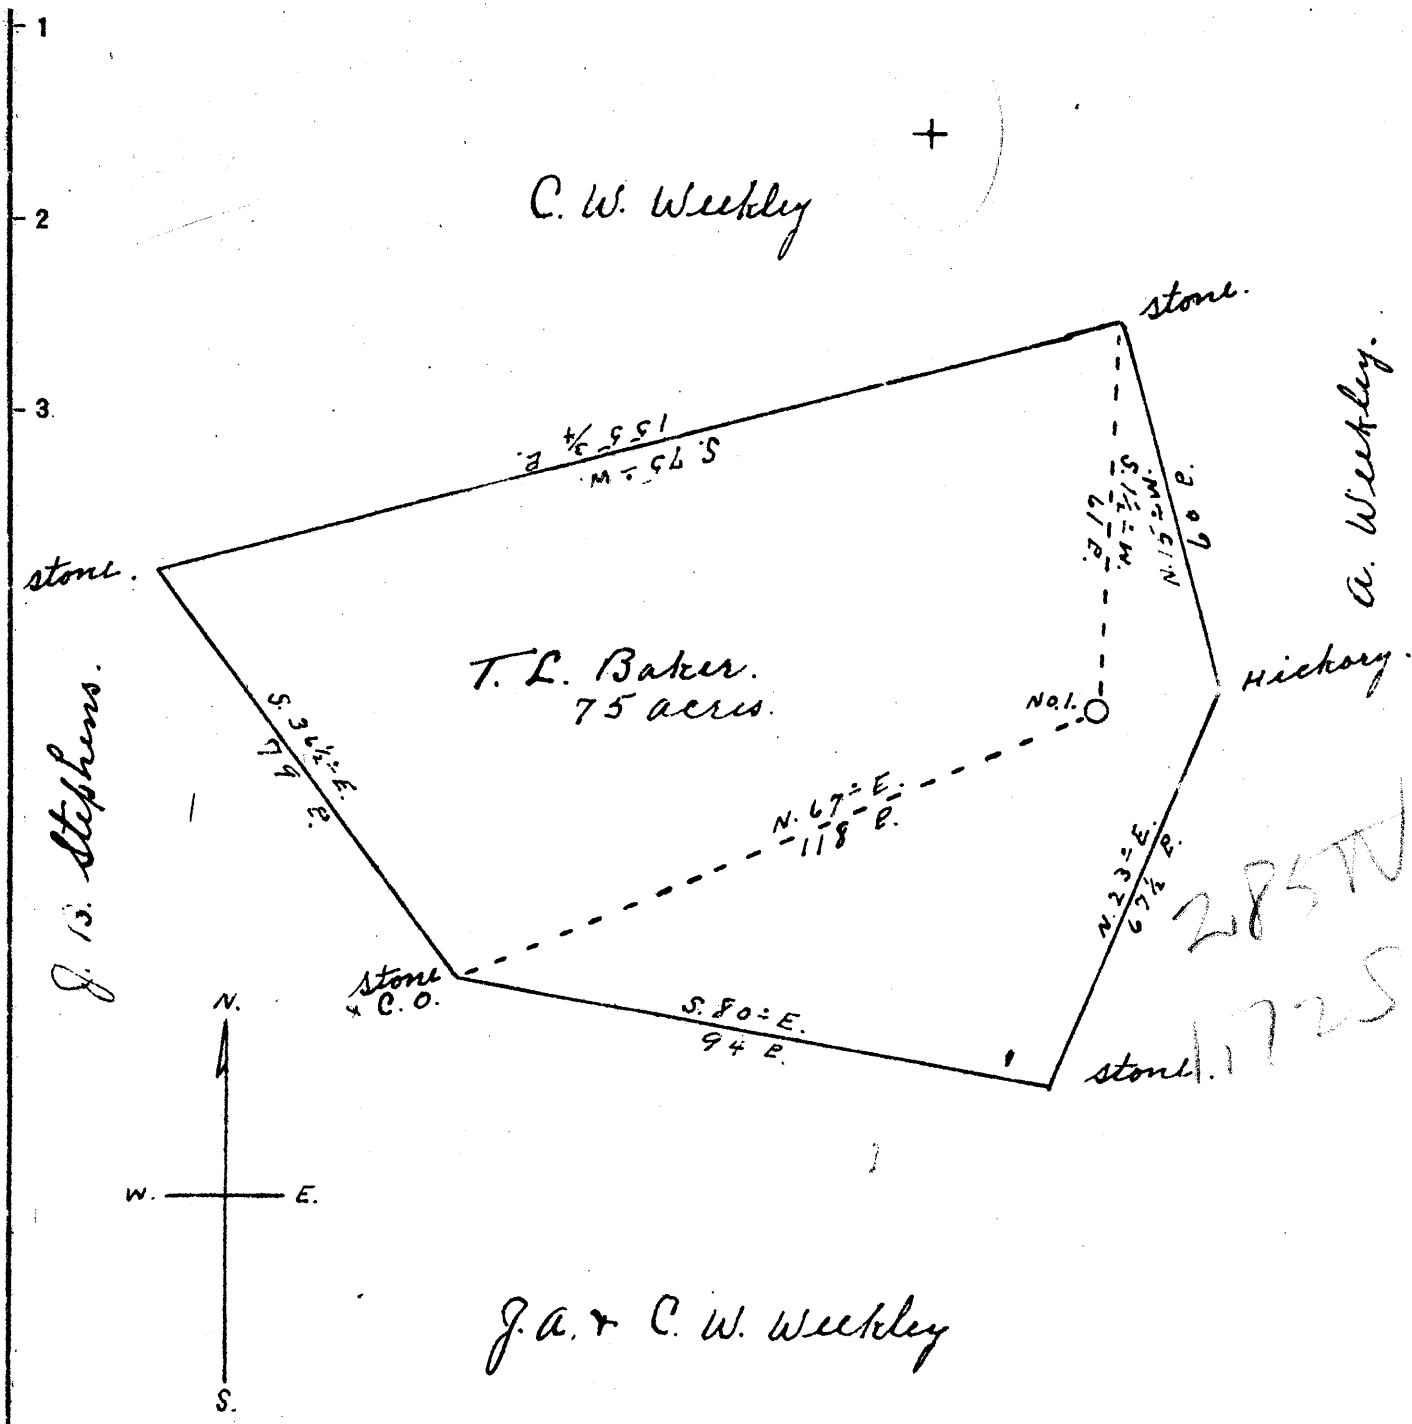

New Location   
 Drill Deeper   
 Abandonment

Company Morgan Petroleum Corp.  
 Address Akron, Ohio  
 Farm T.L. Baker  
 Tract \_\_\_\_\_ Acres 75 Lease No. \_\_\_\_\_  
 Well (Farm) No. 1 Serial No. \_\_\_\_\_  
 Elevation (Spirit Level) 910'  
 Quadrangle West Union  
 County Tyler District Edlsworth  
 Engineer Robert R. Anderson  
By Jno Triplett, Surveyor. 296  
 Engineer's Registration No. \_\_\_\_\_  
 File No. \_\_\_\_\_ Drawing No. \_\_\_\_\_  
 Date Aug. 7, 1950 Scale 1" = 30 P.

STATE OF WEST VIRGINIA  
 DEPARTMENT OF MINES  
 OIL AND GAS DIVISION  
 CHARLESTON

**WELL LOCATION MAP**  
 FILE NO. JYL-185

+ Denotes location of well on United States Topographic Maps, scale 1 to 62,500. latitude and longitude lines being represented by border lines as shown.

- Denotes one inch spaces on border line of original tracing.

WEST VIRGINIA DEPARTMENT OF MINES  
OIL & GAS DIVISION  
WELL RECORD

Permit No. Tyl 185  
West Union Quad.  
Company  
Address  
Farm  
Location  
Well No.  
District  
Surface  
Mineral  
Commenced  
Completed  
Not shot  
Fresh Water

Dry Hole  
CASING & TUBING

Morgan Petroleum Corp.  
109 N. Union St., Akron, Ohio 10 303  
Thos. L. Baker Heirs Acres 75 8 1200  
5 3/16 1937 Pld.  
Baker #1( MPC# WTY-1101) Elev. 910'  
Ellsworth Tyler County  
Thos. L. Baker Heirs, Gail Baker, Agt.  
Reader, W.Va.  
Morgan Petroleum Corp. 109 N. Union St.  
Akron, Ohio  
Oct. 20, 1950  
Dec. 1, 1950  
1/2 blr. per hr. 580'

Clay	0	8	Shale	1440	1465
Red	8	40	Sand	1465	1500
Shale Blue	40	63	Shale	1500	1555
Sand	63	75	Sand	1555	1620
Red	75	90	Shale Sandy	1620	1640
Shale Blue	90	101	Sand	1640	1661
Lime	101	118	Slate Black	1661	1708
Sand	118	145	Sand	1708	1734
Red	145	197	Shale Sandy	1734	1790
Shale Blue	197	233	Sand	1790	1830
Lime	233	260	Red Rock	1830	1840
Shale	260	310	Shale	1840	1853
Lime	310	335	Red Rock	1853	1962
Sand	335	372	Lime	1862	2015
Shale	372	377	Keener	2015	2065
Lime	377	389	Injun	2065	2190
Red Rock	389	395	Shale	2190	2253
Shale Blue	395	430	T.D.		2253
Lime	430	452			
Red Rock	452	460	Show oil and water 2015		
Lime	460	490	Water 2050		
Shale	490	500			
Lime	500	561			
Sand	561	595			
Shale	595	598			
Lime	598	612			
Shale	612	631			
Red Rock	631	638			
Shell	638	643			
Shale Blue	643	690			
Lime	690	728			
Shale	728	750			
Sand	750	792			
Lime	792	802			
Red Rock	802	826			
Shale	826	848			
Red	848	862			
Shale	862	875			
Red Rock	875	890			
Shale	890	911			
Red Rock	911	936			
Shale Blue	936	1012			
Red Rock	1012	1083			
Sand	1083	1094			
Pink	1094	1113			
Shale	1113	1170			
Pink	1170	1194			
Shale	1194	1225			
Sand	1225	1242			
Shale	1242	1312			
Sand	1312	1355			
Shale	1355	1428			
Shell Sandy	1428	1440			

H

1828  
1757  
1757