


70

Latitude 39 35

Longitude 81 00'

E. L. Robinson

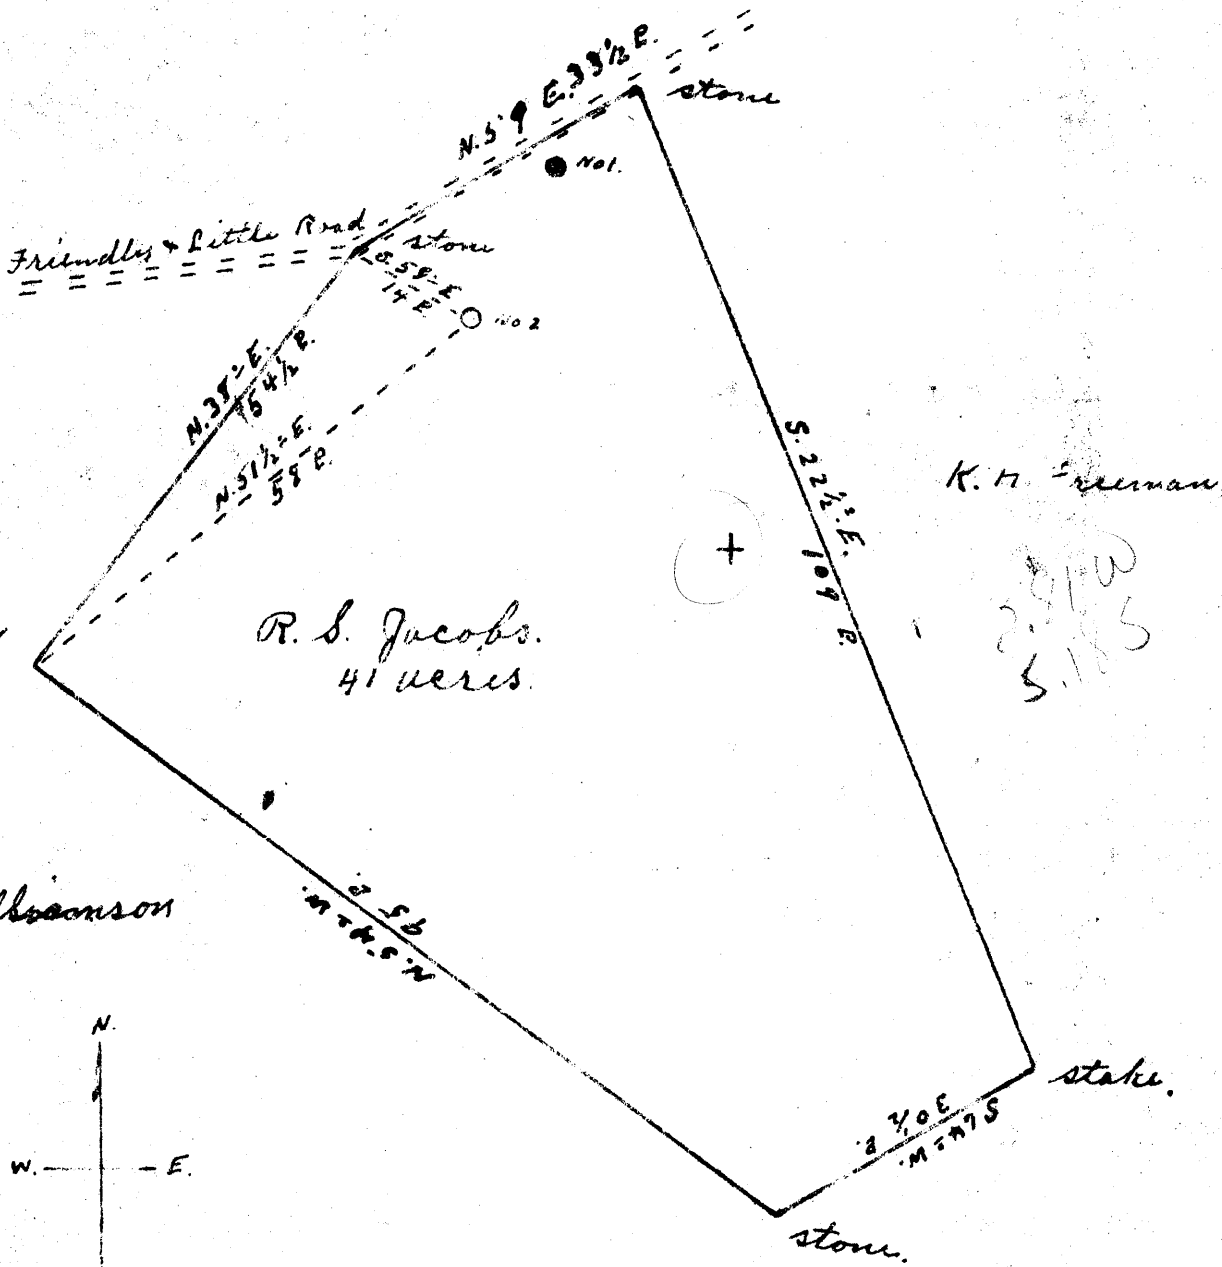

K. H. Freeman
 2.81 W
 5.18 S

K. H. Freeman

- New Location
- Drill Deeper
- Abandonment

Company R. S. Jacobs Oil Co.
 Address Friendly, W. Va.
 Farm R. S. Jacobs
 Tract _____ Acres 41 Lease No. _____
 Well (Farm) No. 2 Serial No. _____
 Elevation (Spirit Level) 860'
 Quadrangle New Matamoras
 County Tyler District Union
 Engineer Robert R. Anderson
By Jno. Triplett, Surveyor
 Engineer's Registration No. 296
 File No. _____ Drawing No. _____
 Date Oct. 2nd 1950 Scale 1" = 20 P.

STATE OF WEST VIRGINIA
 DEPARTMENT OF MINES
 OIL AND GAS DIVISION
 CHARLESTON

WELL LOCATION MAP
 FILE NO. JYL-190

- + Denotes location of well on United States Topographic Maps, scale 1 to 62,500, latitude and longitude lines being represented by border lines as shown.
- Denotes one inch spaces on border line of original tracing.

WEST VIRGINIA DEPARTMENT OF MINES
OIL & GAS DIVISION
W E L L R E C O R D

Permit No. Tyl 190
New Matamoras Quad.

Oil Well
CASING & TUBING

Company
Address
Farm
Location
Well No.
District
Surface

R.S. Jacobs et al
Ashtabula, Ohio
R.S. Jacobs Acres 42

	10	120		
	8½	927		
	6 5/8	1301		1301
	2			1627

2 Elev. 860'
Union Tyler County

R.S. Jacobs, 3410 Ann Ave.,
Ashtabula, Ohio
Mrs. A.M. Swisher, Friendly, W.Va.

Mineral
Commenced
Completed
Date shot

Oct. 23, 1950
Nov. 27, 1950
11-26-50 Depth 1624' to 1634'
with 20 qts. glycerine
80 bbls. 1st 24 hrs.

Oil

700
316
281

✓ Pgh. Coal	410	412	
Shale	412	470	
Lime	470	500	
Shale	500	515	
Red Rock	515	575	
Gray Mud	575	580	
Red Rock	580	623	
Lime	623	633	
Shale	633	670	
Red Rock	670	725	
Slate	725	980	
Sand	980	1000	
Shale	1000	1045	
Sand	1045	1125	
Lime	1125	1145	
Sand P.S.	1145	1200	
Slate	1200	1240	
✓ Sand	1240	1260	S.L.
Slate & Shells	1260	1355	
✓ Sand	1355	1425	
Slate & Shells	1425	1500	
Sand	1500	1525	
Slate	1525	1618	
✓ Big Injun	1618	1641	
T.D.	1641		

Oil 1627

NOTE: Well making 20 bbls. daily 4 months after completed.