


Latitude 39° 25'

Longitude 80° 50'

M^cCULLOUGH

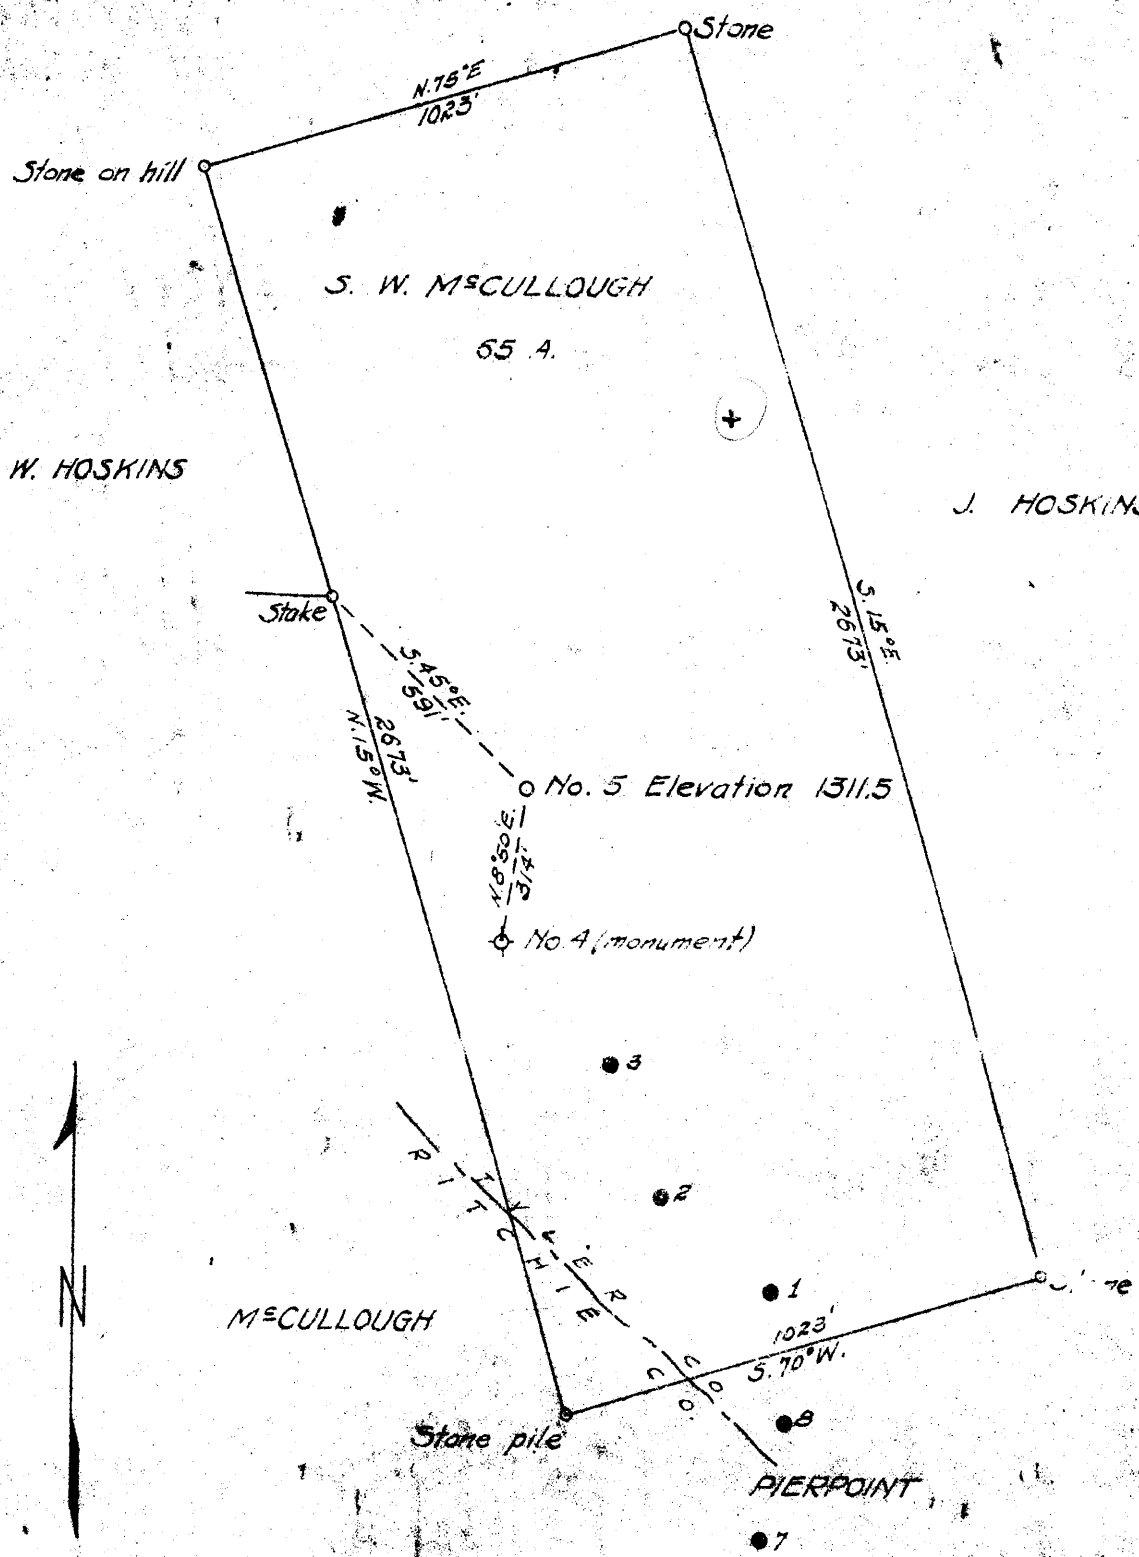

3300
33315

New Location
 Drill Deeper
 Abandonment

Company R. E. MARKLE, ETAL
 Address MOUNTAIN, W. VA.
 Farm S. W. M^cCULLOUGH
 Tract _____ Acres 65 Lease No. _____
 Well (Farm) No. 5 Serial No. _____
 Elevation (Spirit Level) 1311.5
 Quadrangle WEST UNION
 County TYLER District CENTERVILLE
 Engineer B. F. RINEHART
 Engineer's Registration No. 648
 File No. _____ Drawing No. 607-CT
 Date Feb. 27, 1951 Scale 1 in. = 400 ft.

STATE OF WEST VIRGINIA
 DEPARTMENT OF MINES
 OIL AND GAS DIVISION
 CHARLESTON

WELL LOCATION MAP
 FILE NO. JYL-195

+ Denotes location of well on United States Topographic Maps, scale 1 to 62,500, latitude and longitude lines being represented by border lines as shown.
 - Denotes one inch spaces on ruler line of original tracing.

WEST VIRGINIA DEPARTMENT OF MINES
OIL & GAS DIVISION
W E L L R E C O R D

Permit No. Tyl-195
West Union Quad.

Dry

Company	R. E. Markle et al	CASING & TUBING		
Address	Mountain, W. Va.			
Farm	S. W. McCullough Acres 65	10	65	Pulled
Location	Hughs River	8 $\frac{1}{4}$	846	Pulled
Well No.	5 Elev. <u>1311$\frac{1}{2}$</u>	6 5/8	1286	Pulled
District	<u>Centerville</u> County - Tyler			
Surface	S. W. McCullough, Mountain, W. Va.			
Mineral	J. L. McCullough Hrs., Mountain, W. Va.			
Commenced	2/21/51			
Completed	<u>3/15/51</u>			
Oil	1/2 bbls.			

Soil	0	10	Slate	843.	860
Sand	10	60	Sand	860	880
Slate	60	100	Slate	880	935
Lime	100	110	Lime	935	940
Red	110	150	Slate	940	945
Slate	150	200	Pitt. Coal	945	946
Sand	200	220	Lime Pitt.	946	960
Red	220	260	Slate	960	1055
Slate & Shells	260	400	Red	1055	1070
Red	400	450	Slate & Shells	1070	1110
Lime	450	465	Red	1110	1140
Red	465	500	Slate & Shells	1140	1235
Lime	500	510	Black Slate	1235	1260
Red	510	530	Pink Rock	1260	1265
Slate	530	550	Blue Slate	1265	1286
Red	550	605	Gray Sand	1286	1293
Slate & Shells	605	620	Cow Run Sand	1293	1325
Red Rock	620	630	Slate	1325	1330
Slate	630	650	BOTTOM OF HOLE		<u>1330</u>
Sand	650	665			
Red	665	690			
Sand	690	705			
Red	705	725			
Slate	725	735			
Red	735	765			
Lime	765	770			
Red	770	795			
Sand	795	843			

1072
745
367