


DM

Latitude 39° 25'

Longitude 80° 55'

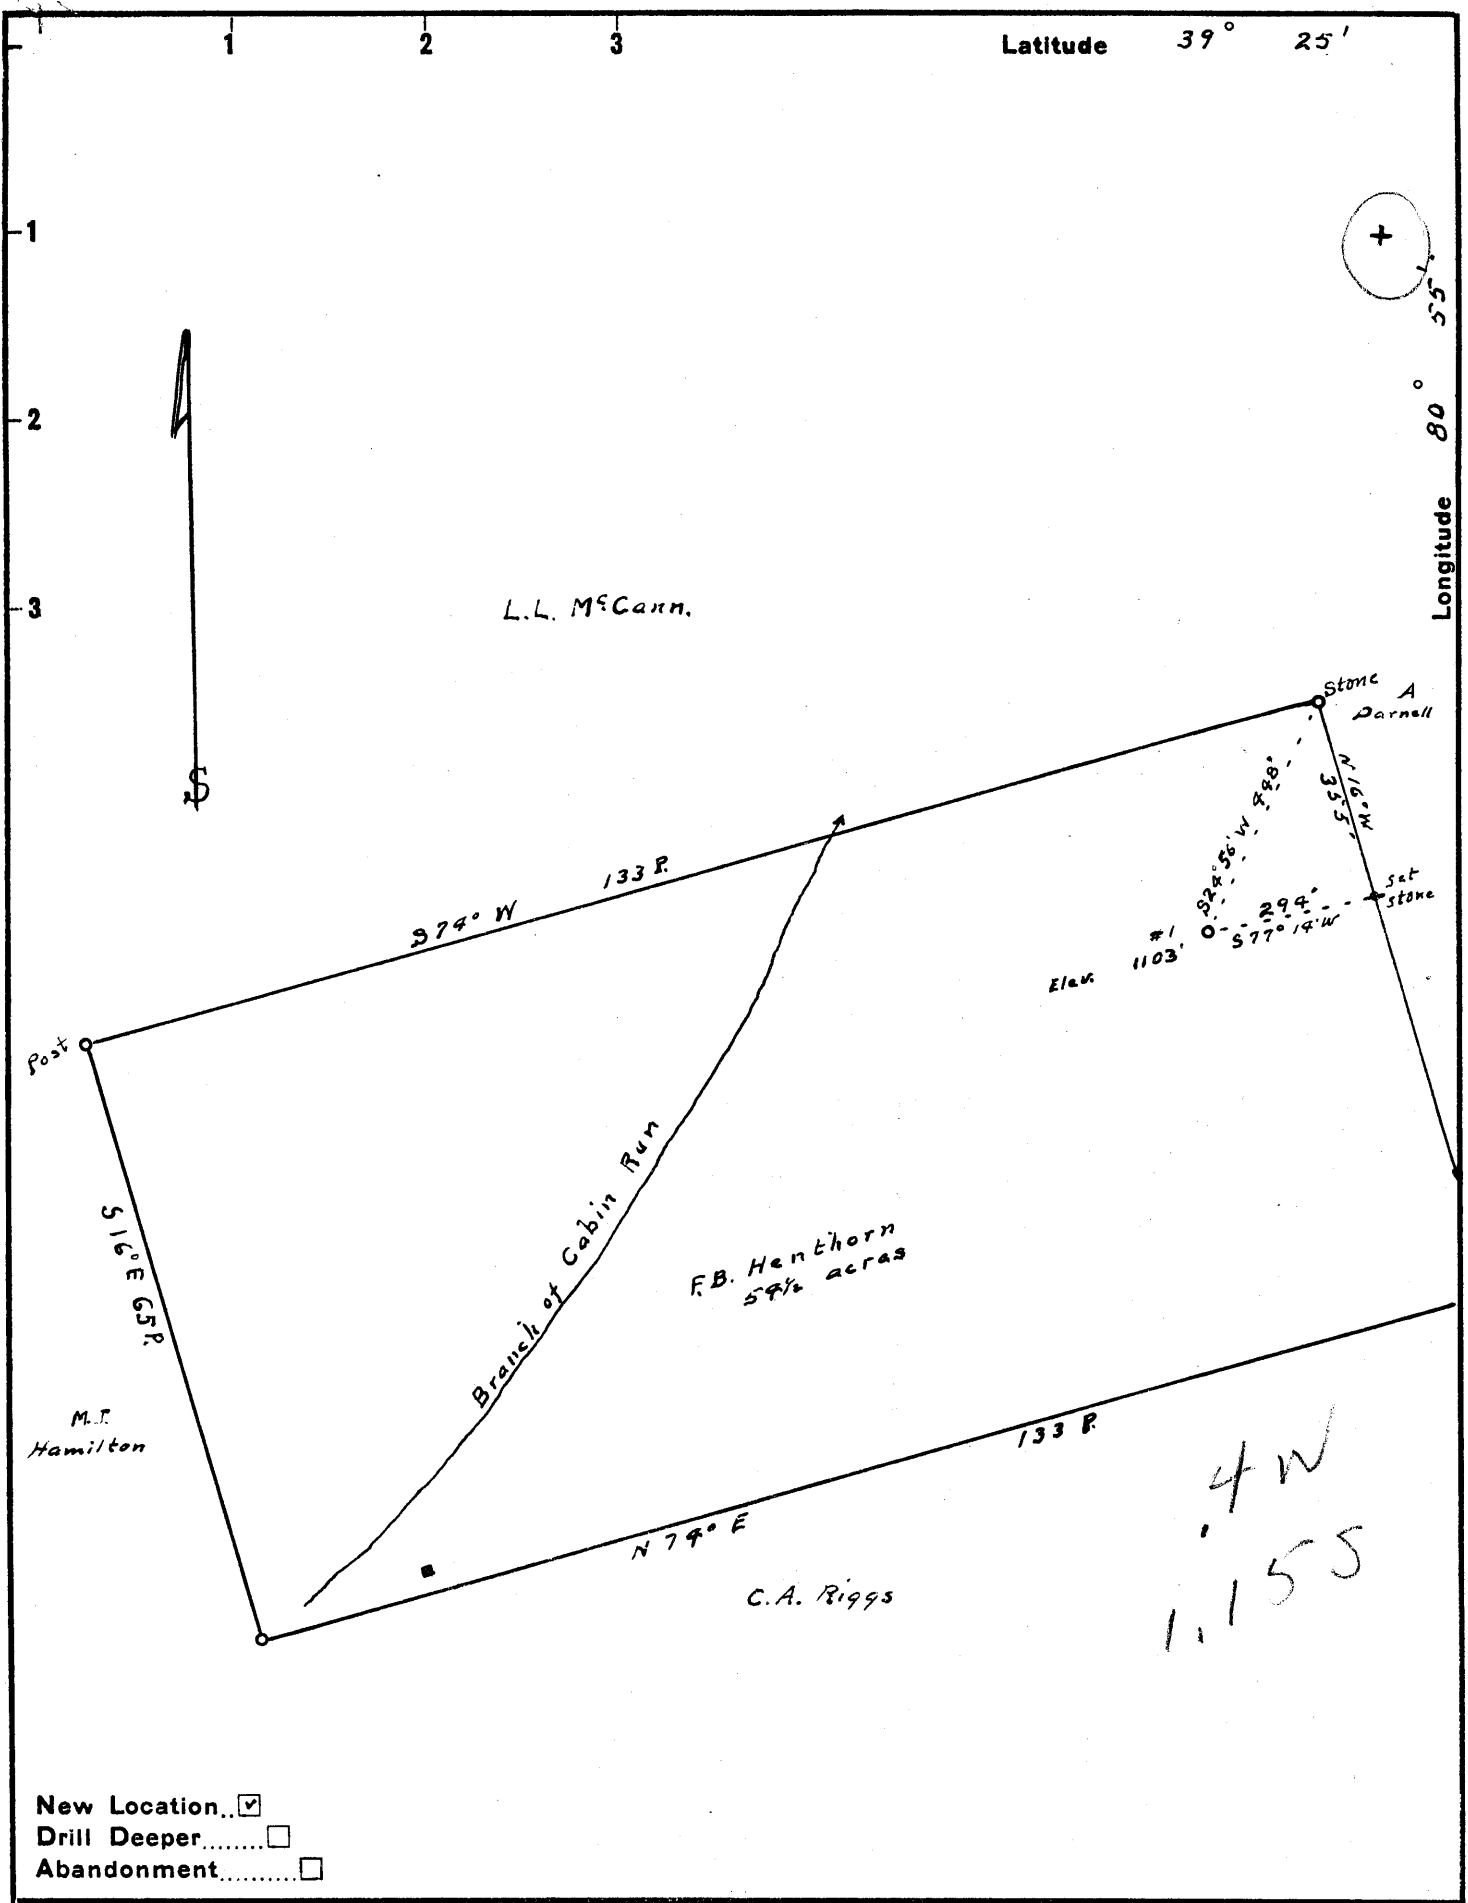

New Location..
 Drill Deeper.....
 Abandonment.....

Company C. H. L. Oil and Gas Co.
 Address 202 4th St Parkersburg, W. Va.
 Farm F.B. Henthorn
 Tract _____ Acres 59 1/2 Lease No. _____
 Well (Farm) No. 1 Serial No. _____
 Elevation (Spirit Level) 1103
 Quadrangle West Union — NW
 County Tyler District Centerill
 Engineer Robert R. Anderson
by O. Meredith
 Engineer's Registration No. 296
 File No. _____ Drawing No. _____
 Date 7/20 52 Scale 1 in = 20 Poles

STATE OF WEST VIRGINIA
 DEPARTMENT OF MINES
 OIL AND GAS DIVISION
 CHARLESTON

WELL LOCATION MAP
 FILE NO. JyL-221

+ Denotes location of well on United States Topographic Maps, scale 1 to 62,500, latitude and longitude lines being represented by border lines as shown.
 — Denotes one inch spaces on border line of original tracing.

5-0 0

STATE OF WEST VIRGINIA
DEPARTMENT OF MINES
OIL AND GAS DIVISION 6

Quadrangle West Union

WELL RECORD

Permit No. TYL-221-R

Oil or Gas Well DRY

(KIND)


Company C-H-L Oil and Gas Company
 Address 202 - 4th Street-Parkersburg, W. Va.
 Farm F. B. Henthorn Acres 54
 Location (waters) Br. of Cabin Run
 Well No. 1 Elev. 1103
 District Centerville County Tyler
 The surface of tract is owned in fee by F. B. Henthorn
 Address Colliers, W. Va.
 Mineral rights are owned by Same
 Address _____
 Drilling commenced June 24, 1953
 Drilling completed July 31, 1953
 Date Shot _____ From _____ To _____
 With _____
 Open Flow _____ /10ths Water in _____ Inch
 _____ /10ths Merc. in _____ Inch
 Volume _____ Cu. Ft.
 Rock Pressure _____ lbs. _____ hrs.
 Oil _____ bbls., 1st 24 hrs.
 Fresh water _____ feet _____ feet
 Salt water 2088' feet 2092' feet

Casing and Tubing	Used in Drilling	Left in Well	Packers
Size			
16			Kind of Packer _____
13			
10	311'	311'	Size of _____
8 1/4	1195'	1195'	
6 1/2			Depth set _____
5 3/16	1978'	1978'	
3			Perf. top _____
2			Perf. bottom _____
Liners Used			Perf. top _____
			Perf. bottom _____

CASING CEMENTED _____ SIZE _____ No. Ft. _____ Date _____

COAL WAS ENCOUNTERED AT _____ FEET _____ INCHES
 _____ FEET _____ INCHES _____ FEET _____ INCHES
 _____ FEET _____ INCHES _____ FEET _____ INCHES

Formation	Color	Hard or Soft	Top	Bottom	Oil, Gas or Water	Depth Found	Remarks
Surface			0	30			
Sand			30	40			
Red Rock			40	100			
Sand			100	130			
Red Rock			130	230			
Lime			230	247			
Red Rock			247	255			
Red Lime			255	275			
Red Rock			275	286			
Slate			286	289			
Sand			289	293			
Red Rock			293	310			
Sand			310	324			
Red Rock			324	335			
Slate			335	351			
Red Rock			351	380			
Slate-shells			380	410			
Red Rock			410	470			
Sand			470	486			
Red Rock			486	510			
Slate-shells			510	556			
Sand			556	592			
Red Rock			592	595			
Lime-Slate			595	620			
Lime			620	670			
Red Rock			670	675			
Slate			675	690			
Sand			690	725			
Slate			725	760			
Lime			760	776			
Slate			776	788			
Lime			788	793			
Slate			793	800			
Lime			800	810			
Slate-shells			810	890			
Lime			890	894			
Slate			894	945			
Red Rock			945	967			
Lime			967	970			

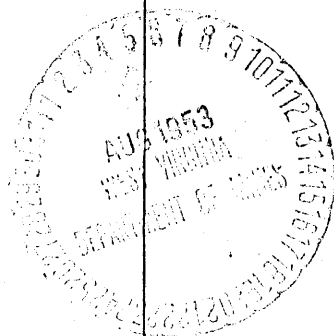

(Over)

(Over)

Formation	Color	Hard or Soft	Top	Bottom	Oil, Gas or Water	Depth Found	Remarks
Red Rock			970	1020			
Lime			1020	1030			
Pink Rock			1030	1040			
Lime			1040	1073			
Slate			1073	1092			
Pink Rock			1092	1111			
Broken Lime			1111	1175			
Slate			1175	1182			
Sand			1182	1206			
Slate			1206	1212			
Lime			1212	1242			
Sand			1242	1276			
Slate			1276	1294			
Pink Rock			1294	1295			
GAS SAND			1315	1330			
Lime			1330	1385			
FIRST SLAT SAND			1385	1425			
Slate			1425	1440			
SECOND SALT SAND			1440	1500			
Broken Lime			1500	1520			
Slate			1520	1525			
THIRD SALT SAND			1525	1615			
Slate-shells			1615	1633			
Sand			1633	1645			
Black Lime			1645	1658	1960		
Gritty Lime			1658	1680	1103		
Sand			1680	1695			
Slate-shells			1695	1790			
Sand			1790	1817			
Black Slate			1817	1825			
Black Lime			1825	1875			
MAXON SAND			1875	1894			
Slate			1894	1926			
Lime			1926	1940			
BIG LIME			1940	1943			
Little Lime			1943	1960			
BIG LIME			1960	2020			
Sand			2020	2025			
Lime			2025	2037			
BIG INJUN			2037	2108			
Show of Gas			2077	2092			
Water			2088	2092			
Total Depth				2108			

Date _____, 19____

APPROVED _____, Owner

By _____

(Title)