

- New Location..
- Drill Deeper.....
- Abandonment.....

Company Canon Oil Production
 Address 21 E. Grand Ave. Highland Park, Mich.
 Farm W. H. Slider
 Tract _____ Acres 77 Lease No. _____
 Well (Farm) No. 1 Serial No. _____
 Elevation (Spirit Level) 962'
 Quadrangle West Union
 County Tyler District Meade
 Engineer Robert R. Anderson
By Geo. Triplett, Surveyor.
 Engineer's Registration No. 296
 File No. _____ Drawing No. _____
 Date July 26, 1955 Scale 1" = 30 P.

STATE OF WEST VIRGINIA
 DEPARTMENT OF MINES
 OIL AND GAS DIVISION
 CHARLESTON

WELL LOCATION MAP
 FILE NO. JYL-238

+ Denotes location of well on United States Topographic Maps, scale 1 to 62,500, latitude and longitude lines being represented by border lines as shown.

- Denotes one inch spaces on border line of original tracing.



STATE OF WEST VIRGINIA
DEPARTMENT OF MINES
OIL AND GAS DIVISION

Quadrangle West Union

WELL RECORD

Permit No. TYL 238

Oil or Gas Well Oil & Gas
(KIND)

Company Canon Oil Production
Address 13015 Puritan Ave., Detroit, Mich
Farm Sliter, W. H. Acres 89
Location (waters) _____
Well No. 1. Elev. 1000' 962
District Meade County Tyler
The surface of tract is owned in fee by Willis and Grace
Sliter Address New Martinsville,
Mineral rights are owned by _____
(W. Va.)
Address _____

Casing and Tubing	Used in Drilling	Left in Well	Packers
Size			Kind of Packer
16			
13	19'	19'	
10	220.10		Size of
8 1/4	936	763	Depth set
6 1/2	1516	1516	
5 3/16			
3			Perf. top
2			Perf. bottom
Liners Used			Perf. top
			Perf. bottom

Drilling commenced August 22, 1955
Drilling completed November 2, 1955
Date Shot From 1728 To 1738

With Nitro _____

Open Flow /10ths Water in _____ Inch
/10ths Merc. in _____ Inch
Volume _____ Cu. Ft.

Rock Pressure _____ lbs. _____ hrs.

Oil 10 bbls _____ bbls., 1st 24 hrs.

Fresh water _____ feet _____ feet

Salt water _____ feet _____ feet


CASING CEMENTED _____ SIZE _____ No. Ft. _____ Date _____

COAL WAS ENCOUNTERED AT _____ FEET _____ INCHES

_____ FEET _____ INCHES _____ FEET _____ INCHES

_____ FEET _____ INCHES _____ FEET _____ INCHES

Formation	Color	Hard or Soft	Top	Bottom	Oil, Gas or Water	Depth Found	Remarks
Clay	red	Soft	0	18			
Red Rock	red	Soft	18	60			
Lime	white	Soft	60	75			
Red Rock	red	Soft	75	120			
Sand	grey	Hard	120	130			
Slate & Shells	white						
Sand	gr.Br.	M. Hard	130	195			
Slate & Lime Shells	grey	Hard	195	205			
Sand	Wh.						
Red Rock	Gr.Br.	M. Hard	205	305			
Red Rock & Lime Shells	white	Hard	305	385			
Sand	Red	Soft	385	735			
Slate & Shells	Red Gr.						
Sand	White	M. Hard	735	843			
Slate & Shells	White	Hard	843	848			
Sand	Gr.Br.Wh.	Soft	848	980			
Slate	Grey	M. Hard	980	1003			
Sand	Grey	Soft	1003	1129			
Slate	White	Hard	1129	1182			
Sand	Grey	Soft	1182	1370			
Slate	Grey	Hard	1370	1491			
Sand	Brown	Soft	1491	1503			
Slate	Grey	Hard	1503	1507			
Sand	Brown	Soft	1507	1545			
Slate	White	Hard	1545	1585			
Sand	Black	Soft	1585	1700			
Slate	White	M. Hard	1700	1748			
Sand (Maxon)	White				Oil & Gas	1728-1738	Open Flow Appr 10 BBL
Slate	Grey	M. Hard	1748	1755			
Lime (Big)	White	Hard	1755	1819			
Sand (Keener)	White	Hard	1819	1829			
Slate	Grey	Hard	1829	1844			
Sand	White	Hard	1844	1981	(Big Injun)		

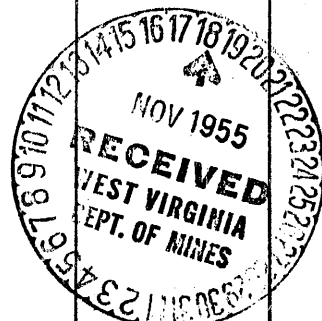

1755
962
793