
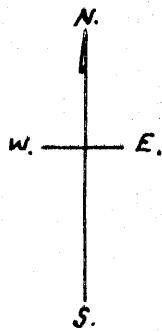


Latitude 39° 55'

2615
0.25W

Longitude 81° 00'

Geo. Hissim

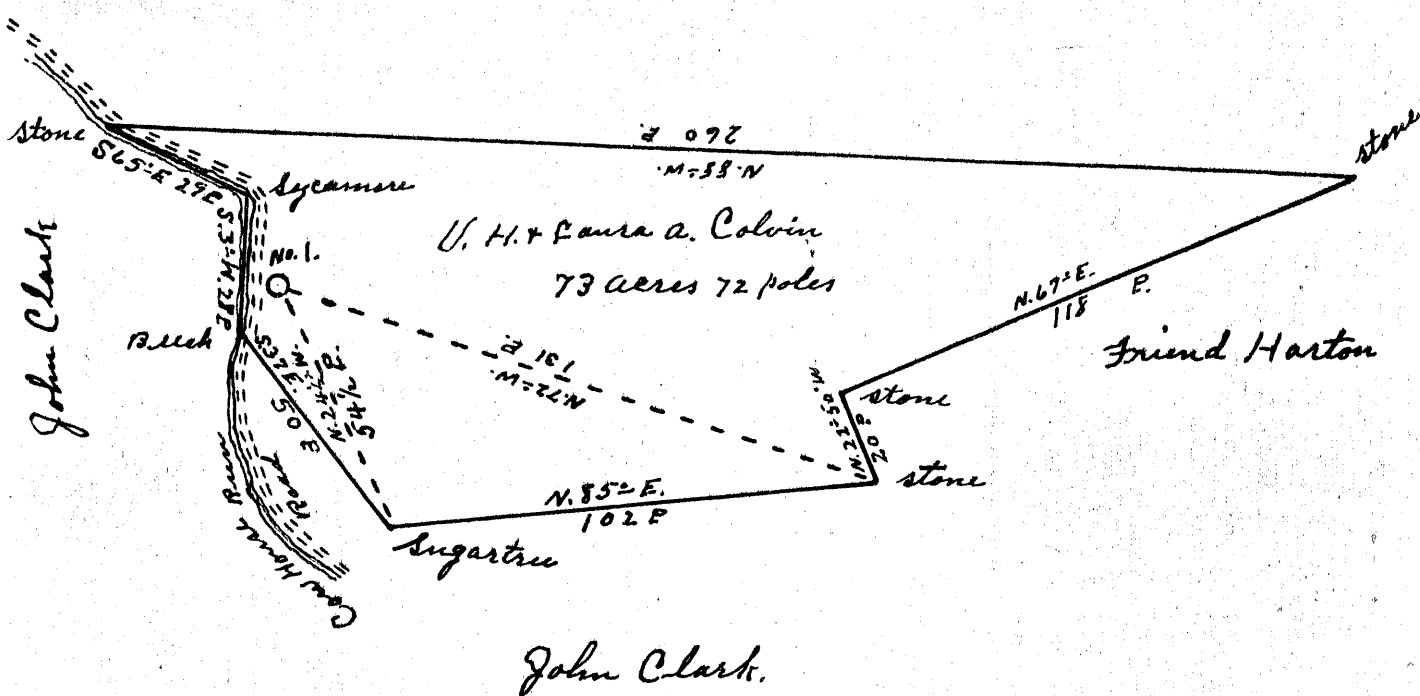

New Location..
 Drill Deeper.....
 Abandonment.....

Company R. A. Alkins & Others.
 Address St. Marys W. Va.
 Farm U. H. & Laura A. Colvin
 Tract _____ Acres 73 7/8 Lease No. _____
 Well (Farm) No. 1. Serial No. _____
 Elevation (Spirit Level) 702'
 Quadrangle New Matamoras
 County Tyler District Lincoln
 Engineer Robert R. Anderson
By Geo. Triplett, Surveyor
 Engineer's Registration No. 296
 File No. _____ Drawing No. _____
 Date Oct. 1, 1956 Scale 1" = 40 F.

STATE OF WEST VIRGINIA
 DEPARTMENT OF MINES
 OIL AND GAS DIVISION
 CHARLESTON

WELL LOCATION MAP
 FILE NO. JYL-255

+ Denotes location of well on United States Topographic Maps, scale 1 to 62,500, latitude and longitude lines being represented by border lines as shown.

- Denotes one inch spaces on border line of original tracing.

6-0 28



STATE OF WEST VIRGINIA
DEPARTMENT OF MINES
OIL AND GAS DIVISION

Quadrangle WV Metamoras

WELL RECORD

Permit No. Tyl-255

Oil or Gas Well Dry
(KIND)

Company R. A. Alkire ET AL
 Address St. Marys, West Virginia.
 Farm V. H. & Laura A. Colvin Acres 73+
 Location (waters) _____
 Well No. 1 Elev. 702
 District Lincoln County Tyler
 The surface of tract is owned in fee by _____
 Address _____
 Mineral rights are owned by _____
 Address _____
 Drilling commenced April 15, 1957
 Drilling completed April 30, 1957
 Date Shot _____ From _____ To _____
 With No shot or frac.
 Open Flow /10ths Water in _____ Inch
/10ths Merc. in _____ Inch
 Volume _____ Cu. Ft.
 Rock Pressure _____ lbs. _____ hrs.
 Oil _____ bbls., 1st 24 hrs.
 Fresh water _____ feet _____ feet
 Salt water _____ feet _____ feet

Casing and Tubing	Used in Drilling	Left in Well	Packers
Size			Kind of Packer
16			
13			
10	164	164	Size of
8 1/2	765	765	
6	1382	1382	Depth set
5 3/16			
3			Perf. top
2			Perf. bottom
Liners Used			Perf. top
			Perf. bottom

CASING CEMENTED _____ SIZE _____ No. Ft. _____ Date _____
 None

COAL WAS ENCOUNTERED AT None FEET _____ INCHES
 _____ FEET _____ INCHES FEET _____ INCHES
 _____ FEET _____ INCHES FEET _____ INCHES

Formation	Color	Hard or Soft	Top	Bottom	Oil, Gas or Water	Depth Found	Remarks
Gravel			0	10			
Shale	Red		10	40			
Shale	Grey		40	130			
Sand			130	163	Water	140'	
Shale			163	190			
Sand			190	235			
Shale			235	380			
Shale	Red		380	420			
Shale	Grey		420	530	1382		
Shale	Red		530	640	702		
Shale	Grey		640	680	786		
Sand			680	695			
Shale	Red		695	748			
Shale	Grey		748	805			
Sand			805	865			
Slate	Black		865	910			
Sand			910	980			
Slate	Black		980	1000			
Sand			1000	1070	Gas (show)	1030-38	
Slate			1070	1130	Water (salt)	1055'	
Sand			1130	1185			
Slate			1185	1220			
Sand			1220	1288	Gas (show)	1275-85'	
Slate	Black		1288	1388			
Lime			1388	1410			
Sand (Keener)			1410	1455			
Sand (Injun)			1455	1587.5			
Slate			1585	1589			
Total Depth			1589'				

