

Royalty Owners:  
 A. E. Doak & Quaker States Oil Co.  
 Coal Owners: Quaker States Oil Co.

New Location...   
 Drill Deeper.....   
 Abandonment.....

No mineable coal.

Company Bachelor, Ray, Inc.  
 Address Hartman Oil & Gas Co. Parker Apartment, W. Va.  
 Farm Eld's Jenkins  
 Tract 1 Acres 46 1/2 Lease No. \_\_\_\_\_  
 Well (Farm) No. 1 Serial No. \_\_\_\_\_  
 Elevation (Spirit Level) 1098.00'  
 Quadrangle West Union - C  
 County Tyler District Centerville  
 Engineer George Z. McArthur  
 Engineer's Registration No. 1187  
 File No. O & G - D. R. Drawing No. \_\_\_\_\_  
 Date 3-11-59 Scale 1" = 300'

STATE OF WEST VIRGINIA  
 DEPARTMENT OF MINES  
 OIL AND GAS DIVISION  
 CHARLESTON

WELL LOCATION MAP  
 FILE NO. JYL-267

+ Denotes location of well on United States Topographic Maps, scale 1 to 62,500, latitude and longitude lines being represented by border lines as shown.

- Denotes one inch spaces on border line of original tracing.



STATE OF WEST VIRGINIA  
DEPARTMENT OF MINES  
OIL AND GAS DIVISION

Quadrangle West Union

WELL RECORD

Permit No. 742 267


Oil or Gas Well Oil  
(K/ND)

Company Bachelor Ray Inc  
Address Mountain View  
Farm Ellis Jenkins Heirs Acres 50  
Location (waters) Middle Island  
Well No. 1 Elev. 1098.00'  
District CENTERVILLE County \_\_\_\_\_  
The surface of tract is owned in fee by Ellis Jenkins Heirs  
Address Joseph's Mills  
Mineral rights are owned by \_\_\_\_\_  
Address \_\_\_\_\_  
Drilling commenced 3/29/58  
Drilling completed 4/9/58  
Date Shot No shot From \_\_\_\_\_ To \_\_\_\_\_  
With \_\_\_\_\_  
Open Flow \_\_\_\_\_ /10ths Water in \_\_\_\_\_ Inch  
\_\_\_\_\_ /10ths Merc. in \_\_\_\_\_ Inch  
Volume \_\_\_\_\_ Cu. Ft.  
Rock Pressure \_\_\_\_\_ lbs. \_\_\_\_\_ hrs.  
Oil None bbls., 1st 24 hrs.  
Fresh water \_\_\_\_\_ feet  
Salt water \_\_\_\_\_ feet

Casing and Tubing	Used in Drilling	Left in Well	Packers
Size			Kind of Packer
16			
13			
10			Size of
8 1/4	<u>786'</u>		Depth set
6 5/8			
5 3/16			Perf. top
3			Perf. bottom
2			Perf. top
Liners Used			Perf. bottom

CASING CEMENTED \_\_\_\_\_ SIZE \_\_\_\_\_ No. Ft. \_\_\_\_\_ Date \_\_\_\_\_  
COAL WAS ENCOUNTERED AT \_\_\_\_\_ FEET \_\_\_\_\_ INCHES  
\_\_\_\_\_ FEET \_\_\_\_\_ INCHES FEET \_\_\_\_\_ INCHES  
\_\_\_\_\_ FEET \_\_\_\_\_ INCHES FEET \_\_\_\_\_ INCHES

Formation	Color	Hard or Soft	Top	Bottom	Oil, Gas or Water	Depth Found	Remarks
	Sand		0	14			
	slate		58 7/8	60			
	Red		60	73			
	sand		75	125			
	slate		125	150			
	Red		150	180			
	slate		180	200			
	shells		200	225			
	Red		225	285			
	slate		285	300			
	Red		300	315			
	slate		315	335			
	Red		335	365			
	slate		365	386			
	Sand		385	407			
	Red		407	426			
	lime		420	535			
	slate		535	540			
	sand		540	615			
	slate		615	675			
	shells		675	705			
	Red		705	706	<u>Blowdown</u>		
	lime		706	720			
	slate		720	830			
	shells		830	836			
	Red		836	900			
	slate		900	925			
	Red		925	955			
	slate		955	960			
	Red		960	995			
	slate	<u>white</u>	995	1010			
	slate	<u>Black</u>					

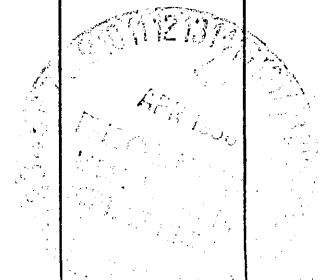

Formation	Color	Hard or Soft	Top <i>9</i>	Bottom	Oil, Gas or Water	Depth Found	Remarks
	Slate		<del>1010</del>	1010			
Pink	Rock		1010	1020			
	Lime		1020	1025			
	Slate		1025	1030			
Pink	Rock		1030	1035			
	Rock		1035	1040			
<del>Gray</del>	<del>Sand</del>	Slate	1040	1050			
Gray	Sand		1050	1060			
C. R.	Sand		1060	1090			
	Slate		1090	1103			
	Bottom of hole		1103				

*Bachelor Payne*

Date *Apr 11/58*, 19\_\_

APPROVED *W. Albert Bachelor*, Owner

By \_\_\_\_\_ (Title)