


Latitude 39° 35'

Longitude 80° 55'

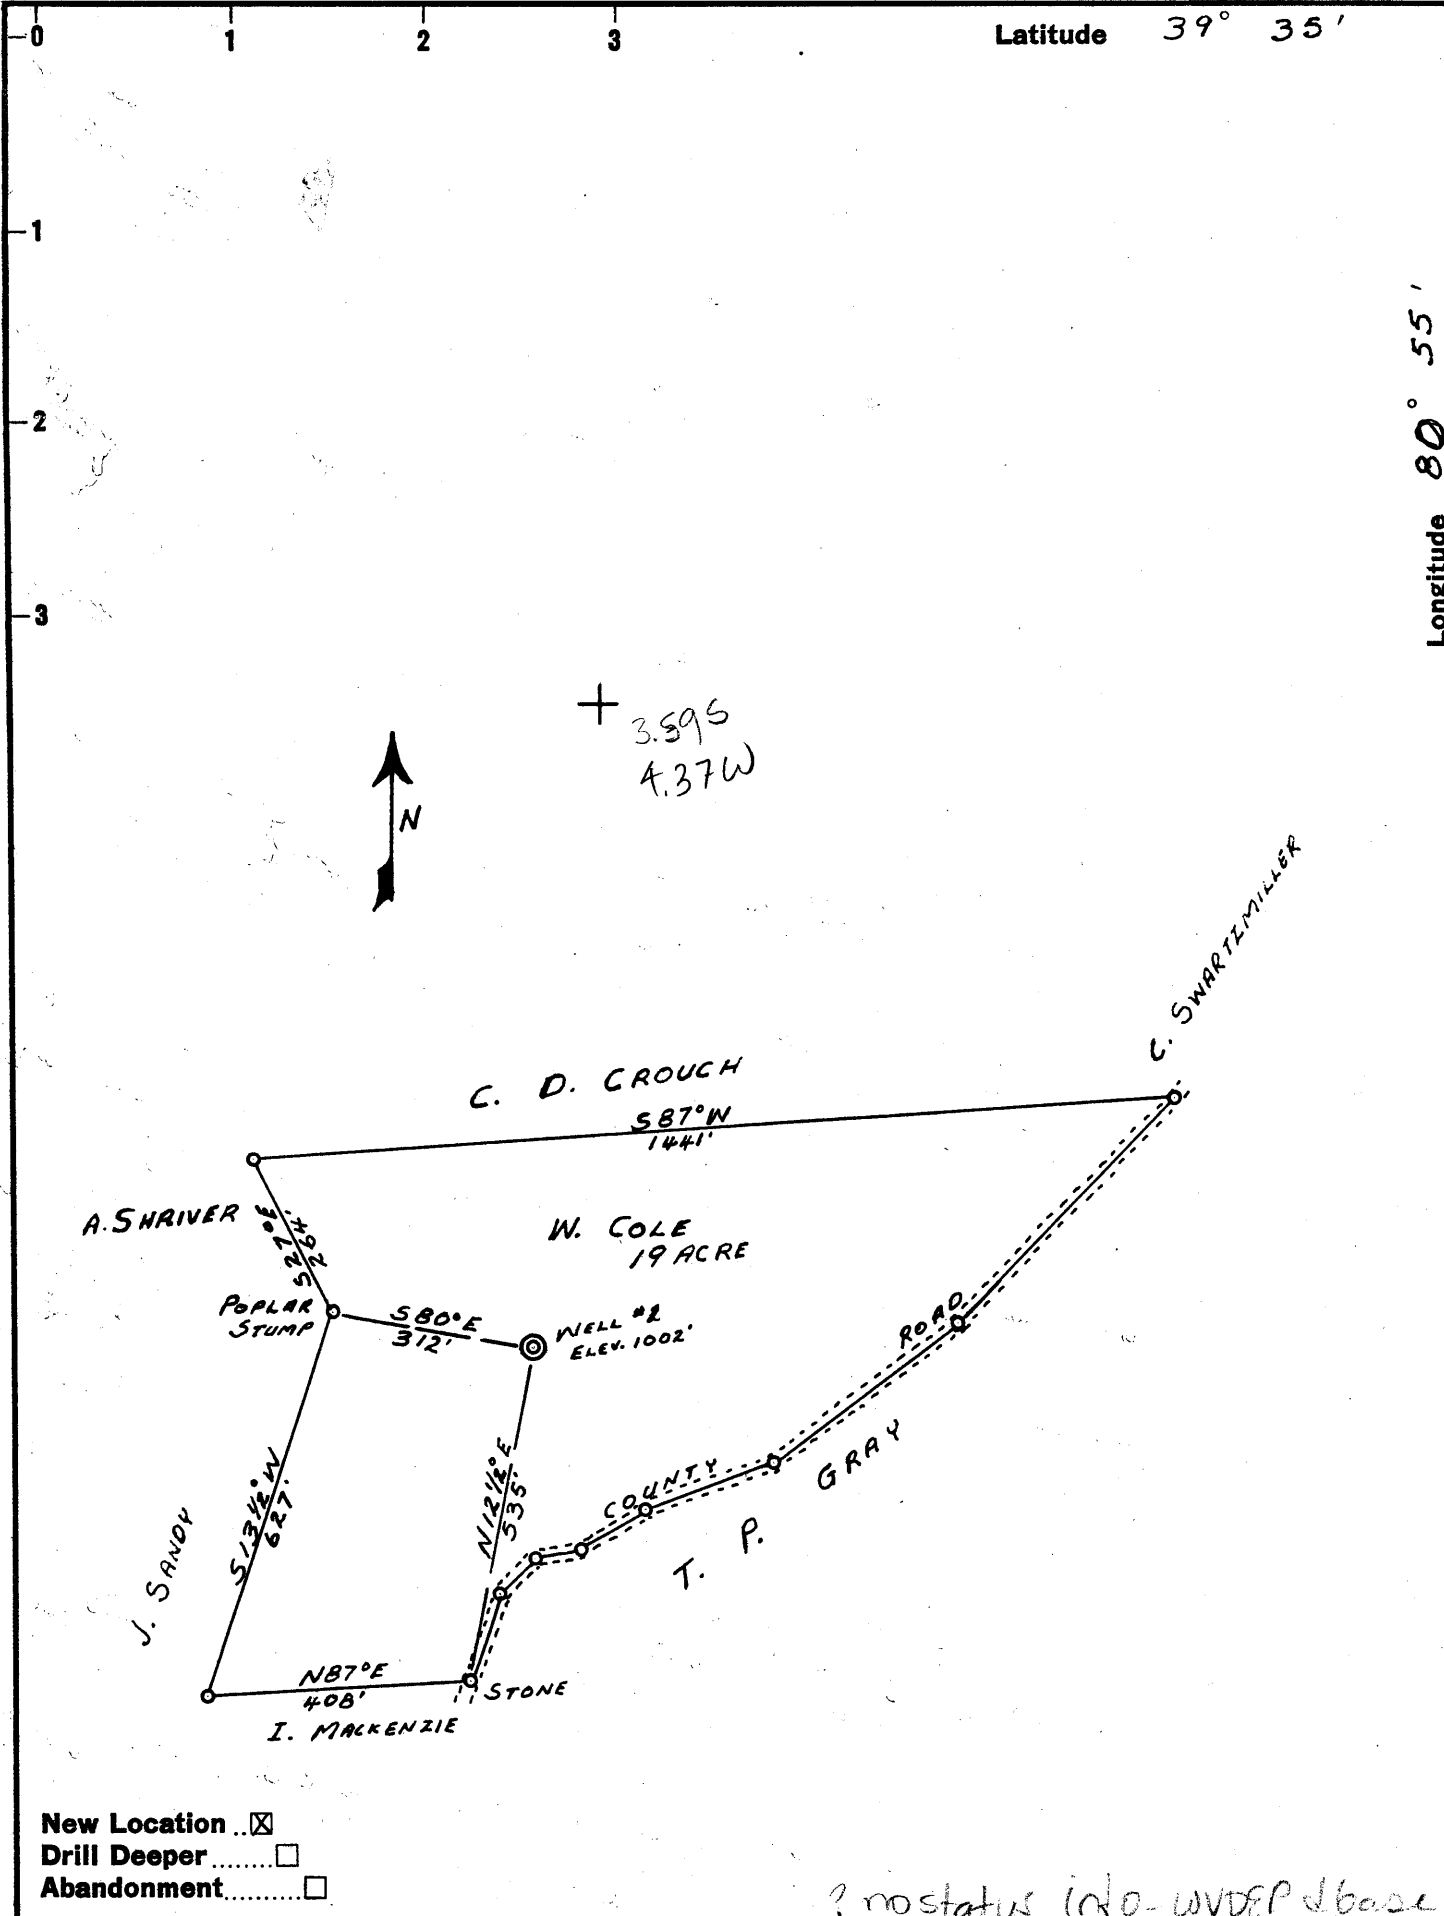

New Location
 Drill Deeper
 Abandonment

? no status info - WV DEP database

Company WALLACE H COLE
IAN G. MACKENZIE
 Address 9120 E. MARGINAL WAY, SEATTLE 98148
6401 LANSDOWNE AVE. UPPER DARBY, PA.

Farm WALLACE COLE

Tract _____ Acres 19 Lease No. _____

Well (Farm) No. 1 Serial No. _____

Elevation (Spirit Level) 1002'

Quadrangle NEW MARTINSVILLE, W.VA SW

County TYLER District LINCOLN

Engineer George L. Mc Intire

Engineer's Registration No. 1187

File No. _____ Drawing No. _____

Date OCTOBER 1961 Scale 1" = 300'

STATE OF WEST VIRGINIA
 DEPARTMENT OF MINES
 OIL AND GAS DIVISION
 CHARLESTON

WELL LOCATION MAP
 FILE NO. TYL-323-REVISED
5-15-62

+ Denotes location of well on United States Topographic Maps, scale 1 to 62,500, latitude and longitude lines being represented by border lines as shown.

- Denotes one inch spaces on border line of original tracing.