
CHOODD -

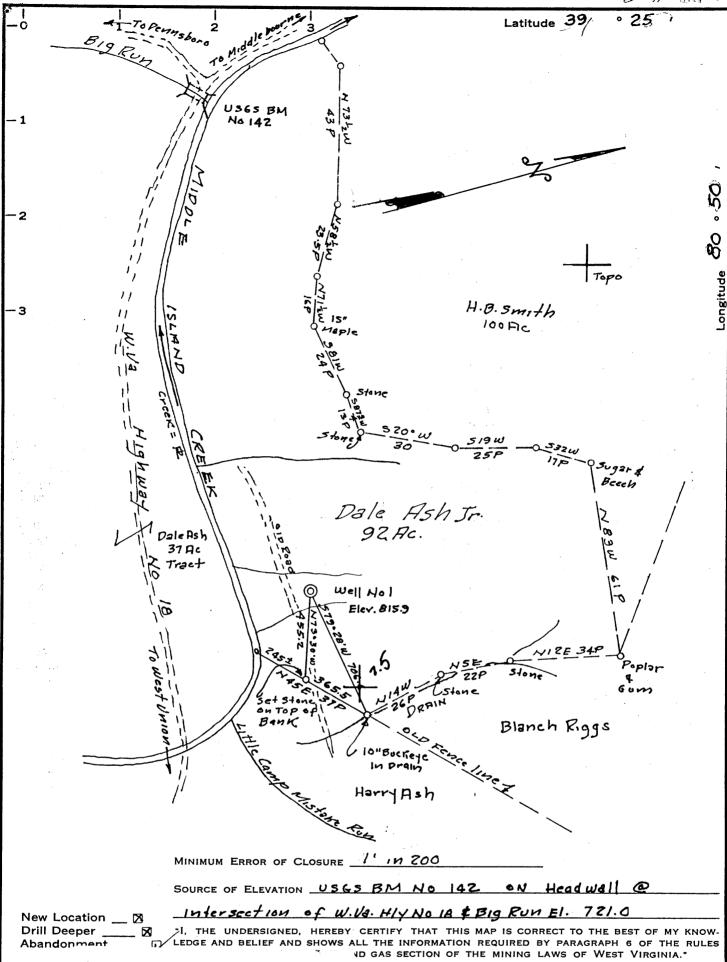

Appalachian Energy Development Co.

Company Box 902- Belington, WVa.

Address Surface: Randall Ash

Farm Dele Ash Tr.

Tract Acres 92 Lease No.

Well (Farm) No. One Serial No.

Elevation (Spirit Level) 8/5.9

Quadrangle West Union

County Tyler District Conferville

Engineer Registration No. 2492

File No. Drawing No.

STATE OF WEST VIRGINIA
DEPARTMENT OF MINES
OIL AND GAS DIVISION
CHARLESTON


WELL LOCATION MAP

FILE NO. TVI 400 - DD - P Plugging Permit Issued to 29-66 + Denotes location of well on United States Topographic Maps, scale 1 to 62,500, latitude and longitude lines being represented by border lines as shown. MAR 2 3 1987

— Denotes one inch spaces on border line

of original tracing. 47-095

Date May 6, 1966 Scale 1"= 30 Poles

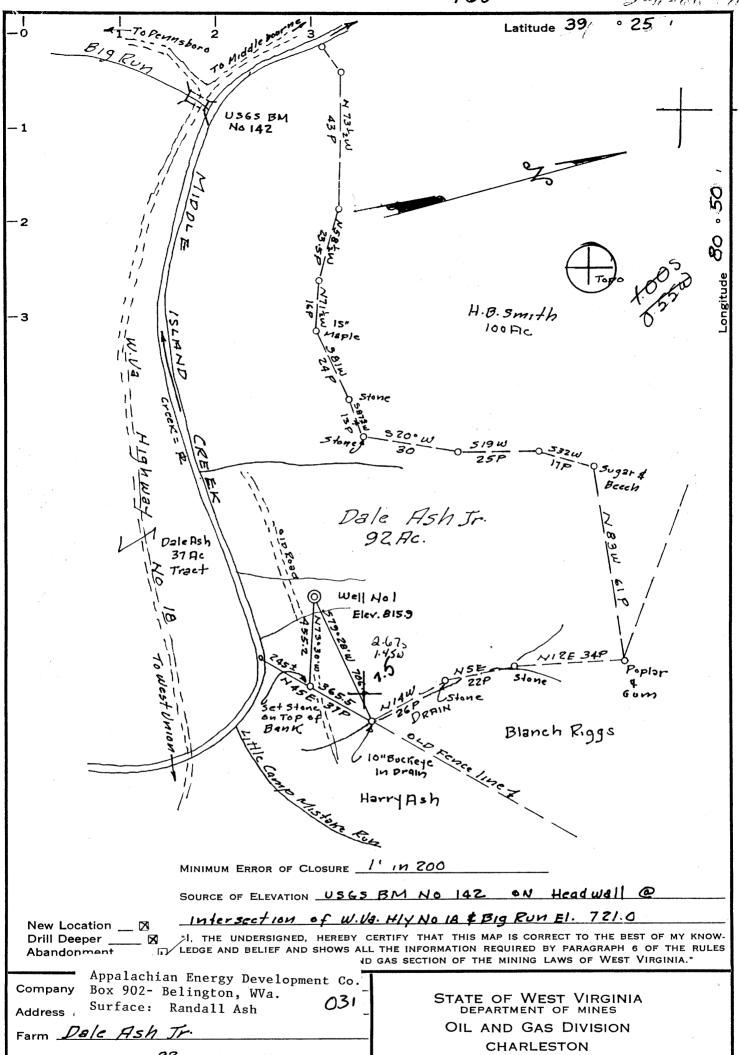

Company Box 902- Belington, WVa.

Address Surface: Randall Ash

Farm Dele Ash Tr.

Tract Acres 92 Lease No.

Well (Farm) No. One Serial No.

Elevation (Spirit Level) 8/5.9

Quadrangle West Union Serial No.

Engineer Production Serial No.

Engineer's Registration No. 2492

File No. Drawing No.

Date May 6, 1966 Scale 1"=30Poles


WELL LOCATION MAP

Plugging Permit Issued 10-27-66

+ Denotes location of well on United States
Topographic Maps, scale 1 to 62,500, latitude and longitude lines being represented
by border lines as shown.

OCT 2 7 1986

— Denotes one inch spaces on border line of original tracing. 47-095

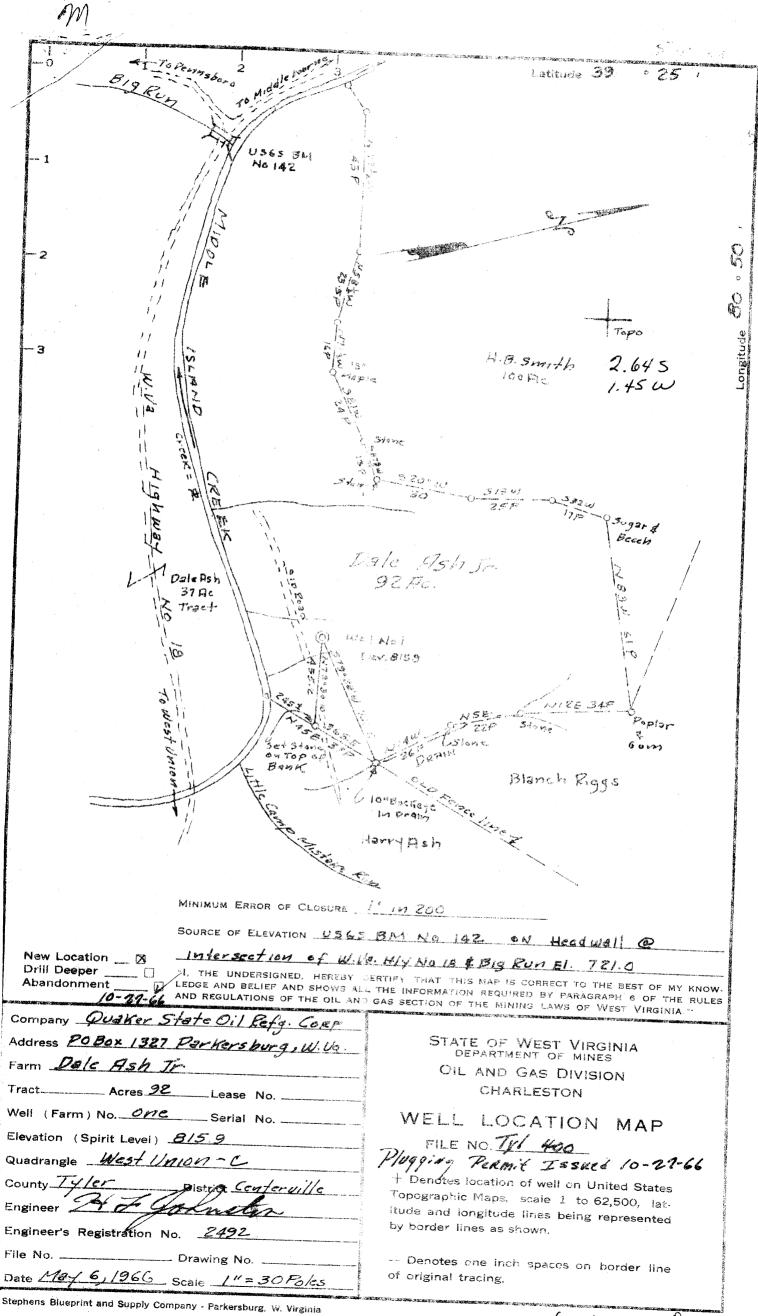

6-0

0



## STATE OF WEST VIRGINIA DEPARTMENT OF MINES

OIL AND GAS DIVISION 2/

Rotary	
Spudder	
Cable Tools	X
Storago	$\Box$

Quadrangle West Union

Permit No. TYL-400

WELL RECORD

Storage 
Oil or Gas Well 
DY4

Company Quaker	State Oil	Refining Con	rporation	Casing and Tubing	Used in Drilling	Left in Well		Packers
Address P. O. 1	30x 132/,	Parkersburg,	92	Size		•		
Farm Dale As	an Tolo	nd Creek	cres	16			Kind	of Packer
Location (waters) M	Jagre Isra	nd oreek	. 815 9	13				
Well No. One (1	<u>/</u>	Trail on	lev. Or January	10	423	423	Size	of
District Center	ville	County 1 VIET		81/4	1102	1102		
The surface of tract	is owned in fee	by		65%	1703	1703	Dept	h set
	Add	dress.===	***************************************	5 2 /15			]	
Mineral rights are O	wned by Dale	& Gladys As	h					
	Ad	dress Central S	tation, w. va.	472			Perf.	top
	. 6 <u>-8-</u> 66			J	1 1		1	bottom
Drilling completed	7-19-66	***************************************						top
Date Shot	From	То					1	bottom
With				The second secon			Peri	, bottom
	/10ths Water	in	Inch	Attach copy of	cementing record	<b>.</b>		
Open Flow				CASING CEN	MENTED NONE	.SIZE	No. F	t
Volume Show	/101115 MICIC.		Cu. Ft.	Amount of cer	ment used (bags)			4
Rock Pressure	<u></u>	14.0	hrs.	Name of Servi	ice Co			
			1.1.1. 1.4.04 hon	COAL WAS	ENCOUNTERED	AT 472	FEE	L apon IN
Oil snow of well ACIDIZED	0.1.1		0015., 18t 24 1113.	765 FF	ET show INC	CHES	FEE	rIN
WELL FRACTUR		LETT Prop	Moin		3L) I	<del></del>		
WELL FRACTUR	ED (DETAILS	) WIII I rac	Meti					
RESULT AFTER	TREATMENT	(Initial open Flow	or bbls.)					
ROCK PRESSURI	E AFTER TRE	ATMENT		Solt Water	334 - 75	Fee	1270	<del>-</del> 76
Fresh Water	•	Feet		Sait Water	Denth			
Fresh Water					Depuir			
Formation	Color	Hard or Soft	Тор	Bottom	Oil, Gas or Water	De	pth	Remarks
Red clay			Surface	30				
Sand stone			30	35				
Lime			35	39	·			
Shale			39	.52				
Red rock			52					
Shale .			60	74 88	· ·			
Red rock			74	120				
Shale & lime	snells		120	145				
Lime	1 1 -		145	165				
Shale & red	rock		165	172				
Lime Red rock			172	190				
Shale			190	228				
Lime			228	244				
Shale		778293037	244	250				
Red rock		Wa'll\	/ 5 <u>C</u>	290	-			
Shale	1	\$ 10° 10°	290	310	*			
Red rock		20, 705 1.00	310	334 375	Water 33	4-75 - 2	baile	rs/hr.
Sand		300 51/1/	334 375	380				-
Shale	100	DECEINE	375 380 405	405				· ·
Lime		A MOLLON M	405	430				
Sha <b>le</b> Sand	· `	Page Only	430	437				
Shale	-	(191917)	437	465	-		1 22	`,
Dark shale			465	472	Show of	coal@	4/2	
Lime			472	495				
Shale			495	530				
Red rock			530	550 605				
Shale & she	lis lime shell		550 605	627				

Formation	Color	Hard or Soft	Top 2/	Bottom	Oil, Gas or Water	Depth Found	Remarks
Prown shale	· · · · · · · · · · · · · · · · · · ·		627	640			
Red rock Shale	ż		640	680			
Red rock			680	705			
Lime			705 720	720 745			
Shale	• .		745	755			
Lime	. *		755	763	Jane 1		,
Dark shale			763	778	Show of coal	@ 765	
Lime Shale			778	785			•
Lime			785 800	800			
Shale		44	815	815 825			
Lime			825	842		*	
Shale & shel	ls		842	854			
Sand			854	862			
Shale Sand			862	935			
Shale			935 945	945 976		•	
Lime			976	976			
Shale & shel	ls		995	1040	2	•	
Lime			1040	1054		·	•
Sand Shale			1054	1065			
Sand			1065	1075			
Shale			1075 1105	1105 1115			
Sand			1115	1160			·
Shale			1160	1225			
Sand			1225	1334	Hole full of	water @ 127	0-76
Sandy shale Black shale			1334	1375			
Shale & shell	le .		1375	1380			
Slate break	13		1380 1420	1420 1480		. *	
Sand			1480	1500			
Black slate			1500	1516	1694		
Lime Black slate			1516	1532	1/8/7		
Shale & shell	ls		1532 1545	1545	816	•.	
Sand			1584	1584 160 <b>6</b>	878	42	*
Slate			1606	1615	,	1	. A -
Maxon Sand			1615	1625		$I_{ij}$	
Slate			1625	1635			
Red rock Black slate			1635	1640		##	e de la companya de l
Lime			1640 1652	1652 1672		_	•
Slate			1672	1683			
Lime			1683	1688			
Shale			1688	1691			**************************************
Big Lime Critty Lime			1691	1753			
Limey Sand			1753 1758	1758 1782			
Sand			1782	1802	Show of Oil		
Shale Sand	•		1802 1804	1804 1905	Show of Oil	1852-1870	
Shale			1905	2008	Show of Gas Shale Break	7006	
Sandy Shale			2008	2066	Show of Oil		
Sand H.H.		,	2066 2178	2178 2192			•
Slate and Sh	ells		2192	2378			
Pink Shale			2378	<b>23</b> 86			
Shale & Shell Lime	ıs		2386 2418	2418			
Sandy Shale			2418 2447	2447 2515			•
TOTAL DEPTH				2515		•	
7.000000				7-7			·
LOGGED BY BI		0-66:		•	.		
	G R Neutron		·				
1	Density Induction	, .					
· .	Induction	,					

Date July 27, 19 66

APPROVED Queker State Oil Refining Corporation when the Corporation (Title) Engineer

FORM WW-2(B)FILE COPY (Obverse) R 1986



1)	Date: Octo	ber	6	. 19 86
2)	Operator's Well No	Ash	# 2	
3)	API Well No.	47	095	400 -D
•		State	County	Permit /

## STATE OF WEST VIRGINIA

DEPARTMENT OF ENERGY, OIL AND GAS DIVISION **DIVISION OF OIL & GAS** APPLICATION FOR A WELL WORK PERMIT DEPARTMENT OF ENERGY WELL TYPE: A Oil \_ / Gas B (If "Gas", Production Underground storage Shallow Watershed: middle LOCATION: Elevation: 811 Island Creck WELL OPERATOR Appal achien Energy CODE: 2325 7)
Address 80, 902 Dev. Quadrangle: Shirle 7) DESIGNATED AGENT Corge Box 902 Belington Belington OIL & GAS INSPECTOR TO BE NOTIFIED DRILLING CONTRACTOR: BOD Lowther Name \_\_\_ Name Address Coneral Deliver Address Middle bourne PROPOSED WELL WORK: Drill Drill deeper / Redrill\_ Stimulate Plug off old formation Perforate new formation Other physical change in well (specify)\_ 11) GEOLOGICAL TARGET FORMATION, \_ Benson Plugs AND YUN CASING ou : TOP 12) Estimated depth of completed well, feet offeet; 13) Approximate trata depths: Fresh, Previous cased salt feet. 14) Approximate coal seam depths: None Is coal being mined in the area? 15) CASING AND TUBING PROGRAM CASING OR TUBING TYPE SPECIFICATIONS Weight FOOTAGE INTERVALS CEMENT FILL-UP OR SACKS **PACKERS** For drilling Size Grade per ft. Used Left in well Conductor 10 423 423 CT Fresh water 85/8 1102 1107 Coal 170 Intermediate 160 2500 1 5; Hay mguletion Depths set Production 4900 Tubing Perforations: Тор Bottom OFFICE USE ONLY **DRILLING PERMIT** 47-095-400-D October 17 86 Permit number Date This permit covering the well operator and well location shown below is evidence of permission granted to drill in accordance with the pertinent legal re-This permit covering the well operator and well location allows octoon is consistent of the conditions contained herein and on the reverse hereof Notification must be given to the District Oil and Gas Inspector, (Refer to the construction of roads, locations and bits for any permitted work. In addition, the well operator or his contractor shall notify the proper No. 8) Prior to the construction of roads, locations and pits for any permitted work. It district oil and gas inspector 24 hours before actual permitted work has commenced.) The permitted work is as described in the Notice and Application, plat, and reclamation plan, subject to any modifications and conditions specified on the reverse hereof. October 17, 1988 Permit expires unless well work is commenced prior to that date and prosecuted with due diligence. Bond: Agent: Fee 0ther

Direct

See the reverse side of the APPLICANT'S COPY for instructions to the well operator.

Division of

gand Gas

File

NOTE: Keep one copy of this permit posted at the drilling location.

FORM WR-38
(Affidavit of Plugging)

1

## STATE OF WEST VIRGINIA DEPARTMENT OF ENERGY OIL AND GAS WELLS DIVISION



DIVISION OF OIL & GAS DEPARTMENT OF ENERS

## AFFIDAVIT OF PLUGGING AND FILLING WELL

AFFIDAVIT SHOULD BE MADE IN To be retained by the Well Opera be mailed to each coal operate	tor and the thi	rd copy (and e	xtra copies if re	one copy to equired) shou
		Appalachian	Energy Developmen	it, Inc.
Coal Operator or Owner			Name of Well Oper 99, Grafton, WV 2	
Address			Complete Addres	3S
· · · · · · · · · · · · · · · · · · ·			March 5	19 87
Coal Operator or Owner		WE: Centerville	District	
Address				
Randall Ash	At	Tyler		County
Lease or Property Own	er		1	
Rt. 1, Greenwood, WV Address		WELL NO. A	sh # 🕹 Well	
Addless		As	sh	
OMATE INCREASED CURRENTLYING R	I NOOTNO -			Farm
STATE INSPECTOR SUPERVISING P	LUGGING Rober	t Lowther		
	AFFIDA	VIT		
STATE OF WEST VIRGINIA,				
County of Tyler	ss:			
ing the above well, that said 19 86, and that the well w	as plugged and	filled in the	following manner:	
	Filling Mat	erial	Plugs Used	Casing
Formation			Size & Kind	CSG CSG PULLED LEFT IN
Well was drilled to a			The state of the s	
depth of 275'. Due to				
hole problems well was abandoned.	Cement from	275' to Surface		10 10
				<del></del>
				<del>                                     </del>
				10/20
Coal Seams				119/87
			Description of 8 5/8" pipe pro	
(Name)			above ground le	
(Name)			operators name,	
(Name)		A	& well name and	permit No.
of <u>December</u> , 19 and further deponents sa	gging and filli 86•	ing said well wa	as completed on t	he 8 day
		Sega	g Kill	leans
	ith not.	John a	g Kill	llians
Sworn to and subscribed befor	ith not.	John John J	March .	/leans)
Sworn to and subscribed befor	ith not.	John (	EWillian	
Sworn to and subscribed befor  My commission expires:	ith not.	John (	C 1 1 2 2 .	<u>ر</u>