

I, the undersigned, hereby certify that this map is correct to the best of my knowledge and belief and shows all of the information that may be required for the location and operation of the well and service at the various lines of West Virginia.

W. H. H. H.
E. P. No. 1227

New Location
 Drill Deeper
 Abandonment 11/3/75

Elev. ref: - Mouth of Willow Fork = 746
 Error in closure: - Less than 1 in 200

Company AMERICAN OIL
 Address 625 19th St. Washington DC 20005
 Farm George Pittman
 Tract _____ Acres 104 Lease No. _____
 Well (Farm) No. One Serial No. _____
 Elevation (Spirit Level) 922
 Quadrangle New Martinsville SC
 County Tyler District Elkworth
 Engineer W. H. H. H.
 Engineer's Registration No. 1227
 File No. _____ Drawing No. _____
 Date July 27, 1966 Scale 1" = 300' = 495'


STATE OF WEST VIRGINIA
 DEPARTMENT OF MINES
 OIL AND GAS DIVISION
 CHARLESTON

WELL LOCATION MAP
 FILE NO. TYL-402-P

+ Denotes location of well on United States Topographic Maps, scale 1 to 62,500, latitude and longitude lines being represented by border lines as shown.

- Denotes one inch spaces on border line of original tracing.

47-095

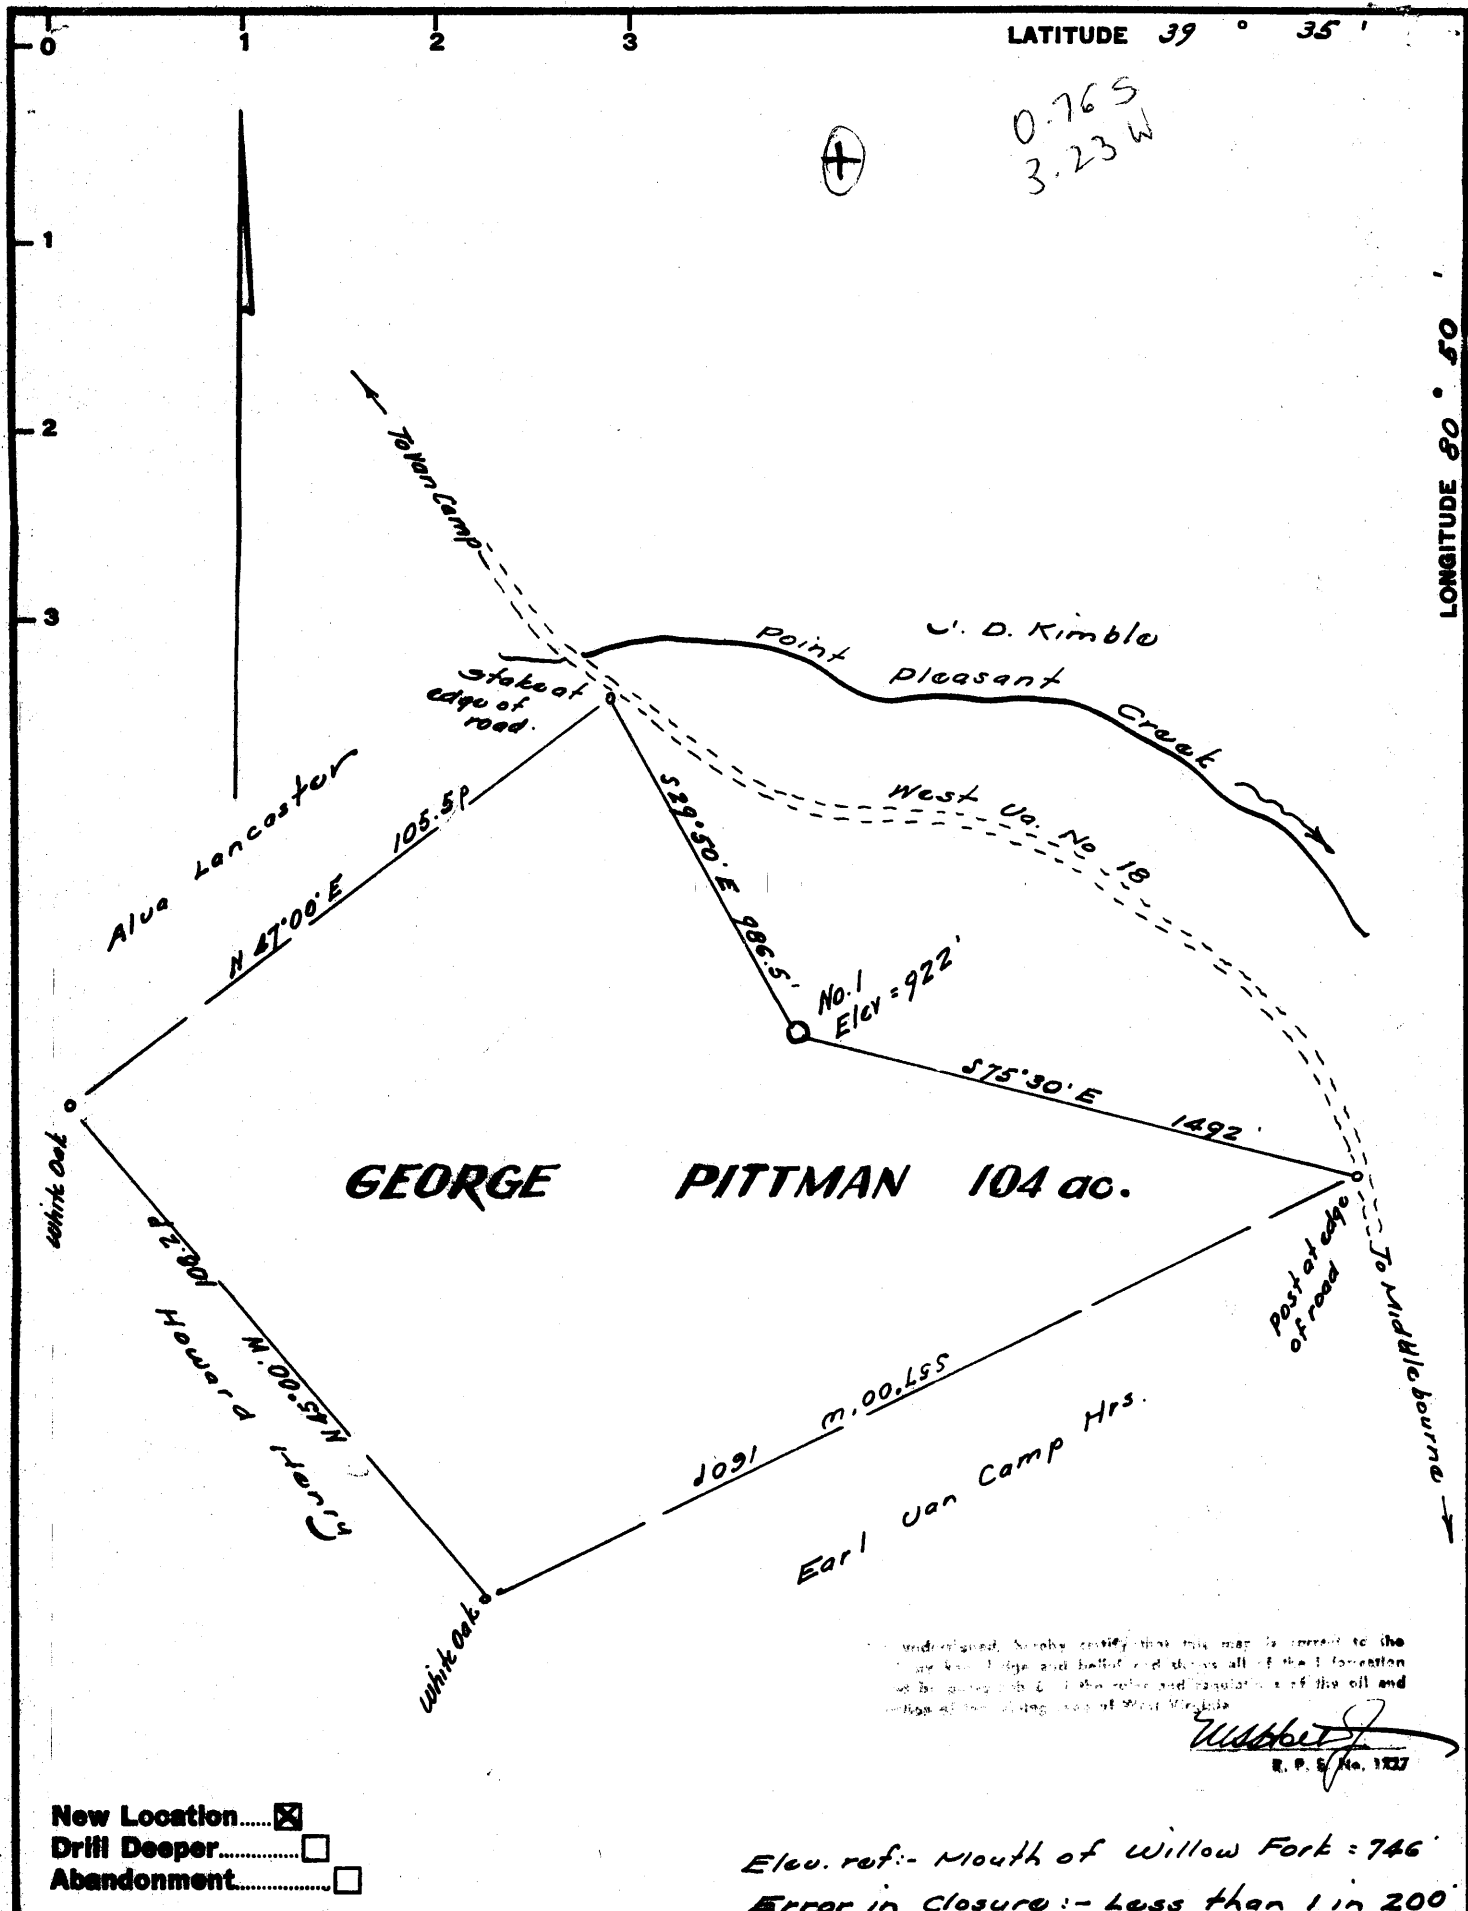

I, the undersigned, hereby certify that this map is correct to the best of my knowledge and belief and that all of the information herein is true and correct and that I am a duly licensed and registered engineer of the oil and gas industry of the State of West Virginia.

W. H. H. H.
R. P. S. No. 1327

New Location.....
 Drill Deeper.....
 Abandonment.....

Elev. ref:- Mouth of Willow Fork = 746'
 Error in closure:- Less than 1 in 200

Company LINCOLN OIL & GAS CO.
 Address P.O. Office, Box 286, West Union, W. Va.
 Farm George Pittman
 Tract _____ Acres 104 Lease No. _____
 Well (Farm) No. One Serial No. _____
 Elevation (Spirit Level) 922
 Quadrangle New Martinsville - 56
 County Tyler District Ellsworth
 Engineer W. H. H. H.
 Engineer's Registration No. 1227
 File No. _____ Drawing No. _____
 Date July 27, 1966 Scale 1" = 300' = 495'

STATE OF WEST VIRGINIA
 DEPARTMENT OF MINES
 OIL AND GAS DIVISION
 CHARLESTON

WELL LOCATION MAP
 FILE NO. TYL-402

+ Denotes location of well on United States Topographic Maps, scale 1 to 62,500, latitude and longitude lines being represented by border lines as shown.

- Denotes one inch spaces on border line of original tracing.



STATE OF WEST VIRGINIA
DEPARTMENT OF MINES
OIL AND GAS DIVISION

Rotary
Spudder
Cable Tools
Storage

WELL RECORD

Quadrangle _____

Permit No. Tyler - 402

Oil or Gas Well Oil
(KIND)

Company Lincoln Oil & Gas Co., Inc.
Address Box 1201, Wheeling, W. Va.
% Don Van Camp
Farm George Pittman Acres 108
Location (waters) Ellsworth District
Well No. One Elev. 922
District Ellsworth County Tyler
The surface of tract is owned in fee by George Pittman,
Route 2, Paden City, West Virginia
Mineral rights are owned by Oblinger Heirs, et al
Address _____

Casing and Tubing	Used in Drilling	Left in Well	Packers
Size			Kind of Packer
16			
13			
10			Size of
8 1/4			
7 1/2 7"	1710 Ft.		Depth set
5 3/16			
4 1/2"		1959 Ft.	Perf. top
2			Perf. bottom
Liners Used			Perf. top
			Perf. bottom

Drilling commenced 9-13-66
Drilling completed 10-9-66
Date Shot _____ From _____ To _____
With _____
Open Flow _____ /10ths Water in _____ Inch
_____ /10ths Merc. in _____ Inch
Volume _____ Cu. Ft.
Rock Pressure 150 lbs. 24 hrs.
Oil 25 bbls. per day bbls., 1st 24 hrs.
WELL ACIDIZED No

CASING CEMENTED 4 1/2" SIZE _____ No. Ft. _____ Date _____
COAL WAS ENCOUNTERED AT _____ FEET _____ INCHES
_____ FEET _____ INCHES _____ FEET _____ INCHES
_____ FEET _____ INCHES _____ FEET _____ INCHES


WELL FRACTURED Yes, 40,000 Sand

RESULT AFTER TREATMENT 25,000 M.C.F. Gas per day

ROCK PRESSURE AFTER TREATMENT _____

Fresh Water _____ Feet _____ Salt Water _____ Feet _____

Formation	Color	Hard or Soft	Top	Bottom	Oil, Gas or Water	Depth	Remarks
Clay	Red	Soft	0	15			
Shale	Gray	Med.	15	385			
Sandy Shale	Green	Med.	385	430			
Sand	White	Med.	430	480			
Shale	Gray	Med.	480	560			
Sand	White	Med.	560	600			
Shale	Green	Med.	600	700			
Shale & R.R.	Gray	Soft	700	760			
Red Rock	Red	Soft	760	830			
Shale	Gray	Med.	830	930			
Sand w/Shale	Gray	Med.	930	1060			
Shale	Gray	Med.	1060	1310			
Sandy Shale	Gray	Hard	1310	1330			
Sand	White	Hard	1330	1520			
Shale	Black	Hard	1520	1550			
Sand	Dark Gray	Hard	1550	1595			
Lime	Brown	Hard	1595	1610			
Shale	Dark	Hard	1610	1680			
Lime	Brown	Hard	1680	1710			
Lime	Brown	Hard	1710	1725			
Sand	White	Hard	1725	1748			
Sand & Lime	Brown	Hard	1748	1752			
Lime	Brown	Hard	1752	1754			
Sand	White	Hard	1754	1790			
Shale	Gray	Med.	1790	1805			
Sand	White	Hard	1805	1936			
Shale	Gray	Med.	1936	1955			

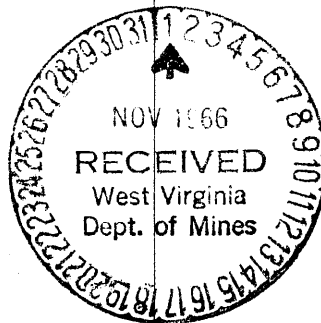

1680
922
758

1595
922
673