

LATITUDE 39° 25' 00"

00° 54' 00" LONGITUDE

7'5 OGIS topo location

7.5' loc 0.58S
0.02W

15' loc 0.58S
(calc.) 0.02W

Company _____

Farm _____

West Union EC

Quad SHIRLEY 7 1/2'

County TYLER

District McELROY

WELL LOCATION MAP

File No. 095-0490

HOPE NATURAL GAS COMPANY.

LOCATION FOR WELL No. 84

~~0490~~
095-490

Shirley DISTRICT


On Silas Underwood Farm, on waters of Georges Run

McElroy District, Tyler County, West Virginia

Lease No. 746 Acres 125 N. S. 3 E. W. 8

Scale, one inch equals 80 Poles Sent to 1

Location to be

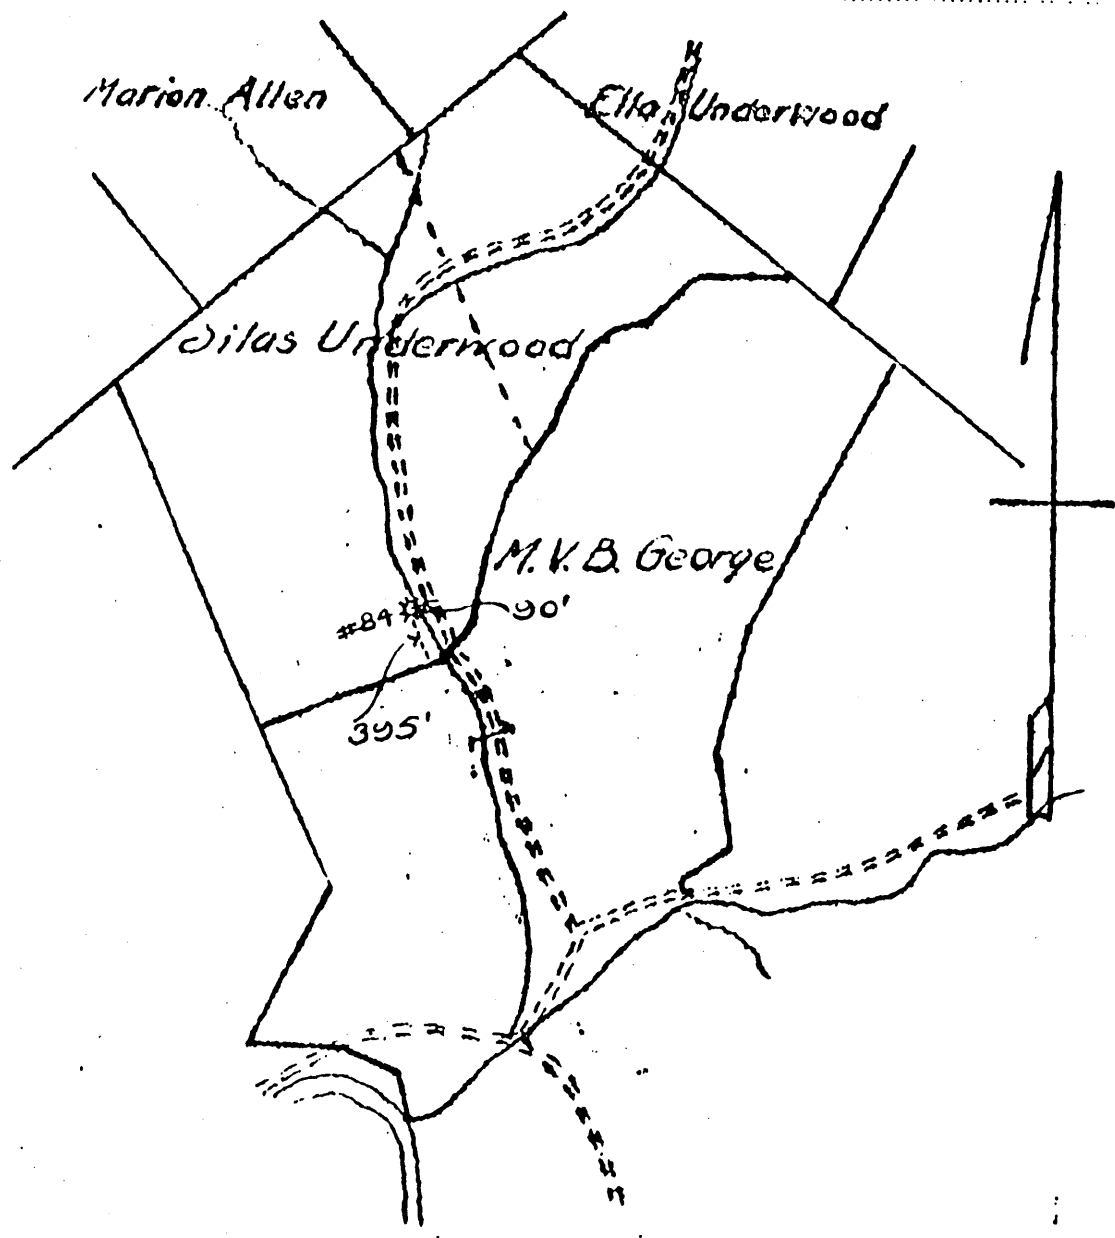

RESERVE

SPECIAL INSTRUCTIONS

Meas. made 3-8-11 by T.D. Lutz As per plat, except as noted. On field map...

Returned to Pittsburgh

Location changed on account of

Authorized by Date Signed

Tyler 490.

S. Underwood... NO. 84 WELL.

Gal. No. 461 (288)

Permit # assigned

1978 by

Rept. Mines

McElroy District, Tyler County, W. Va.

Hope Natural Gas Co.

Elevation, 769'.

Gas well.

1/4 mi. W. of Little Pittsburgh.

Shown on West Union Quadrangle.

Hope Natural Gas Company

Well No. 84

Report on Defective Well

Name Silas Underwood

Shirley District

ORIGINAL TEST

Date	Reading	Liquid	Opening	Rock	Sand
1-29-16	8/10	Mer	3	100	loaded

TEST TAKEN FOR THIS REPORT

Date	Reading	Liquid	Opening	Rock	Sand
9-9-23	not enough		12	25	inches
Best test					

Record of Casing and Tubing in this Well:

18 inch _____ 10 inch _____ 8 1/2 inch _____ 6 1/2 inch 1835 5 1/2 inch _____ Tubing 1924

History of Well:

Depth of Pittsburgh Coal: None Original Depth: 1928 Present Depth: 1928
 Well Producing Gas from: INDIAN Sands at depths of: 1939-1951 Condition of Rig: None
 Well has made _____ bbl. of Oil from _____ Sand. Now making _____ bbl. Weekly Dally by _____
 Amount of cavings in hole: None bailed Amount of Water: _____ Amount of Oil: _____
 Date well cleaned out: 5-29-23 Result: increased flow of gas 1/2 per cent
3-4-1923


What should be done with well in my opinion: Move the Machine & 60' rods and clean out and if gas does not return drive them down further

Date 9-8-23 E. M. Laylin Foreman
 I would recommend clean out and report

Date 9/12-23 Approved: By J. J. [Signature] Division Superintendent
[Signature] General Superintendent

Instructions from Pittsburgh office—Repair as per recommendation of Superintendent

Date SEP 13 1923 [Signature] Asst. General Manager

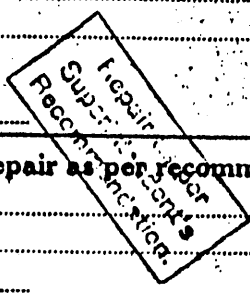

WELL RECORD.

149

Jila Underwood
M. E. Coy

Farm

District *Fyles*

County

Mrs.

7451

Lores.

State.

095-4

Well No. # *84*

Rig Commenced

189

E. Myers

Contractor.

Rig Completed

189

Drilling Commenced

Dec 26

189

Cochran Jameson

Contractor.

Drilling Completed

Jan 29

189

FORMATION	TOP.	REMARKS.	BOTTOM.
<i>3 1/2' Coal</i>	<i>Drillers</i>	<i>Claim none</i>	
<i>Big Lignite</i>	<i>1822</i>		
<i>1" Sand</i>	<i>1829</i>	<i>Gas</i>	
<i>1' mi</i>	<i>1840</i>		

NOTE:—

A good record must show the formation from top to bottom of well.