



West Virginia Department of Environmental Protection
Office of Oil and Gas
WELL LOCATION FORM: GPS

API: 47-095-00501 WELL NO.: WV 650451 (Haught #185)

FARM NAME: J. B. Haught

RESPONSIBLE PARTY NAME: EQT Production Company

COUNTY: Tyler DISTRICT: Ellsworth

QUADRANGLE: Porter Falls 7.5'

SURFACE OWNER: Robert and Sherry Ball

ROYALTY OWNER: John W. Kerns Heirs Trust, et al.

UTM GPS NORTHING: 4373406

UTM GPS EASTING: 520753 GPS ELEVATION: 276 m (908 ft)

The Responsible Party named above has chosen to submit GPS coordinates in lieu of preparing a new well location plat for a plugging permit or assigned API number on the above well. The Office of Oil and Gas will not accept GPS coordinates that do not meet the following requirements:

- Datum: NAD 1983, Zone: 17 North, Coordinate Units: meters, Altitude: height above mean sea level (MSL) – meters.
- Accuracy to Datum – 3.05 meters
- Data Collection Method:

Survey grade GPS _____; Post Processed Differential _____
 Real-Time Differential _____
 Mapping Grade GPS X; Post Processed Differential _____
 Real-Time Differential _____

4. **Letter size copy of the topography map showing the well location.**

I the undersigned, hereby certify this data is correct to the best of my knowledge and belief and shows all the information required by law and the regulations issued and prescribed by the Office of Oil and Gas.

RECEIVED
 Office of Oil and Gas
 WV Department of
 Environmental Protection

Steph Brown
Signature

PS # 2180
Title

11/14/17
Date

4709500501

Topo Quad: Porter Falls 7.5'

Scale: 1" = 2000'

County: Tyler

Date: November 8, 2017


District: Ellsworth

Project No: 69-54-00-08

Water

47-095-00501 WV 650451 (Haught #185)

1 Potential Water Source within 1000'

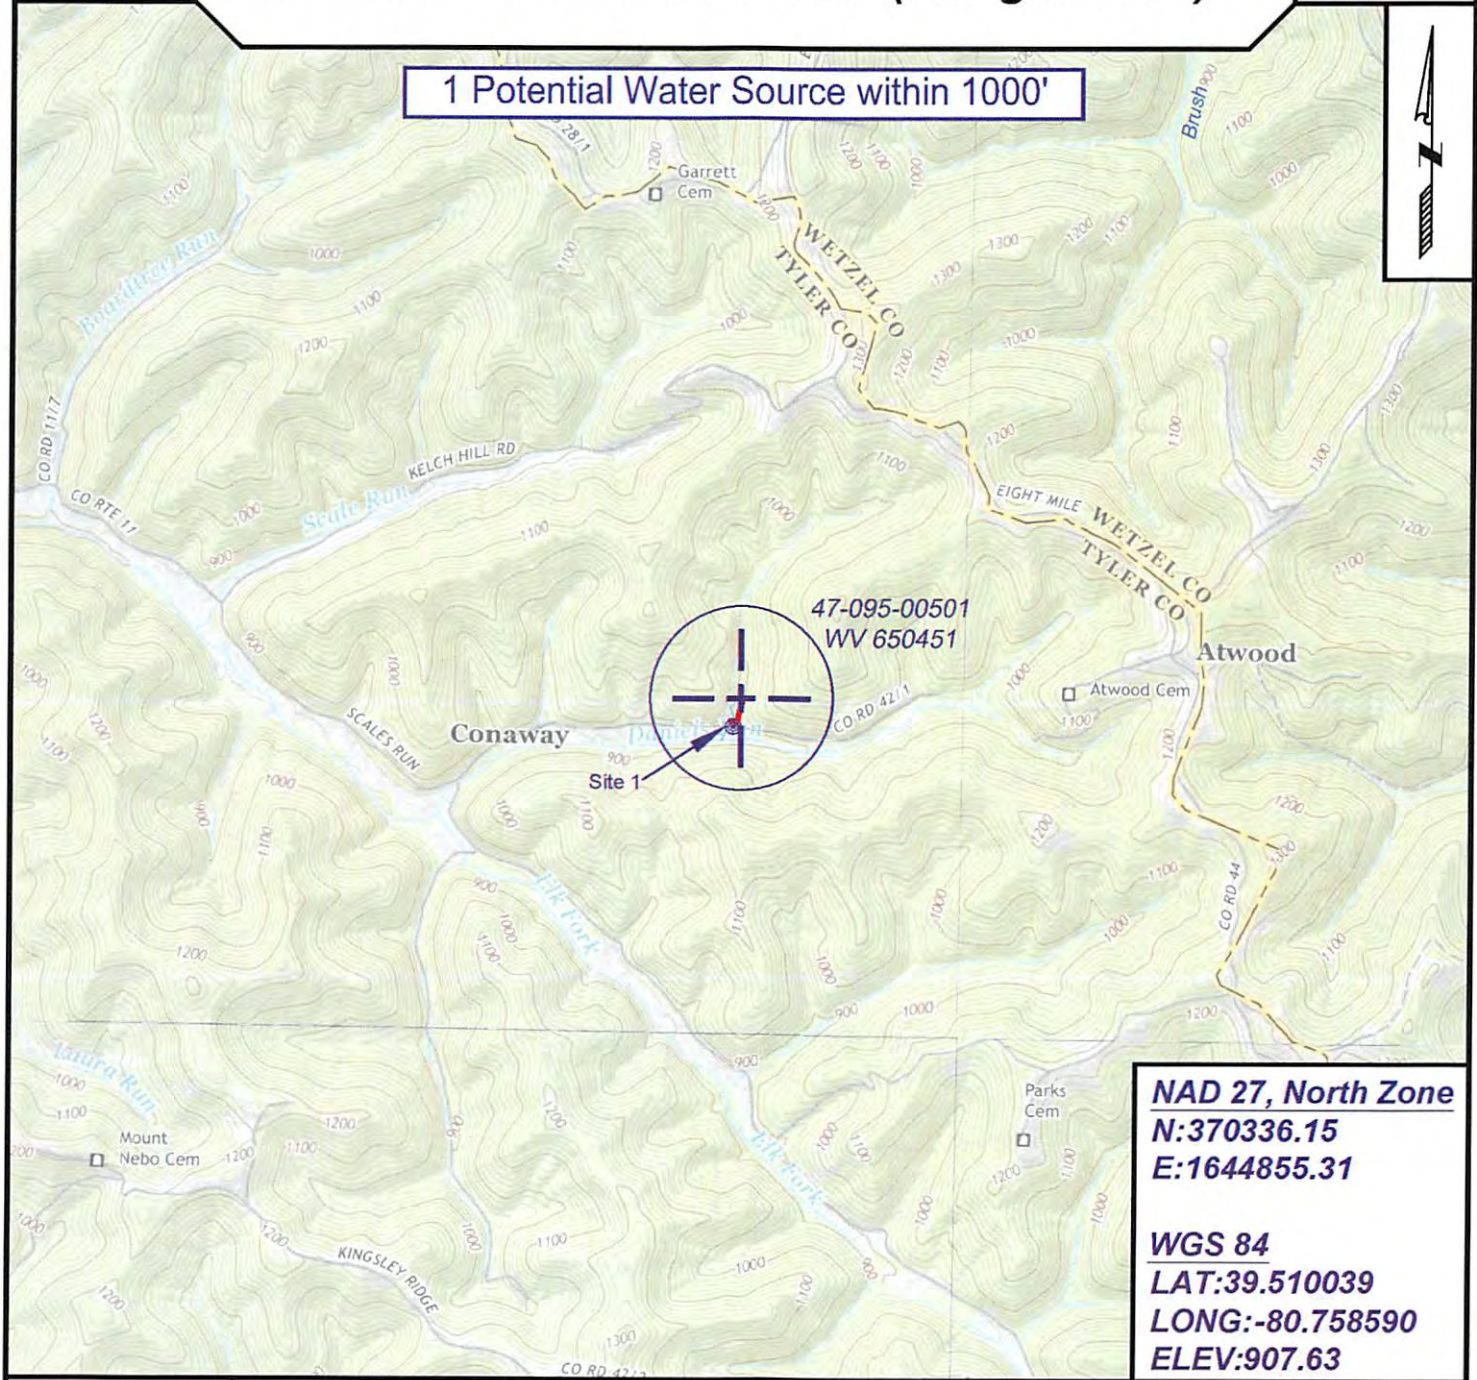

NAD 27, North Zone
N:370336.15
E:1644855.31

WGS 84
LAT:39.510039
LONG:-80.758590
ELEV:907.63



SURVEYING AND MAPPING SERVICES PERFORMED BY:
ALLEGHENY SURVEYS, INC.
 1-800-482-8606
 237 Birch River Road
 Birch River, WV 26610
 PH: (304) 649-8606
 FAX: (304) 649-8608

PREPARED FOR:
EQT Production Company
 RECEIVED
 Office of Oil and Gas
 P.O. Box 280
 Bridgeport, WV 26330
 APR 23 2018
 WV Dept of Environmental Protection

05/11/2018