

WW-7  
8-30-06



West Virginia Department of Environmental Protection  
Office of Oil and Gas

**WELL LOCATION FORM: GPS**

API: 47-095-00545 WELL NO.: 11

FARM NAME: H.I. Asher

RESPONSIBLE PARTY NAME: Triad Hunter, LLC

COUNTY: Tyler DISTRICT: Ellsworth

QUADRANGLE: Porters Falls

SURFACE OWNER: Charles E. & Laura L. Friend

ROYALTY OWNER: Shiben Estates, Inc.

UTM GPS NORTHING: 513056 4375258.7

UTM GPS EASTING: 4375258.7 513056 GPS ELEVATION: 757'

The Responsible Party named above has chosen to submit GPS coordinates in lieu of preparing a new well location plat for a plugging permit or assigned API number on the above well. The Office of Oil and Gas will not accept GPS coordinates that do not meet the following requirements:

1. Datum: NAD 1983, Zone: 17 North, Coordinate Units: meters, Altitude: height above mean sea level (MSL) – meters.
2. Accuracy to Datum – 3.05 meters
3. Data Collection Method:

Survey grade GPS  : Post Processed Differential

Real-Time Differential

Mapping Grade GPS  : Post Processed Differential

Real-Time Differential

4. **Letter size copy of the topography map showing the well location.**


I the undersigned, hereby certify this data is correct to the best of my knowledge and belief and shows all the information required by law and the regulations issued and prescribed by the Office of Oil and Gas.

*Ben Smith*  
Signature

Geologist  
Title


3/27/15  
Date

Office of Oil & Gas  
APR 23 2015

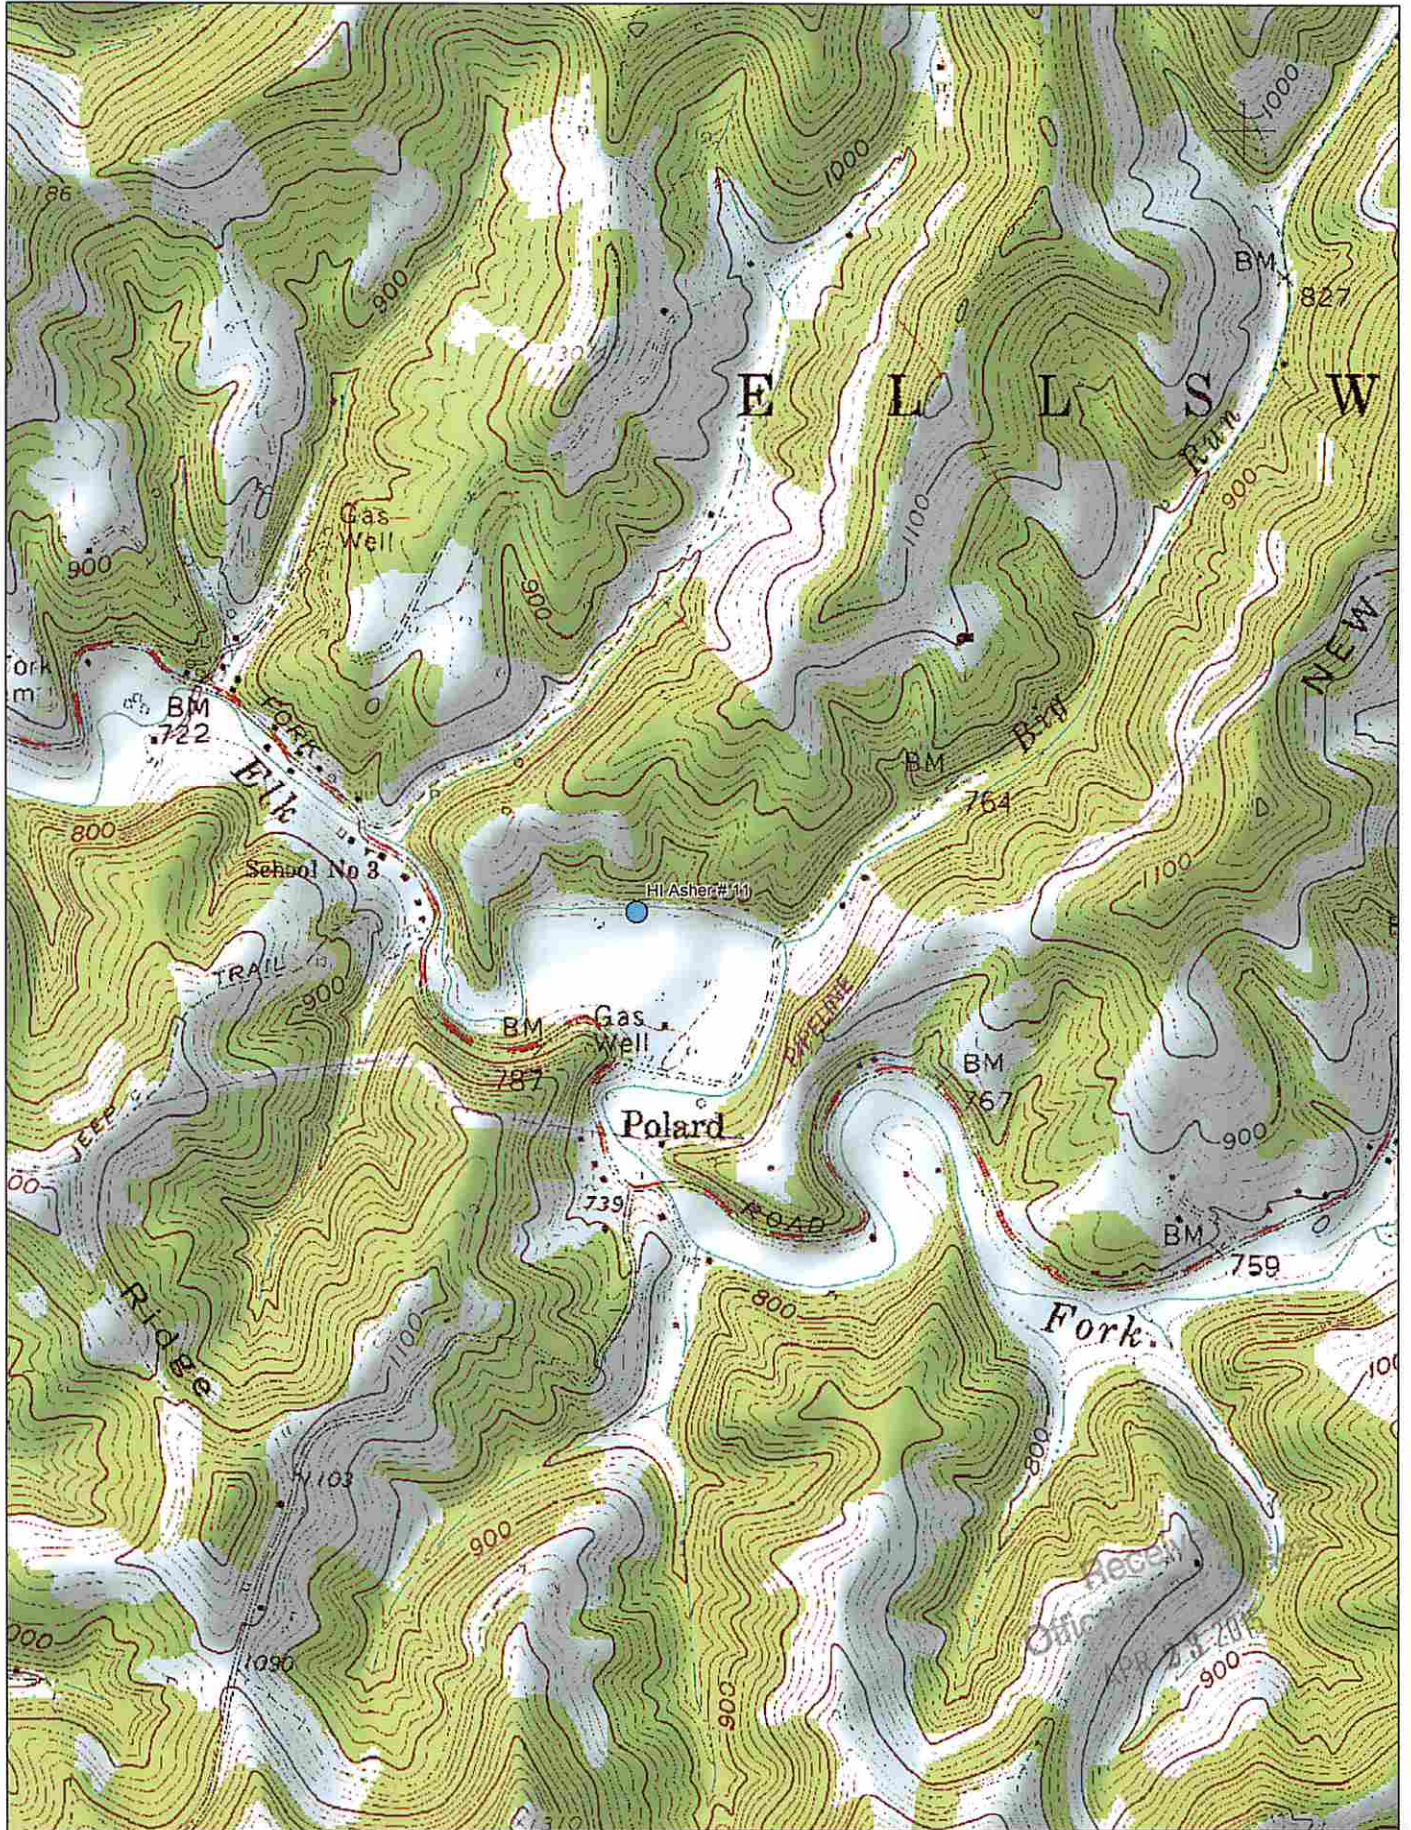

Data use subject to license.

© DeLorme. XMap® 7.  
www.delorme.com

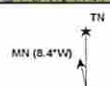

Scale 1 : 16,000

1" = 1,333.3 ft      Data Zoom 13-6

06/26/2015