

LATITUDE 39° 32' 30"



09 05 08

LONGITUDE

7'5 OGIS topo location

7.5' loc	<u>1.24 S</u>	15' loc	<u>4.12 S</u>
	<u>1.87 W</u>	(calc.)	<u>1.87 W</u>

Company _____

Farm _____

Quad New Martinsville SC
PORTERS FALLS 7 1/2'

County TYLER

District ELLSWORTH


WELL LOCATION MAP

File No. 095 - 557

(was: 70119)

(030)

390 32' 30"

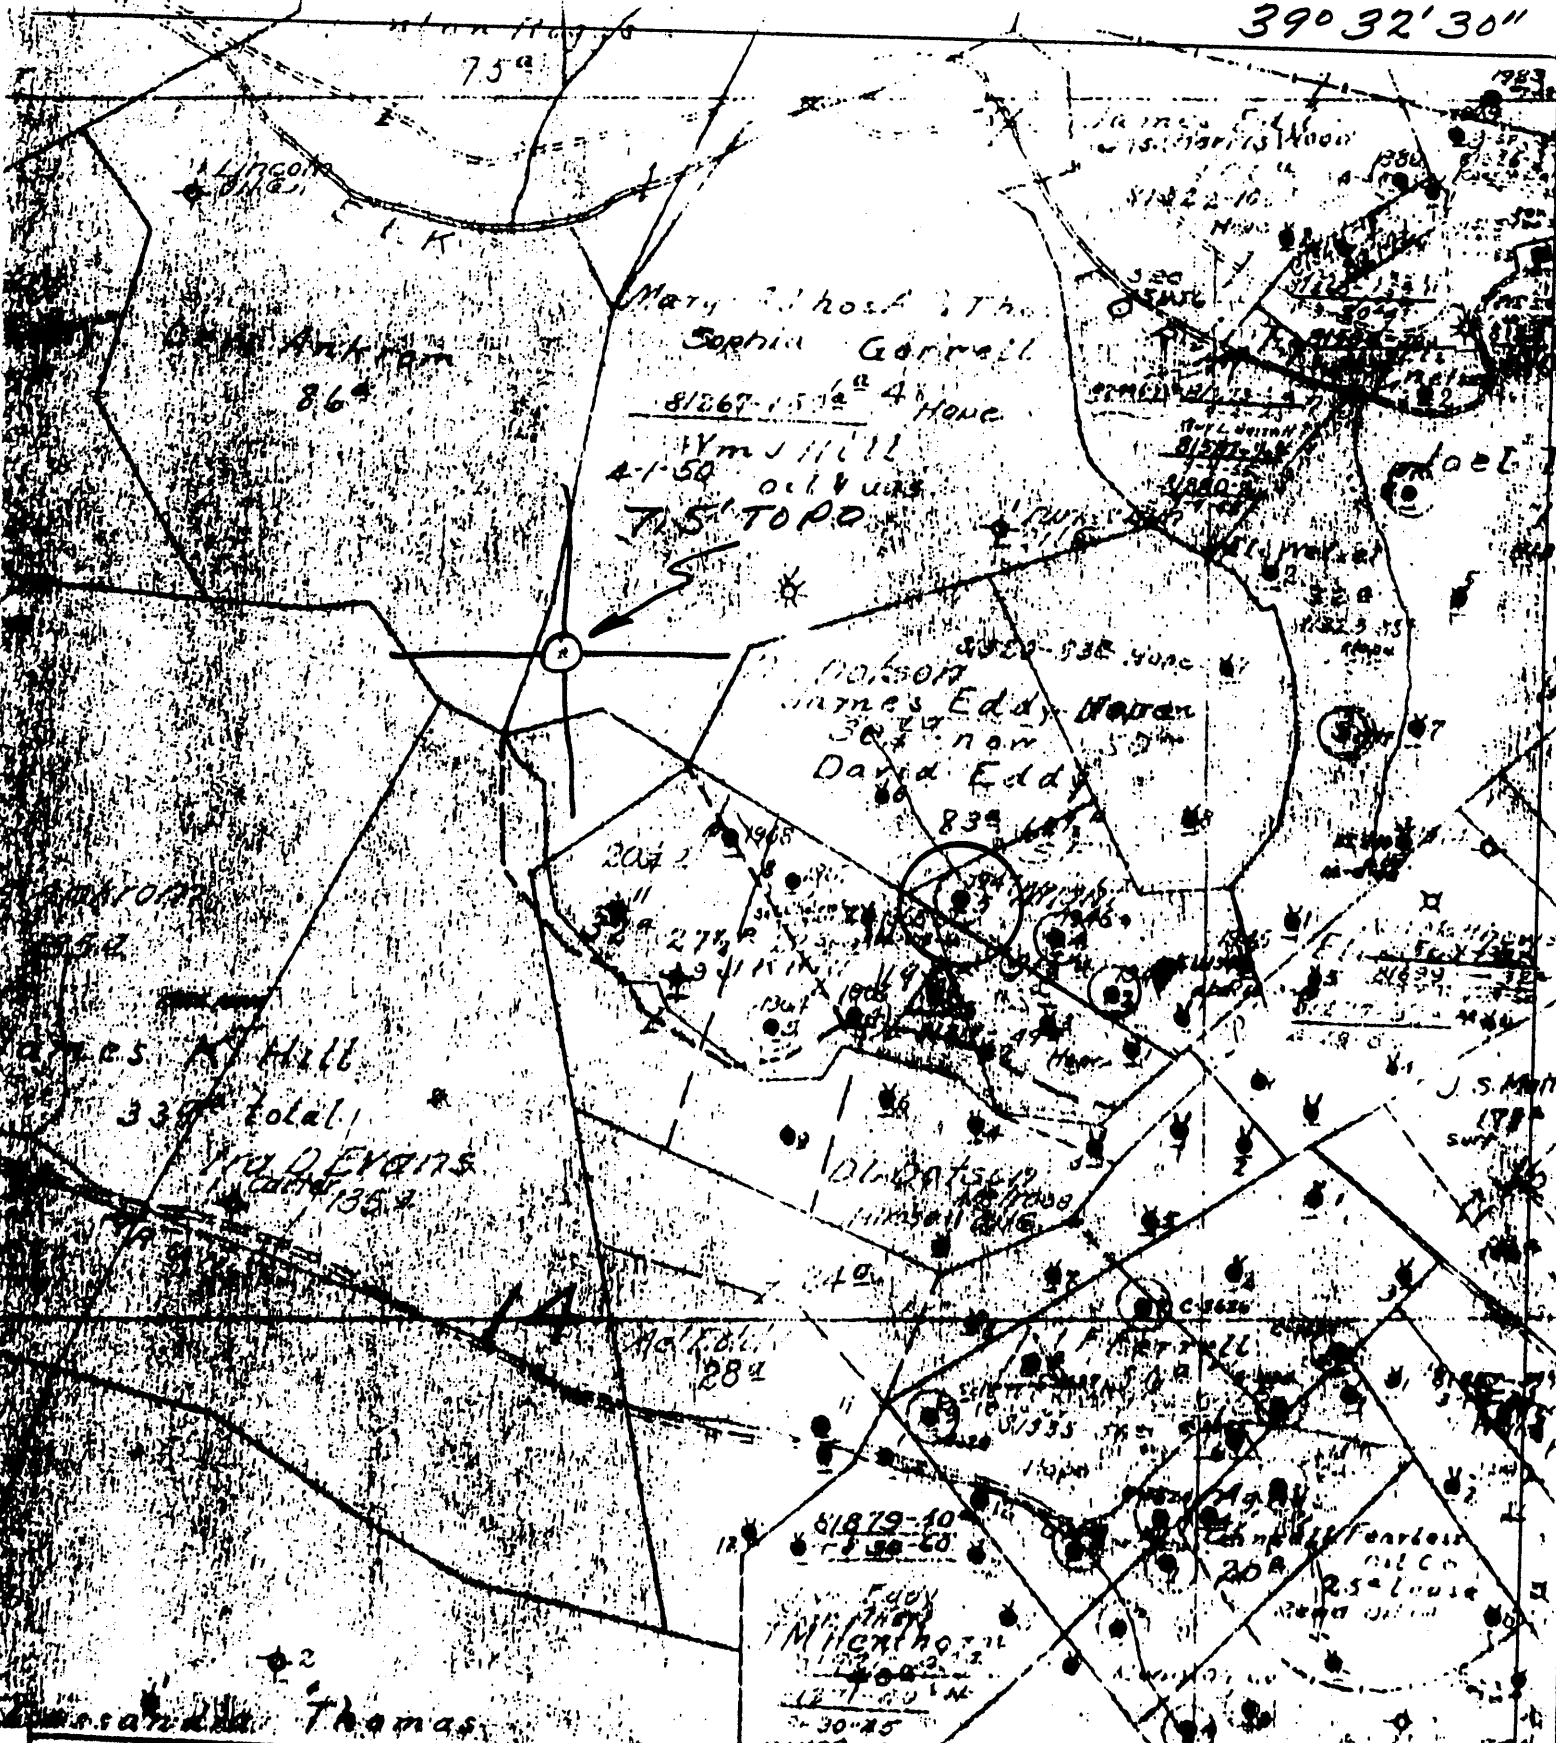

(+) DENOTES LOCATION OF WELL ON UNITED STATES TOPOGRAPHIC MAPS

FORM IV-B (8-78) N56 N6 W14



DATE Jan 2, 1979
OPERATOR'S WELL NO 5
API WELL NO 47-045-0557
STATE COUNTY PERMIT

STATE OF WEST VIRGINIA DEPARTMENT OF MINES OIL AND GAS DIVISION

WELL TYPE: OIL GAS LIQUID INJECTION WASTE DISPOSAL
(IF "GAS", PRODUCTION STORAGE DEEP SHALLOW
LOCATION: ELEVATION 1376.50 WATER SHED ELK FORK
DISTRICT Eltsworth COUNTY Tyler
QUADRANGLE PORTERS FALLS 7151

SURFACE OWNER _____ ACREAGE _____
OIL & GAS ROYALTY OWNER _____ LEASE NO. _____ LEASE ACREAGE _____

PROPOSED WORK: DRILL CONVERT DRILL DEEPER REDRILL FRACTURE OR STIMULATE PLUS OFF OLD FORMATION PERFORATE NEW FORMATION OTHER PHYSICAL CHANGE IN WELL (SPECIFY) _____

PLUG AND ABANDON CLEAN OUT AND REPLUG TARGET FORMATION _____ ESTIMATED DEPTH _____
WELL OPERATOR Pennzoil Company DESIGNATED AGENT James A. Gross
ADDRESS P. O. Box 1588 ADDRESS P. O. Box 1588
Parkersburg, WV 26101 Parkersburg, WV 26101

JAMES EDDY-5

47-095-0557

WELL NO. 5 1947 NAME *Edwards* LEASE NO. 6052 ACRES 1/3 N. S. E. W. DISTRICT PINE GROVE

District or Co. *Edwards*
 County *Wayne*
 State *MI*
 Com. No. *1116/197*
 Collected *12/9/97*
 Contractor *WPA*

Purchased From *Edwards O. & S. Co.* Per Foot
 Date Purchased *1-26-00*

Date Connected
 Date Sold
 Date Plugged
 Date Abandoned

Get from water table level

Size	Put in Well	Left in Well	Pulled
13 In. Casing			
10 In. Casing			
8 1/4 In. Casing			
6 3/4 In. Casing			
6 1/4 In. Casing			
5 1/2 In. Casing			
4 7/8 In. Casing			
2 In. Tubing			
In. Tubing			
In. Tubing			

Date	Diss.	Sand		Depth		Test	
		Before	After	Before	After	Before	After
12/16/97	5						
12/13/97	10						
12/13/97	15						
1/7/98	20						
1/32/98	30						
5/1/98	30						
7/32/98	60						

SHOOTING

Initial Oil Production
 Initial Open Flow

Elevation at Mouth of Well

Formation	TOP	BOTTOM	THICKNESS	Oil At	Oil At	Water At	Thickness of Pay
Pittsburgh Coal							
Red Rock Cave							
Cow Run (First)							
Cow Run (Second)							
Salt Sage (Upper)							
Salt Sage (Middle)							
Salt Sage (Lower)							
Maxon							
Little Lime							
Pencil Cave							
Big Lime							
Keener Sand							
Injun Sand							
Squaw Sand							
Wair Sand							
Berea Sand							
Gantz Sand							
Fifty Foot Sand							
Thirty Foot Sand							
Gordon Stray							
Gordon Sand							
Fourth Sand							
Fifth Sand							
Corniferous Lime							
Niagara Lime							
Cave							
Clinton							
Medina Chale							
Trenton							
Total Depth							

Remarks
 PACKERS
 Size Make Set At