
WW-7 8-30-06



## West Virginia Department of Environmental Protection Office of Oil and Gas

## **WELL LOCATION FORM: GPS**

API: 47-095-00557 WELL NO.:	5
FARM NAME: GRAY, E. R. (EDDY, JAMES)	
RESPONSIBLE PARTY NAME: Triad Hunter, LLC	
COUNTY: TYLER DISTRICT: E	LLSWORTH
QUADRANGLE: Porters Falls	
SURFACE OWNER: DANIEL R DEETZ	
ROYALTY OWNER: Unknown	
UTM GPS NORTHING: 4374908.4000	
UTM GPS EASTING: 511328.8000 GPS ELEVA	<sub>TION:</sub> 1271
The Responsible Party named above has chosen to submit GPS coordinates in lieu of preparing a new well location plat for a plugging permit or assigned API number on the above well. The Office of Oil and Gas will not accept GPS coordinates that do not meet the following requirements:  1. Datum: NAD 1983, Zone: 17 North, Coordinate Units: meters, Altitude: height above mean sea level (MSL) – meters.  2. Accuracy to Datum – 3.05 meters  3. Data Collection Method: Survey grade GPS × : Post Processed Differential	
Real-Time Differential X	
Mapping Grade GPS: Post Processed Differential  Real-Time Differential	
4. Letter size copy of the topography map showing the well location.  I the undersigned, hereby certify this data is correct to the best of my knowledge and belief and shows all the information required by law and the regulations issued and prescribed by the Office of Oil and Gas.  Operations Manager  Office of Oil and Gas  FEB - 8 2019  Environmental Protection	
Signature Title	Date

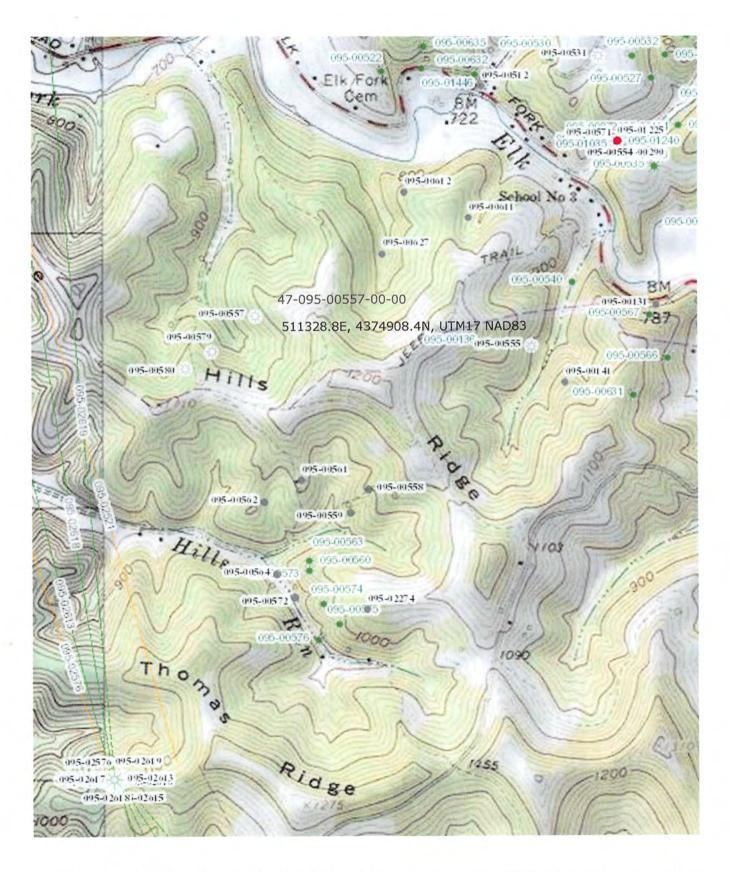

 $http://deparcgis1/ooggis/index.html?x = 511328.8 \& y = 4374908.4 \& datum = NAD83 \& pntlabe... \quad 4/17/2019 = 4/17/2019 + 4/17/2019 = 4/17/2019 + 4/17/2019 = 4/17/2019 + 4/17/2019 = 4/17/2019 + 4/17/2019 = 4/17$