

WW-7
8-30-06



West Virginia Department of Environmental Protection
Office of Oil and Gas

WELL LOCATION FORM: GPS

API: 47-095-00558 WELL NO.: 4
 FARM NAME: FERRELL, J. F.
 RESPONSIBLE PARTY NAME: Triad Hunter, LLC
 COUNTY: TYLER DISTRICT: ELLSWORTH
 QUADRANGLE: Porters Falls
 SURFACE OWNER: James S & Goldie Matthews EST
 ROYALTY OWNER: Unknown
 UTM GPS NORTHING: 4374273.2908
 UTM GPS EASTING: 511743.4212 GPS ELEVATION: 983

The Responsible Party named above has chosen to submit GPS coordinates in lieu of preparing a new well location plat for a plugging permit or assigned API number on the above well. The Office of Oil and Gas will not accept GPS coordinates that do not meet the following requirements:

1. Datum: NAD 1983, Zone: 17 North, Coordinate Units: meters, Altitude: height above mean sea level (MSL) – meters.
2. Accuracy to Datum – 3.05 meters
3. Data Collection Method:

Survey grade GPS : Post Processed Differential _____

Real-Time Differential _____

Mapping Grade GPS _____ : Post Processed Differential _____

Real-Time Differential _____

4. **Letter size copy of the topography map showing the well location.**

I the undersigned, hereby certify this data is correct to the best of my knowledge and belief and shows all the information required by law and the regulations issued and prescribed by the Office of Oil and Gas.

Signature *Mark Hancock*

Operations Manager


Title

2/5/19
Date

RECEIVED
Office of Oil and Gas
FEB - 8 2019

WV Department of
Environmental Protection

04/05/2019

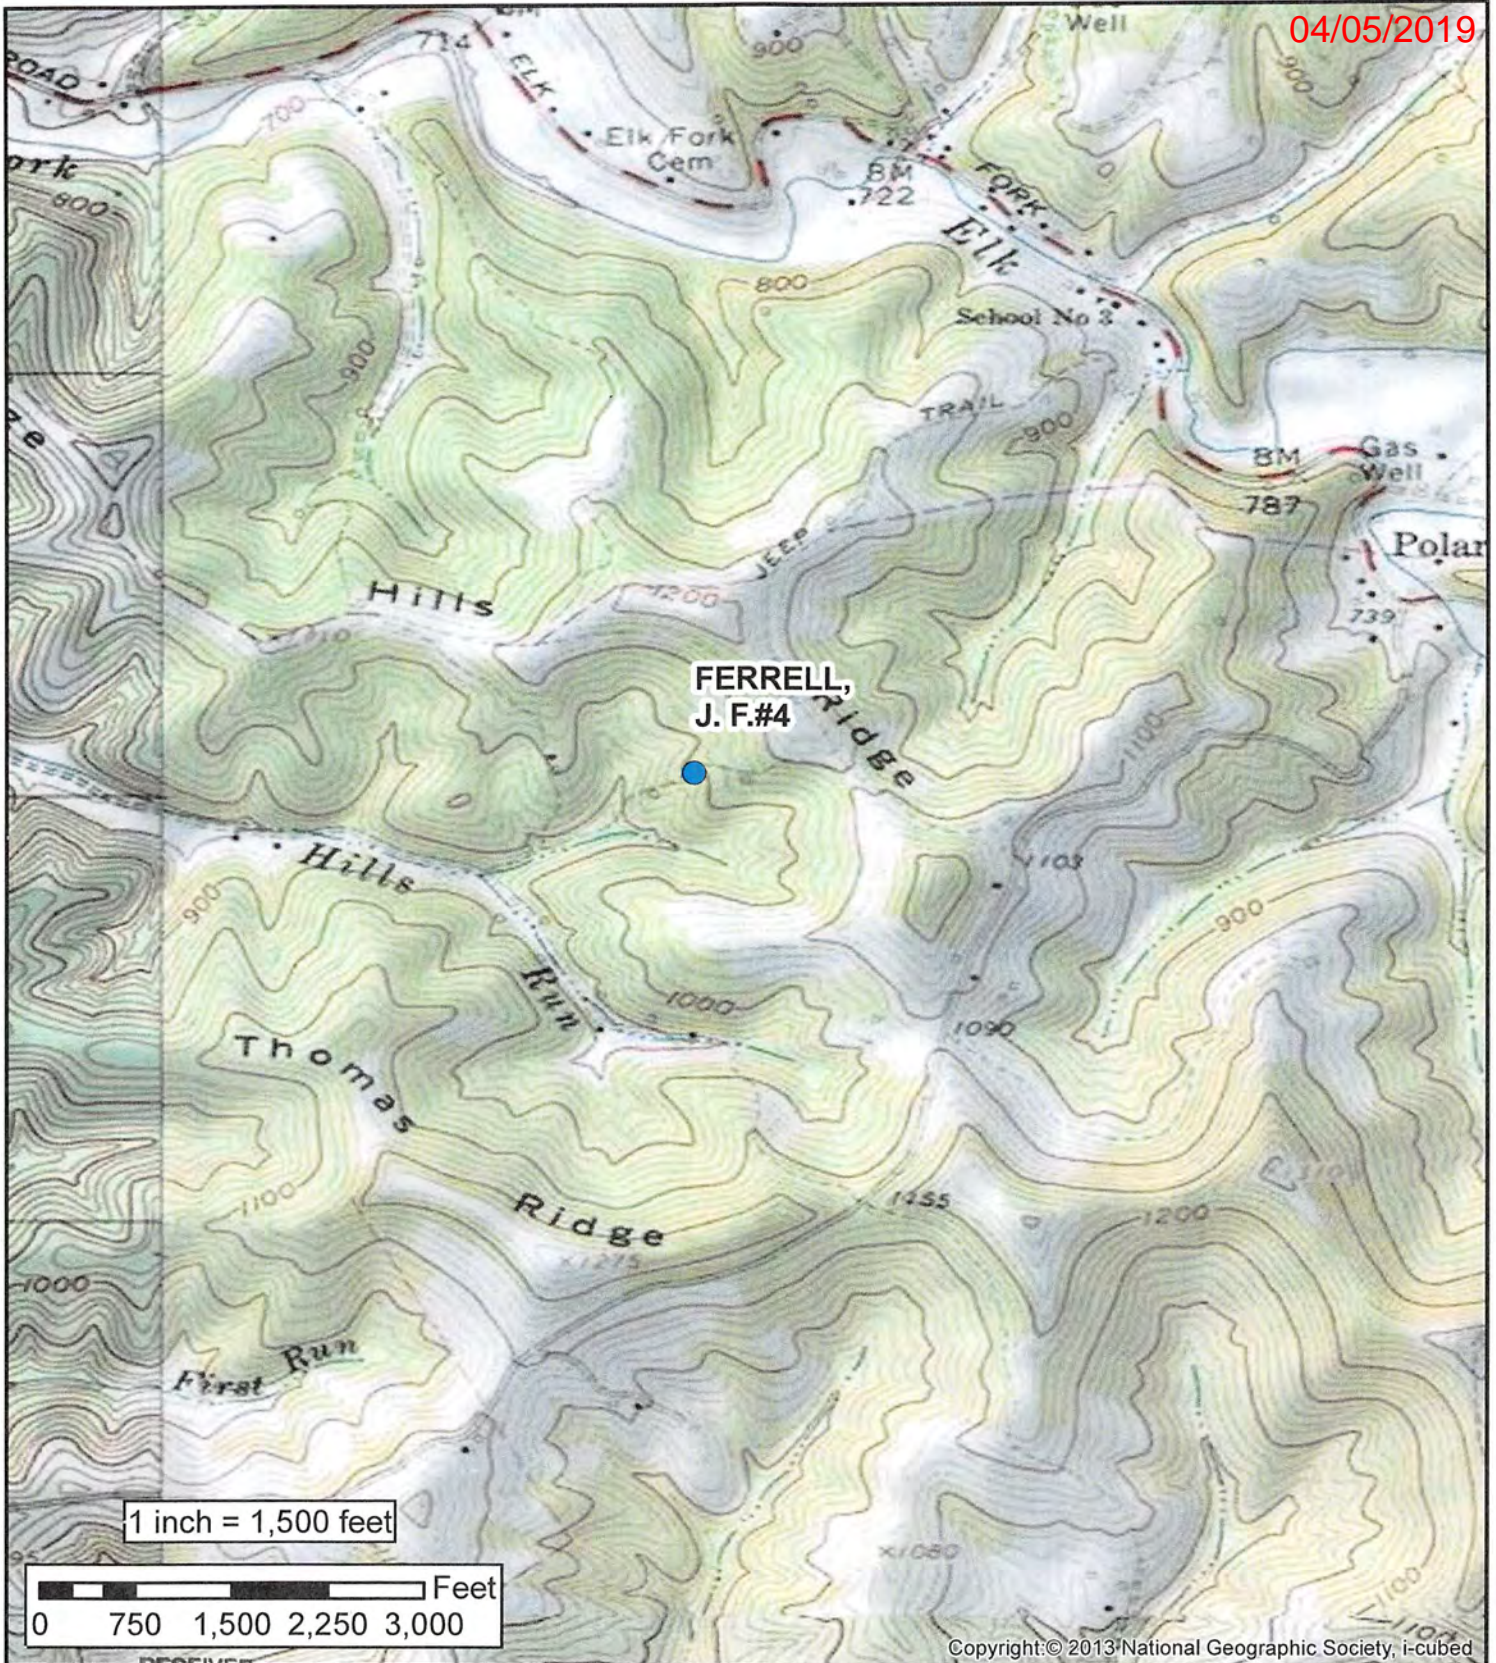

Copyright © 2013 National Geographic Society, i-cubed

RECEIVED
Office of Oil and Gas

APR 02 2019

Well Name: Ferrell, J.F. #4

WV Department of
Environmental Protection

Triad Hunter, LLC
A subsidiary of Blue Ridge Mountain Resources, Inc.

Tyler County - Ellsworth District - West Virginia